



Expires 06/30/2025



## LAKE HAVASU CITY, ARIZONA ADDENDUM NO. 4

Horizontal Collector Well Redevelopment Project  
Project B24-PW-108030-500434

**DATED: DECEMBER 21, 2023**

This Addendum No. 1 forms a part of the contract described above.

The following questions were received from bidders. The answers are provided herein by the OWNER:

1. **Question:** *Is there a pre-bid site meeting scheduled?*

**Answer:** A pre-bid meeting is not scheduled for this project.

2. **Question:** *Can the bid date be pushed to the middle of January?*

**Answer:** Due to the urgency of completing the work as soon as possible, the bid date cannot be delayed.

3. **Question:** *Can the time of completion day be extended to end of July 2024?*

**Answer:** The well must be operational with one pump equivalent to those currently in the well by May 1. Well cleaning and other work may occur after this date but the well may be placed into service as a backup water supply at any time and the Contractor must maintain the well to be in operable condition within 8 hours of receiving written notice by the City.

4. **Question:** *Can you provide detailed information for materials and construction on the pumping units?*

**Answer:** Materials and construction of the pumping units are to be proposed by the Contractor based on supplier availability. Standard construction using cast iron bowls and bronze impellers would be found acceptable.

5. **Question:** *Is there factory testing on the pumps?*

**Answer:** Factory testing is not a specified requirement.

6. **Question:** *What size is the column pipe?*

**Answer:** Column pipe size is to be proposed by the Contractor based on supplier availability. Column pipe size for the 4,000 gpm pump of 16-inch would be found acceptable. Column size for the 6,000 gpm pump of 20-inch would be found acceptable. Other sizes that are more readily available would be considered.

7. **Question:** *What size are the discharge heads?*

**Answer:** The as-built drawings for the Horizontal Collector Well are attached.

8. **Question:** *Is there a spec. on the new motors?*

**Answer:** The motors are to be proposed by the Contractor based on supplier availability. Standard vertical motors sized to the required horsepower of the pump without exceeding the motor nameplate horsepower or using the motor service factor would be acceptable.

9. **Question:** *Can more detailed drawing be provided?*

**Answer:** The as-built drawings for the Horizontal Collector Well are attached.

10. **Question:** *Part 2.0 of Section 00700 discusses the timing of the Notice to Proceed in relation to the Notice of Award for this project. In light of the bid date of January 2<sup>nd</sup> as well as the expedited work schedule, approximately when does the City anticipate the Notice of Award and Notice to Proceed will be issued?*

**Answer:** The City anticipates issuing the Notice of Award January 10, 2024. The hope is that the contract can be processed and signed by all in less than a week so the NTP can be issued January 15, 2024.

11. **Question:** *Part 17.3 of Section 00700 specifies that the Contractor shall only work an (8) hour day consisting of Monday through Friday. Due to the expedited schedule and anticipated scope of work, can this work schedule be amended to allow extended work hours as well as weekend work?*

**Answer:** The City recognizes that the area work site is in a non-residential area and with the knowledge that this is a high priority project with hard deadlines would allow extended work hours and weekend work as needed.

12. **Question:** *Part 9.0.B of Section 00800 states that all power required for completion of the work shall be provided by the Contractor at his expense, yet Part 3.01.B of Section 33 21 13.7 states that electric power is available at the collector well for the Contractor's use. Please clarify if power is available for use by the Contractor on this project and, if so, please provide the voltage and phase of the available power.*

**Answer:** Onsite power is available at the site for Contractor use within the existing Motor Control Center (MCC). The Contractor may utilize this power with a temporary connection to the MCC. Temporary power connections shall be in strict conformance with all applicable electrical codes, City standards, and good electrical practice. The existing MCC powers three 400 hp electric motors with 480 volt, 3-phase power. The as-built drawings for the Collector Well, including power diagrams are attached.

13. **Question:** *Parts 3.10 and 3.14 of Section 33 21 13.7 require the collector well to be pumped for durations of 5 hours and 32 hours during pre and post-maintenance testing at rates of up to 5000 gpm. Is this test water to be pumped into the discharge area shown on Drawing G-1 of the project plans or can this test water be pumped to an alternate location designated by the City and better designed to accept this anticipated volume of water?*

**Answer:** As specified, the discharge point is shown on the Drawings. Bidders shall prepare their bids to discharge water as specified. The successful Bidder may propose an alternative point of discharge following Award providing it is acceptable to the City, meets all specified discharge criteria, and complies with all Federal, State, and local regulations, codes, and requirements.



**LAKE HAVASU CITY - ARIZONA**  
**LONDON BRIDGE BEACH PUMP HOUSE**  
**PROJECT NO. W-183-00**

**Contract Drawings**

**2000**


**97-777-1-002**

APPROVED: \_\_\_\_\_  
CITY ENGINEER DATE

*Robert Schulz*  
ROBERT SCHULZ, P.E.  
BURNS & McDONNELL ENGINEERING CO., INC.  
(602) 385-4500





**"AS-BUILT"**

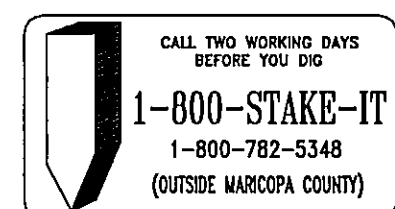


# Lake Havasu City, Arizona

## LONDON BRIDGE BEACH PUMP HOUSE

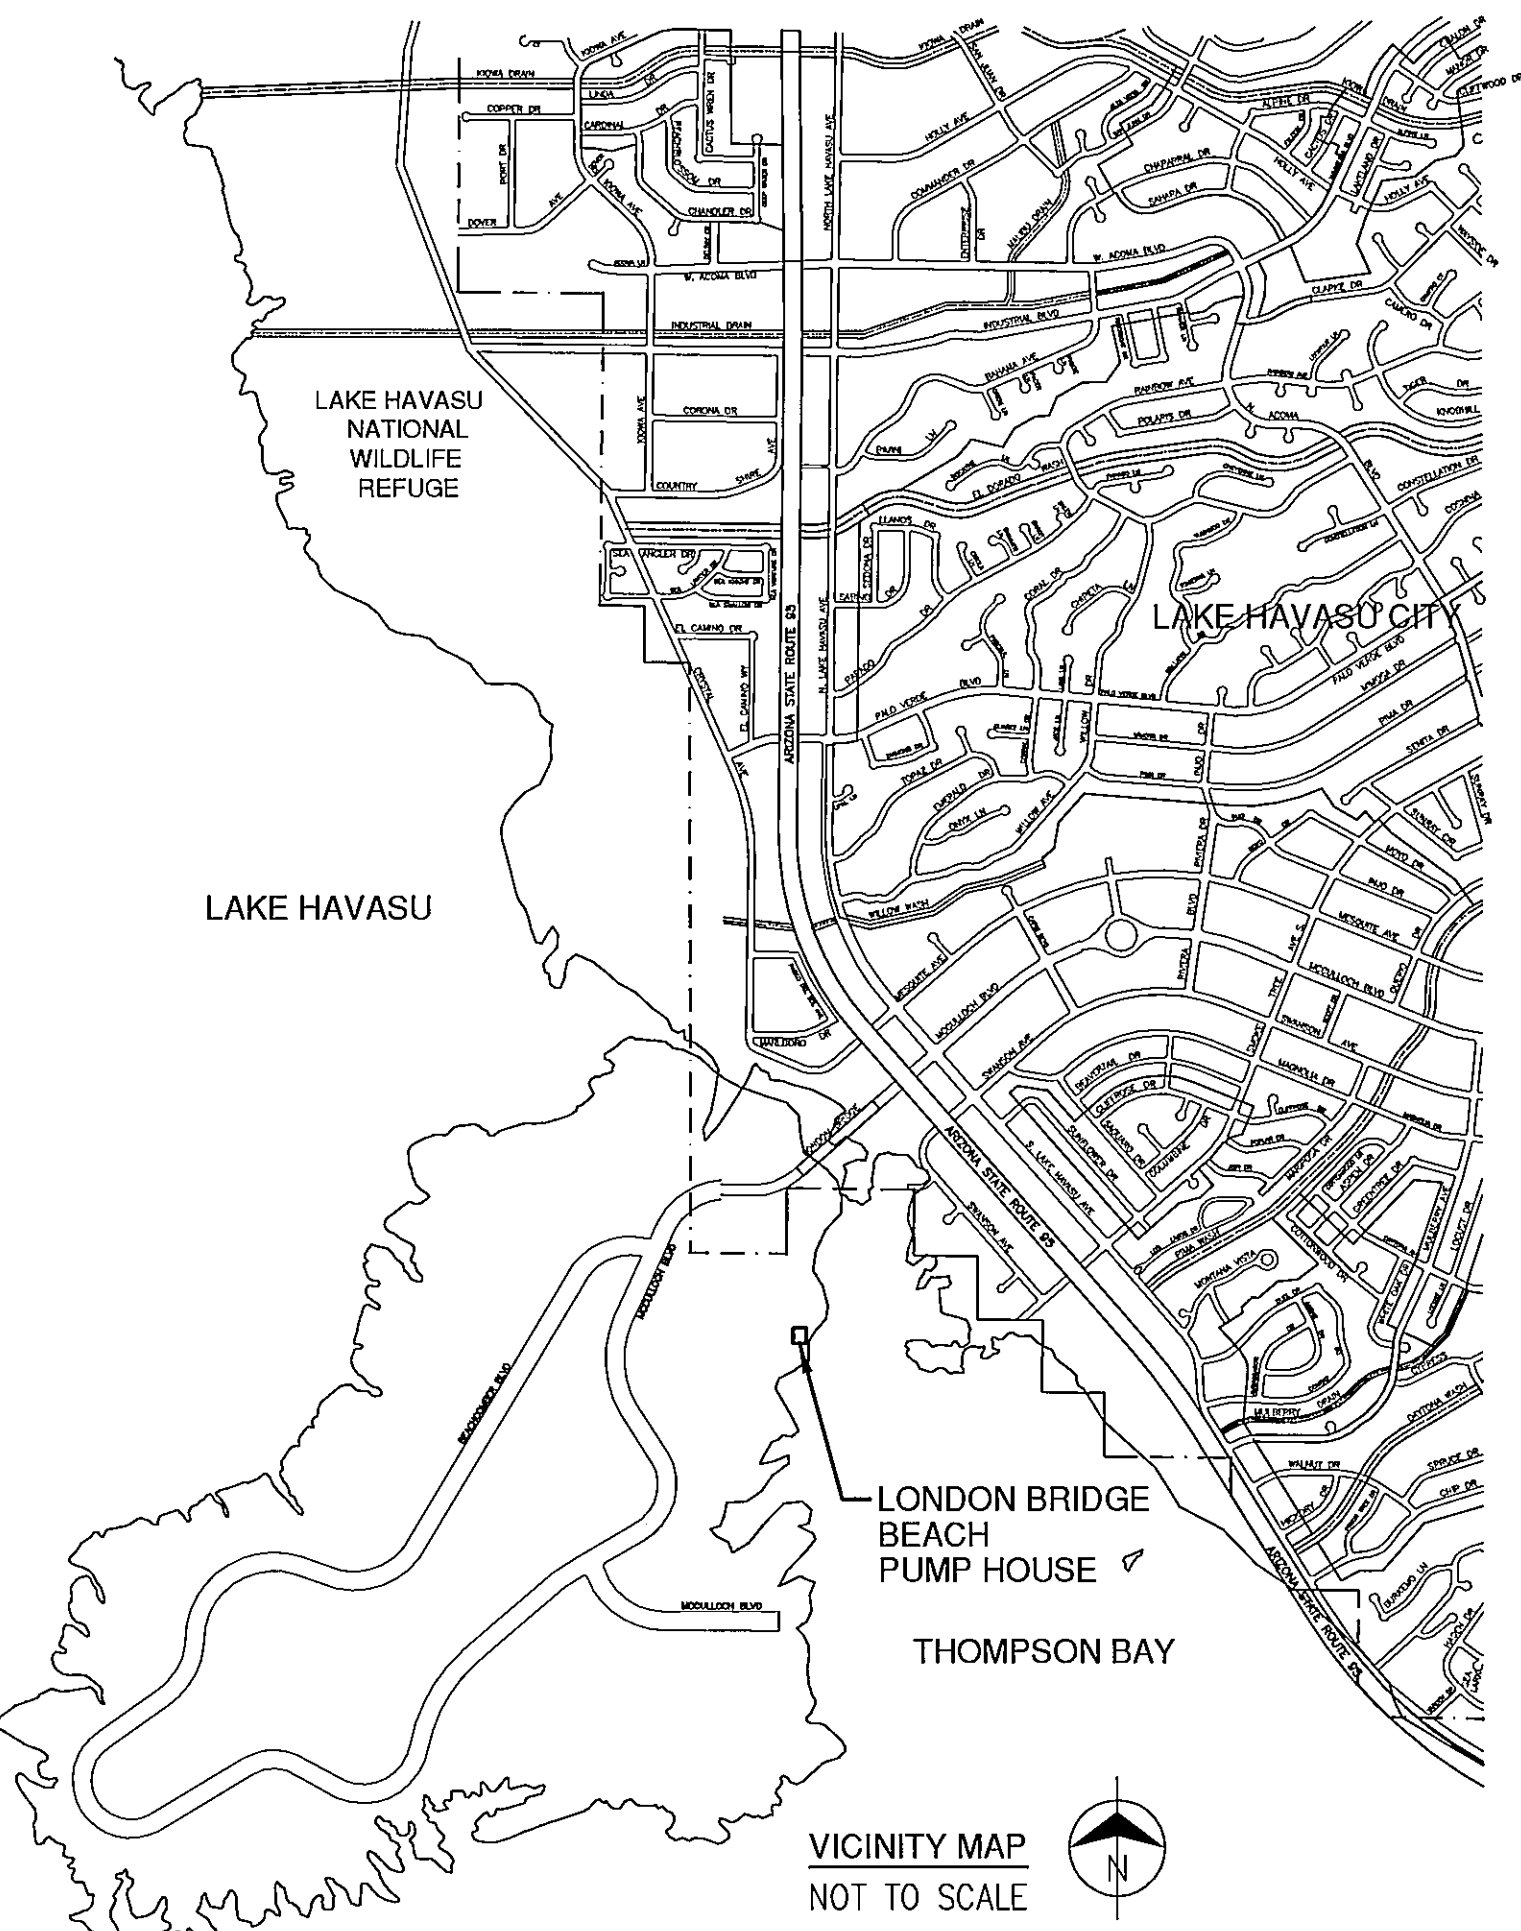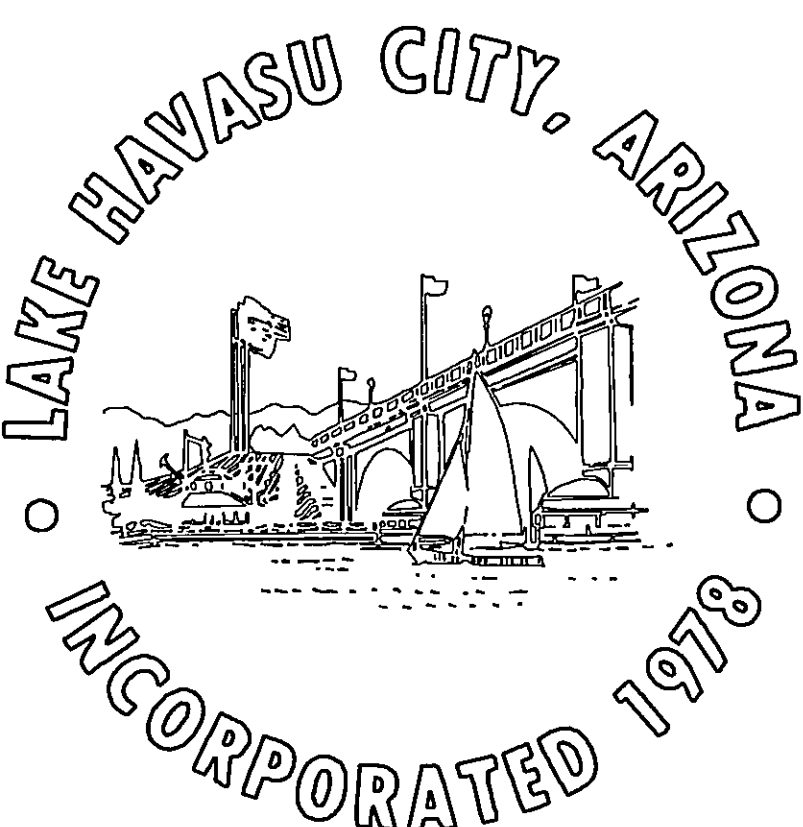

“AS-BUILT”

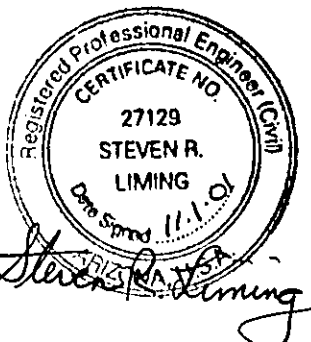


London Bridge Beach  
Pump House  
PROJECT NO: W-183-00


# INDEX

### List of Contract Drawings

DRAWING NO.	TITLE
	COVER
	INDEX
C1	SITE PLAN AND DETAILS
C2	EQUIPMENT LAYOUT
A1	SCREEN WALL – PLAN, ELEVATION AND DETAILS
S1	STRUCTURAL LEGEND
S2	FOUNDATION PLAN AND DETAILS
S3	ROOF PLAN AND DETAILS
S4	DETAILS AND SECTIONS
P1	PROCESS LEGEND
P2	PARTIAL PLAN AND DETAILS
P3	SECTIONS AND DETAILS
M1	MECHANICAL LEGEND
M2	HVAC AND PLUMBING FLOOR PLAN AND
M3	HVAC CONTROL SEQUENCE OF OPERATION DIAGRAMS
	MISCELLANEOUS DETAILS AND SCHEDULES
E1	ELECTRICAL LEGEND
E2	ELECTRICAL ONE-LINE DIAGRAM
E3	ELECTRICAL POWER PLAN
E4	ELECTRICAL LIGHTING, SAMLL. POWER AND CONTROL PLAN
E5	PUMP CONTROL DIAGRAMS NO. 1
E6	PUMP CONTROL DIAGRAMS NO. 2
E7	PLC I/O WIRING DIAGRAMS AND MISC. DETAILS

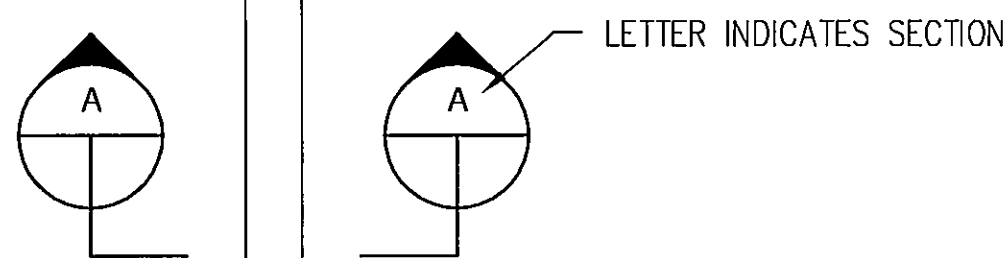


SECTION CUT AND DRAWN ON SAME DRAWING.

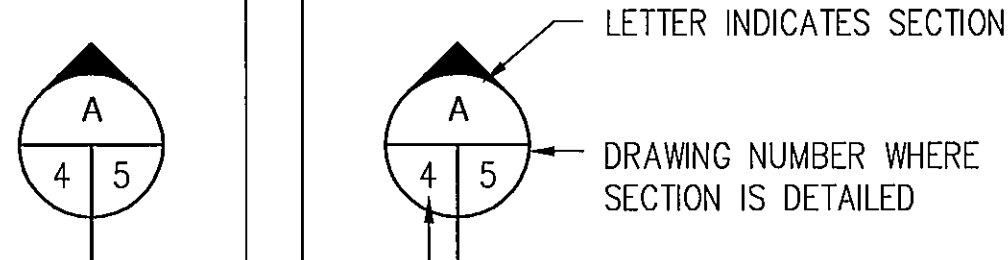

DRAWING NUMBER WHERE SECTION IS CUT


SECTION CUT ON ONE DRAWING AND DRAWN ON ANOTHER DRAWING WITHIN THE SAME DISCIPLINE.

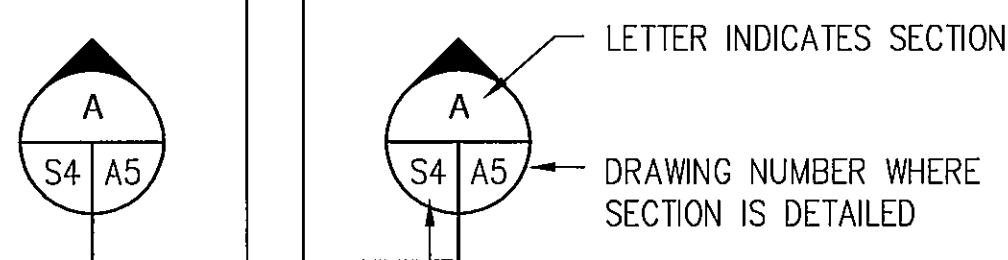


DRAWING NUMBER WHERE SECTION IS CUT

SECTION CUT ON DRAWING OF ONE DISCIPLINE AND DETAILED ON DRAWING OF ANOTHER DISCIPLINE.

#### SECTION IDENTIFICATION

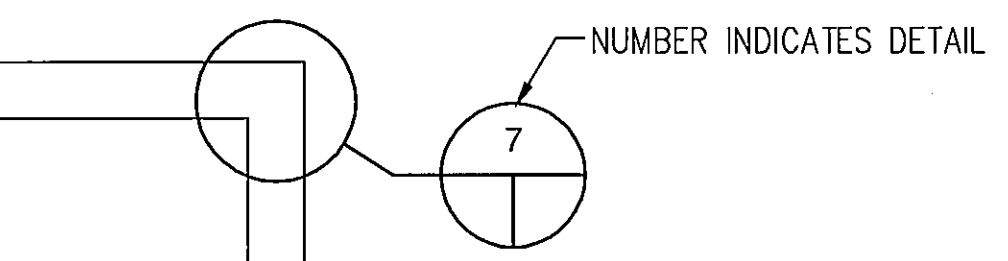


DETAIL TAKEN AND DRAWN ON SAME DRAWING.

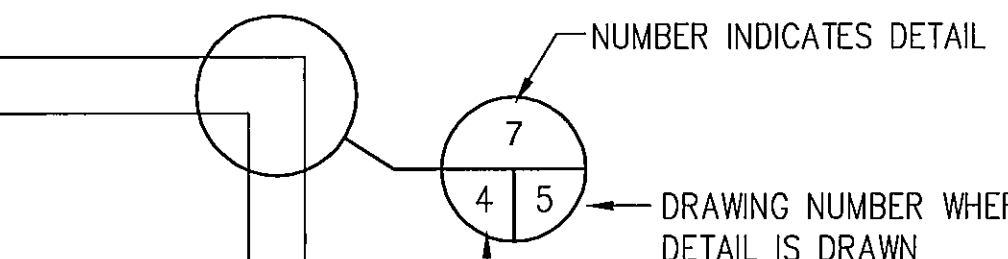

DRAWING NUMBER WHERE DETAIL IS TAKEN

DETAIL TAKEN ON ONE DRAWING AND DETAILED ON ANOTHER DRAWING WITHIN THE SAME DISCIPLINE.

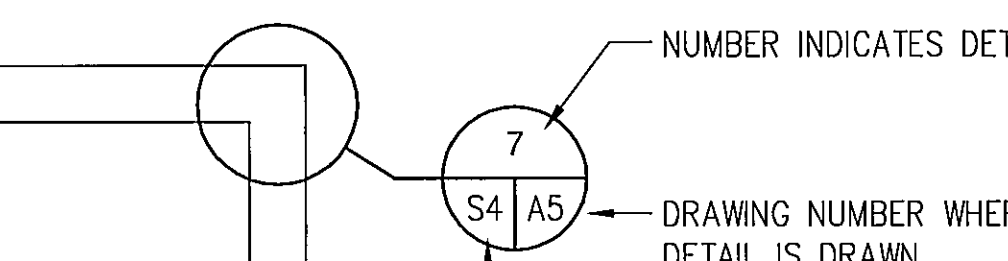

DRAWING NUMBER WHERE DETAIL IS TAKEN


DETAIL TAKEN ON DRAWING OF ONE DISCIPLINE AND DETAILED ON DRAWING OF ANOTHER DISCIPLINE.

#### DETAIL IDENTIFICATION

#### SECTION AND DETAIL IDENTIFICATION SYSTEMS





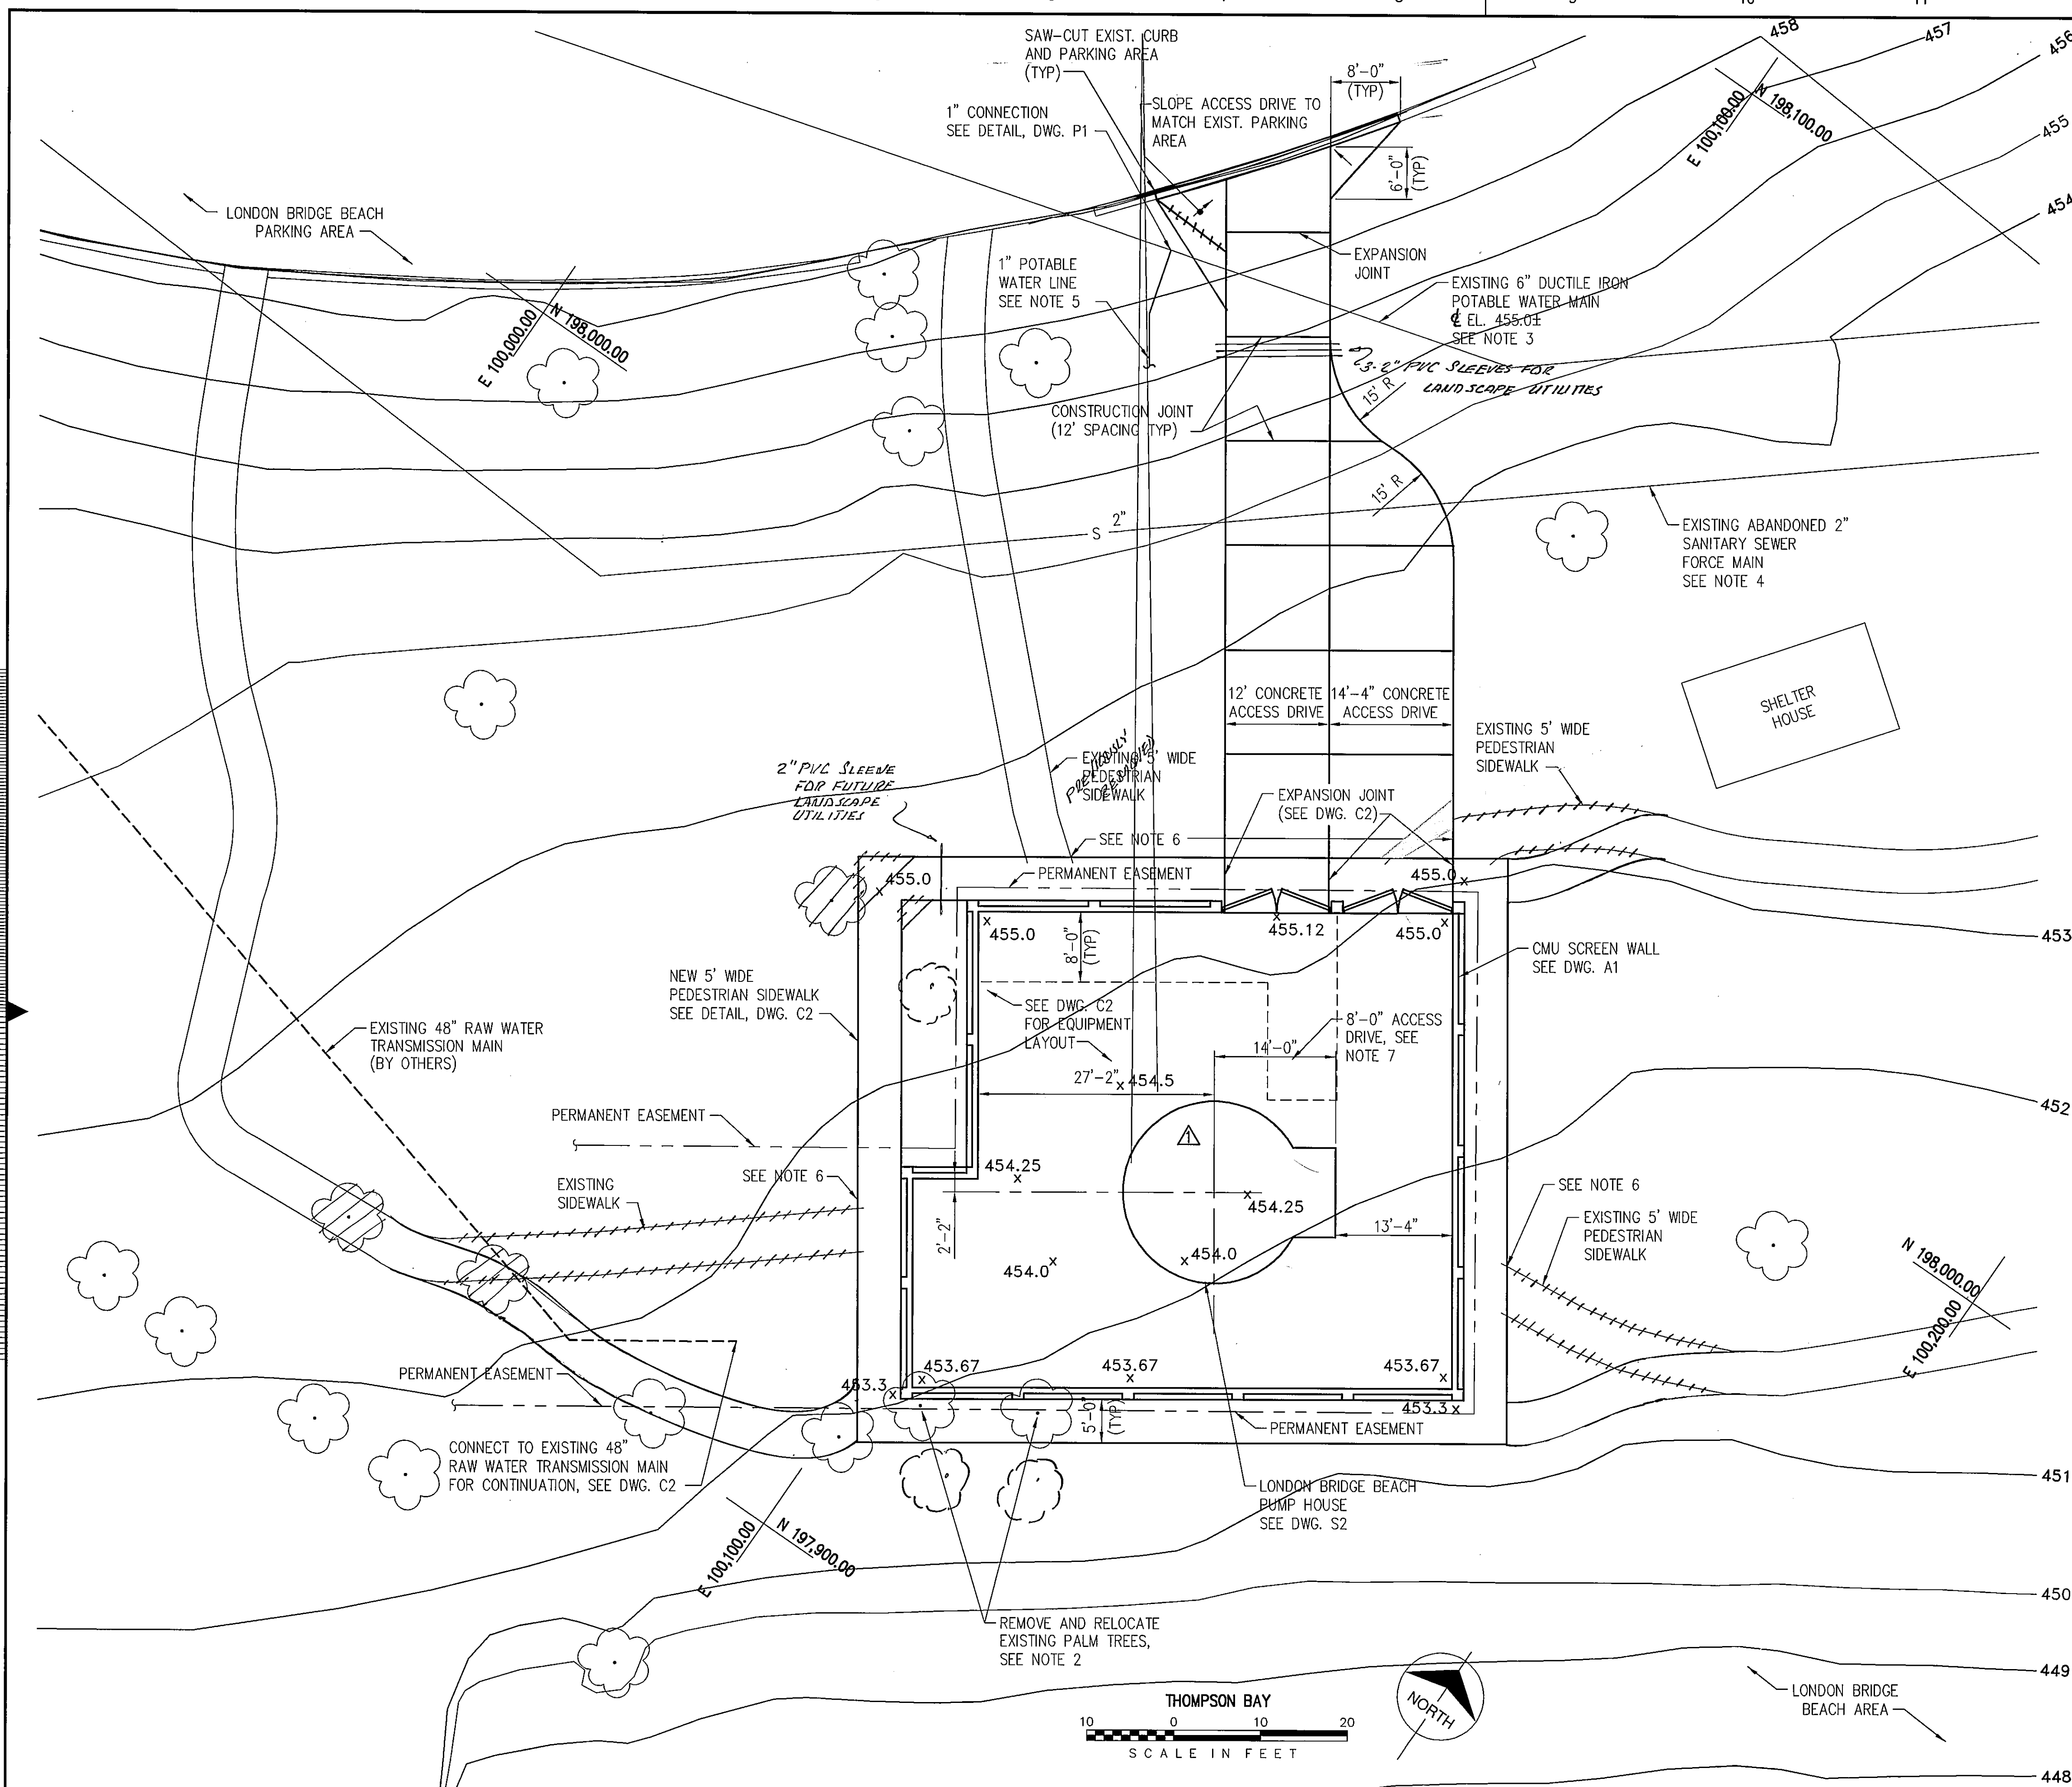

# GENERAL NOTES:

- ALL EXISTING UTILITY LOCATIONS ARE APPROXIMATE. CONTRACTOR SHALL VERIFY THE ACTUAL LOCATION OF ALL UTILITIES WITH THEIR RESPECTIVE OWNERS AS REQUIRED PRIOR TO BEGINNING WORK TO PREVENT DAMAGE BY CONTRACTOR'S OPERATION.
- IN ACCORDANCE WITH ARIZONA ADMINISTRATIVE CODE, SUPP. 99-2, SECTION R18-4-502, SUBSECTION 1, C.1., EXTRA PROTECTION CONSISTING OF MINIMUM OF 6" CONCRETE ENCASMENT SHALL BE PROVIDED FOR BOTH GRAVITY SEWER LINES AND THE 48-INCH RAW WATER LINE OR ANY OTHER POTABLE WATER LINES INSTALLED UNDER THIS CONTRACT WHERE A MINIMUM OF 2-FOOT VERTICAL SEPARATION AND 6-FOOT HORIZONTAL SEPARATION CAN NOT BE MAINTAINED BETWEEN THE TWO LINES. ENCASMENT SHALL EXTEND AT LEAST 10-FOET BEYOND THE AREA COVERED BY THIS SUBSECTION. IN ACCORDANCE WITH A.A.C., SUPP. 99-2, SECTION R18-4-502, SUBSECTION C.3., WHERE A SEWER FORCE MAIN CROSSES ABOVE OR LESS THAN 6-FOET BELOW THE 48-INCH WATER LINE, OR ANY OTHER POTABLE WATER LIES INSTALLED UNDER THIS CONTRACT, THE SEWER FORCE MAIN SHALL BE ENCASED IN A MINIMUM OF 6-INCHES OF CONCRETE FOR 10-FOET EITHER SIDE OF THE WATER MAIN.
- ALL ELEVATIONS ARE LAKE HAVASU CITY DATUM.
- CONTRACTOR SHALL LIMIT HIS WORK AREA TO PERMANENT EASEMENTS AND TEMPORARY EASEMENTS AS SHOWN FOR CONSTRUCTION OF WATER MAIN. NO ADDITIONAL TEMPORARY CONSTRUCTION EASEMENT EXISTS UNLESS OTHERWISE NOTED.
- CONTRACTOR SHALL TAKE ALL APPROPRIATE STEPS TO MAINTAIN CONTINUAL SERVICE OF UTILITIES. CONTRACTOR SHALL PROVIDE SUPPORT AND PROTECTION OF ALL UTILITY LINES TO PREVENT UNDERMINING OR DAMAGING OF THE UTILITY LINES DURING CONSTRUCTION. METHOD OF CROSSING AND/OR SUPPORT OF UTILITIES SHALL BE APPROVED BY UTILITY OWNER. SUPPORT OF UTILITY LINES, POWER POLES, FENCES, HIGHWAY SIGNS OR OTHER UTILITY SIGNS SHALL BE CONSIDERED AS SUBSIDIARY TO PIPELINE INSTALLATION.
- CONTRACTOR SHALL IMPROVE ACCESS AS REQUIRED TO FACILITATE HIS OPERATIONS AT NO ADDITIONAL COST TO THE OWNER.
- CONTRACTOR SHALL SHADE AND SURFACE AS SPECIFIED ALL AREAS DISTURBED BY CONSTRUCTION UNLESS INDICATED OR SPECIFIED OTHERWISE.
- CONTRACTOR SHALL PROVIDE CONTINUOUS PROTECTION AGAINST ENTRANCE OF FLOOD WATER INTO THE ENDS OF ALL BORINGS, BORE PITS AND INSTALLED PIPE.
- REMOVE FENCE, SIDEWALKS, ASPHALT AND CONCRETE ROADS AND DRIVEWAYS, DRIVEWAYS, CURB AND CUTTER, ROCK RIP RAP, CMP'S AND ASSOCIATED APPURTENANCES AS REQUIRED FOR CONSTRUCTION PURPOSES. RESTORE ALL REMOVED OR DAMAGED ITEMS TO CONDITION EQUAL TO OR BETTER THAN CONDITION BEFORE START OF WORK.
- CONTRACTOR SHALL TAKE APPROPRIATE STEPS TO PREVENT EROSION OF EARTHWORK AND DEPOSITION OF SEDIMENTS INTO WATER COURSES OR DRAINAGE SWALES.
- MAPPING AND GPS SERVICES PERFORMED BY:  
NORTHWEST SURVEYING, INC.  
53 MULBERRY AVENUE  
LAKE HAVASU CITY, AZ 86403  
DATED: OCTOBER, 1997  
PROJECT NO. PW-113-96  
ORIGINAL DOCUMENT BOOK ON FILE AT THE LAKE HAVASU CITY CITY ENGINEER'S OFFICE.
- AERIAL PHOTOGRAPHY PERFORMED BY:  
COOPER AERIAL SURVEYING CO.  
1692 W. GRANT ROAD  
TUCSON, AZ 85745



## DRAWING C1 NOTES:


- THE LOCATION OF ALL TREES, PEDESTRIAN SIDEWALKS AND OTHER LANDSCAPE FEATURES ARE APPROXIMATE. CONTRACTOR SHALL FIELD VERIFY THE LOCATION OF ALL EXISTING LANDSCAPE ITEMS PRIOR TO PROCEEDING WITH THE WORK.
- EXCEPT AS NOTED, ALL TREES ARE DESIGNATED TO REMAIN. SHOULD THE NATURE OF THE WORK REQUIRE TREE REMOVAL OR RELOCATION, CONTACT FIELD REPRESENTATIVE PRIOR TO REMOVAL/RELOCATION OF SAID TREE.
- THIS DRAWING GENERAL NOTE NO. 8.
- EXISTING ABANDONED 2" SANITARY SEWER FORCE MAIN WITH CENTERLINE ELEVATION 454.5± HAS BEEN RELOCATED BY OWNER. CONTRACTOR SHALL FIELD VERIFY LOCATION OF 2" SANITARY SEWER FORCE MAIN PRIOR TO PROCEEDING WITH THE WORK.
- FIELD ROUTE 1" POTABLE WATER LINE FROM 6" WATER MAIN TO LOCATION INDICATED ON DRAWING C2. PROVIDE 2" SANITARY CROSSING (IF REQUIRED) IN ACCORDANCE WITH NOTES 3 AND 8 ON DRAWING P1.
- TIE NEW 5'-0" PERIMETER PEDESTRIAN SIDEWALK INTO THE EXISTING SIDEWALK AT NEAREST JOINT OF EXISTING SIDEWALK. SEE DETAIL, DWG C2.
- MAINTAIN 8'-0" WIDE CLEARANCE FOR ACCESS TO BASE OF CONCRETE PAD FOR MCC WALK-IN STRUCTURE AS SHOWN ON DRAWING C2.
- FOR SAKE OF CLARITY, PIPING, EQUIPMENT AND HORIZONTAL COLLECTOR WELL LATERALS ARE NOT SHOWN.
- CONTRACTOR SHALL FINISH GRADE AREAS DISTURBED DURING CONSTRUCTION. LAKE HAVASU CITY PARK DEPARTMENT WILL COMPLETE LANDSCAPING AFTER CONTRACTOR COMPLETES CONSTRUCTION.

## LEGEND

- 450 EXISTING CONTOUR
- EXISTING TREE
- 453.67 FINISHED GRADE


## "AS-BUILT"

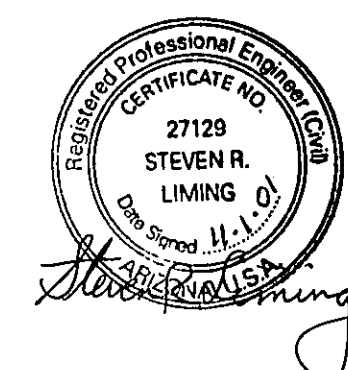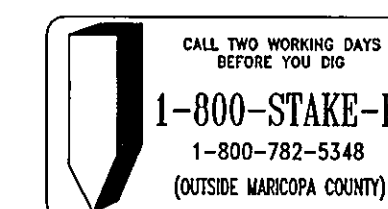

no.	date	by	revision
	7-27-01	JJM	(6-G) REVISE DRAWING TO ACCOMMODATE COLLECTOR WELL "AS BUILT"
	8-15-01	JDF	As-BUILT





date	DEC. 7, 1999	detailed	G. PORTER
designed	T. CROWLEY	checked	JLS

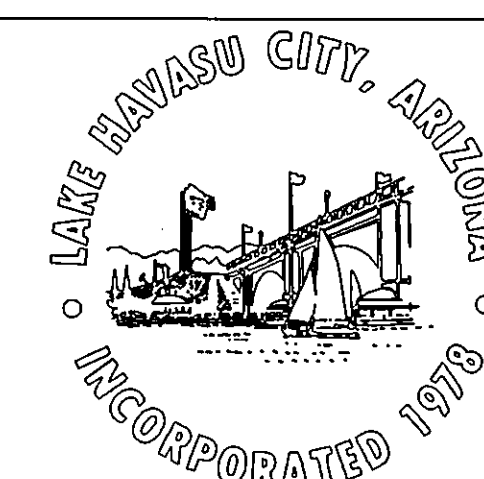

LONDON BRIDGE BEACH PUMP HOUSE	
SITE PLAN AND DETAILS	
project	97-777-1-002
contract	W-183-00
drawing	C1
rev.	1
sheet	2 of 21 sheets
file	Lbbphc01.dwg 06-14-2000 08:53 LJM


NOTES:

- FOR SAKE OF CLARITY EXISTING HORIZONTAL COLLECTOR WELL LATERALS ARE NOT SHOWN.
- PROVIDE CONCRETE PAD FOR TRANSFORMER. COORDINATE WITH CITIZENS UTILITIES REGARDING REQUIRED THICKNESS AND DIMENSIONS FOR EQUIPMENT PAD. TOP OF CONCRETE (TOC) ELEVATION SHALL BE 454.75.
- ALL EXISTING UTILITY LOCATIONS ARE APPROXIMATE. CONTRACTOR SHALL FIELD VERIFY THE ACTUAL LOCATION OF ALL UTILITIES WITH THEIR RESPECTIVE OWNERS AS REQUIRED PRIOR TO BEGINNING WORK. MAINTAINING THE MAXIMUM SEPARATION DISTANCE POSSIBLE BETWEEN SEWER LINES AND THE PROPOSED WATER MAIN SHALL TAKE PRECEDENCE OVER THE SEPARATION DISTANCE BETWEEN THE PROPOSED WATER MAIN AND ALL OTHER UNITS.
- REMOVE EXISTING 48" HARNESSSED MECHANICAL JOINT PLUG AND CONNECT NEW 48" RAW WATER DIP MAIN FROM HORIZONTAL COLLECTOR WELL AS SHOWN ON THE PIPE CONNECTION DETAIL ON DWG. P1.
- SEE WATER SUPPLY AT METER LOCATION BACKFLOW PREVENTER INSTALLATION DETAIL ON DWG. M3.
- AIR CONDITIONING UNIT FOUNDATION SLAB:
  - TOP OF CONCRETE ELEVATION 455'-0"
  - PLAN DIMENSIONS (CONTRACTOR TO VERIFY WITH EQUIPMENT) 6'-8" x 18'-6"
  - SLAB THICKNESS 1'-0". *DIMENSION- 9'-0" x 20'-0"*
  - REINFORCING:
    - #4@10" EW, TOP W/2" CLEAR COVER.
    - #4@10" EW, BOTTOM W/3" CLEAR COVER.
- EMERGENCY GENERATOR FOUNDATION SLAB:
  - TOP OF CONCRETE ELEVATION 455'-0"
  - PLAN DIMENSIONS (CONTRACTOR TO VERIFY W/ EQUIPMENT.) 10'-8" x 25'-8"
  - SLAB THICKNESS 1'-3". *DIMENSION- 8'-0" x 20'-8"*
  - REINFORCING:
    - #5@12" EW, TOP W/ 2" CLEAR COVER.
    - #5@12" EW, BOTTOM W/ 3" CLEAR COVER.
- WALK-IN MCC STRUCTURE FOUNDATION SLAB:
  - TOP OF CONCRETE ELEVATION 454'-0". *452'-4"*
  - PLAN DIMENSIONS (CONTRACTOR TO VERIFY W/ EQUIPMENT) 10'-4" x 28'-8"
  - SLAB THICKNESS 1'-0". *DIMENSION- 10'-2" x 31'-0"*
  - REINFORCING:
    - #4@10" EW, TOP W/ 2" CLEAR COVER.
    - #4@10" EW, BOTTOM W/3" CLEAR COVER.
- PROVIDE CHAIN LINK FENCE. TOP OF FABRIC SHALL BE 7'-0" ABOVE GRADE. TOP OF POSTS SHALL BE MAX. HEIGHT OF 7'-4" ABOVE GRADE.

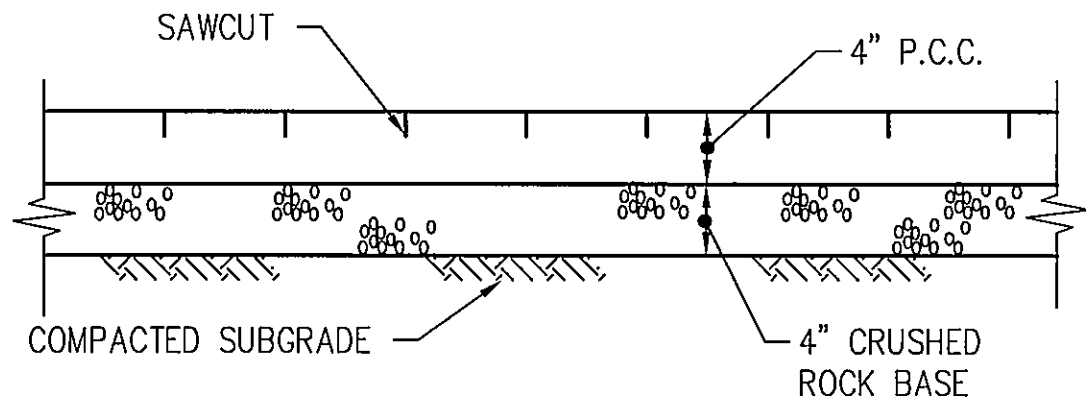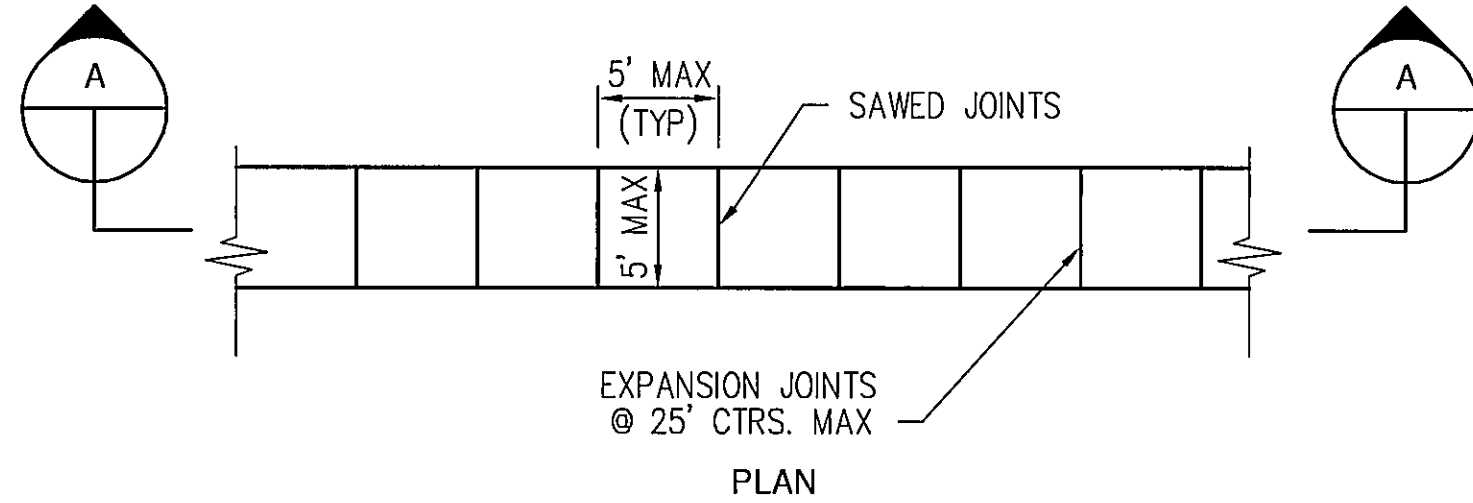

SECTION

TYPICAL SIDEWALK DETAIL  
NOT TO SCALE

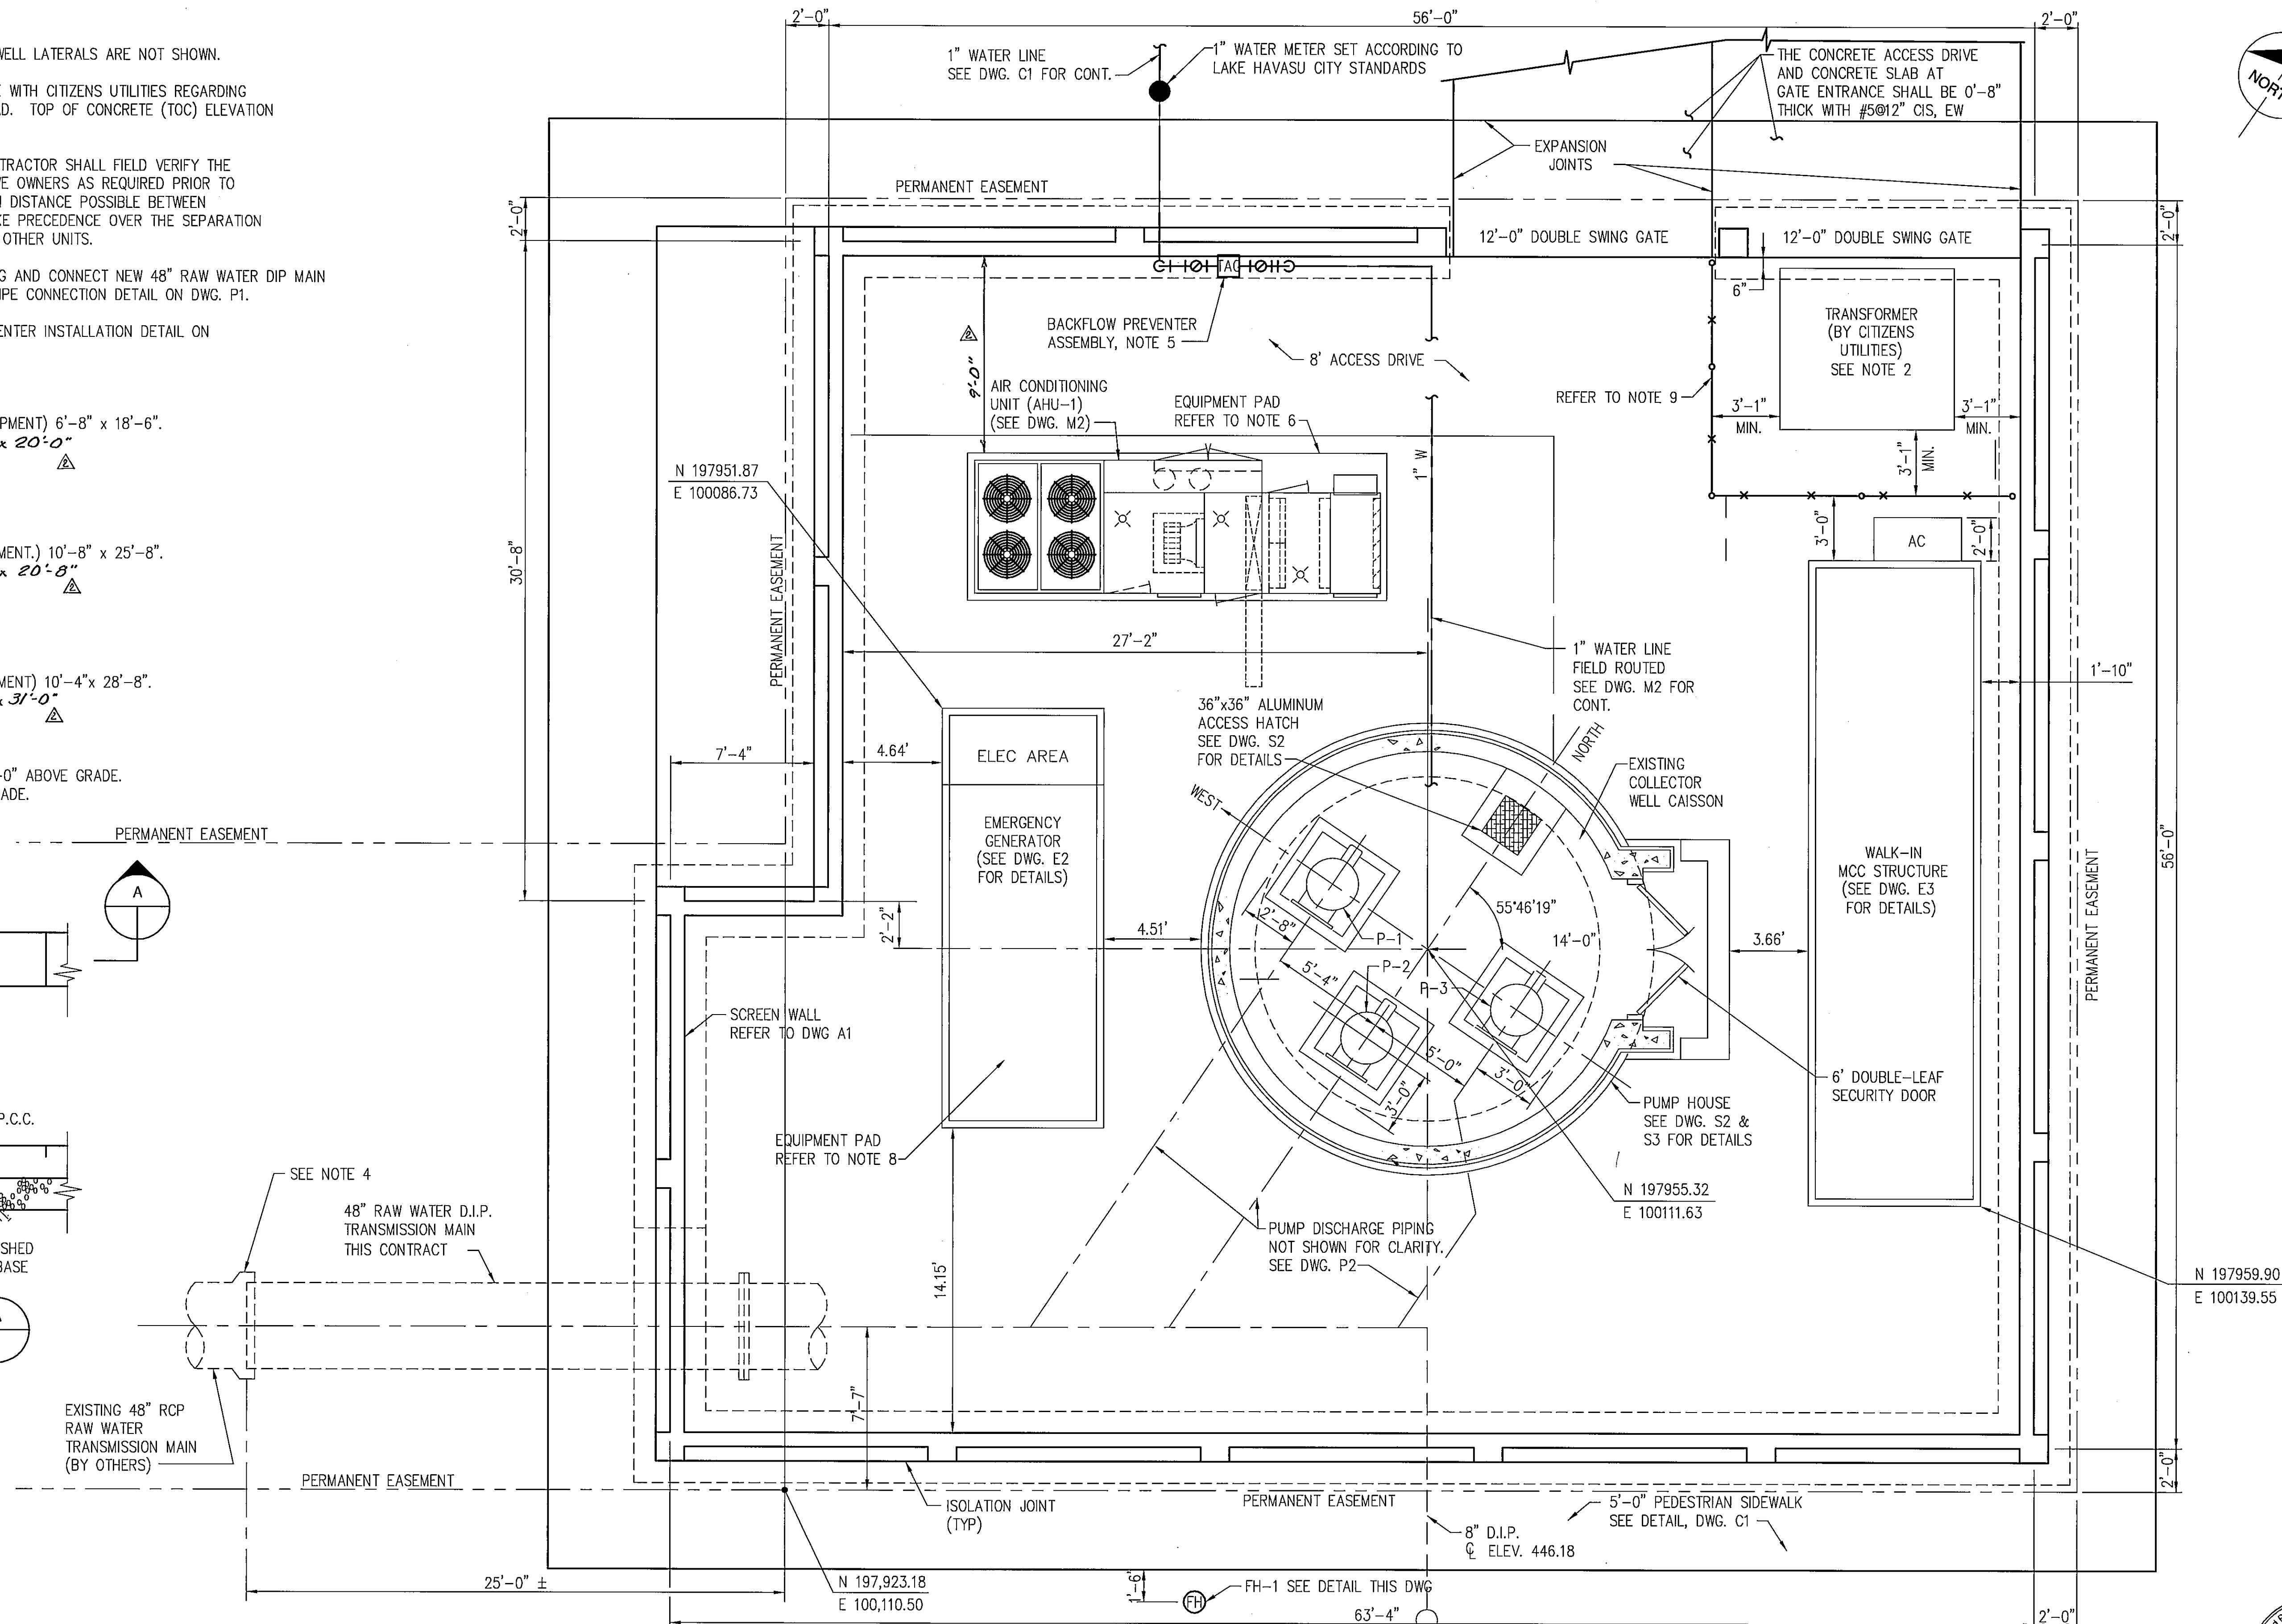

"AS-BUILT"


CALL TWO WORKING DAYS BEFORE YOU DIG  
1-800-STAKE-IT  
1-800-782-5348  
(OUTSIDE MARICOPA COUNTY)



no.	date	by	revision
1-9-01	JJM		(A1-G12) REVISE DRAWING TO ACCOMMODATE COLLECTOR WELL "AS BUILT" CONDITION
8-15-01	JDF		ADDED AS-BUILT DIMENSIONS
8-15-01	JDF		AS-BUILT




date JAN. 9, 2001  
designed J. MASCHE  
detailed D.DOMBROSKI  
checked J.L.S./J.J.M.

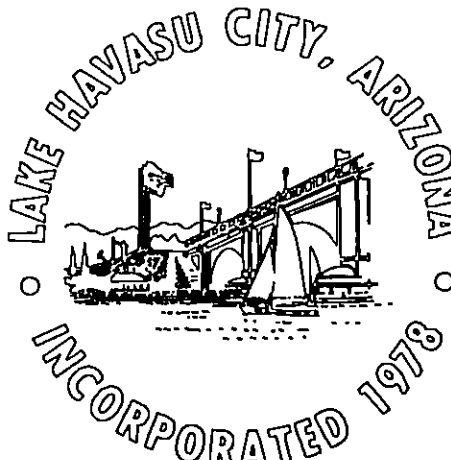

LONDON BRIDGE BEACH PUMP HOUSE	
EQUIPMENT LAYOUT	
project 97-777-1-002	contract W-183-00
drawing C2	rev. #2
sheet of sheets	
file Lbbphc02.dwg	06-14-2000 13:32 LJM






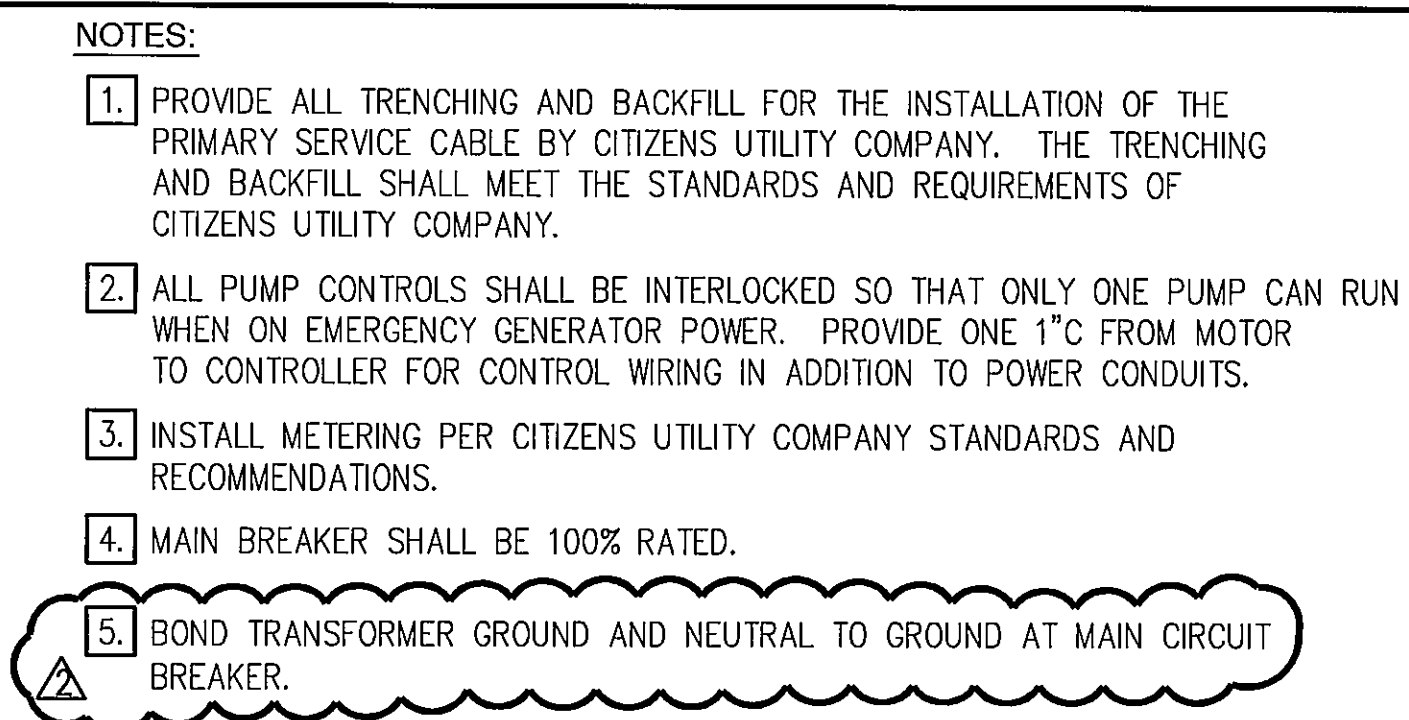

### ONE-LINE DIAGRAM


## “AS-BUILT”

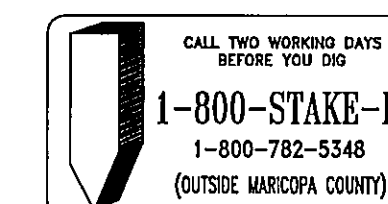

no.	date	by	revision
<u>A</u>	12/7/00	TJM	(B-2) FEEDER FROM UTILITY TRANSFORMER TO MAIN SWITCH-ADDED
			NEUTRAL CONDUCTORS (B-4) INCREASED GROUND
			CONDUCTOR FROM #1/0 TO 250MCM
<u>A</u>	1/3/01	TJM	(C-3)(B-15) ADDED NOTE 5.
	<del>8/15/01</del>	<del>JDF</del>	<del>As-BUILT</del>



date NOV. 11, 1999	detailed M. J. NEWTON
designed T. MOLL	checked E.L.T.

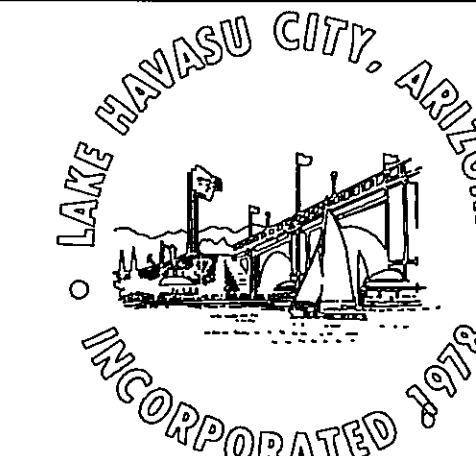


# LONDON BRIDGE BEACH PUMP HOUSE



## ELECTRICAL ONE-LINE DIAGRAM

COPYRIGHT © 2001 BURNS AND McDONNELL ENGINEERING COMPANY, INC.

Scale For Microfilming  
Inches  
Millimeters

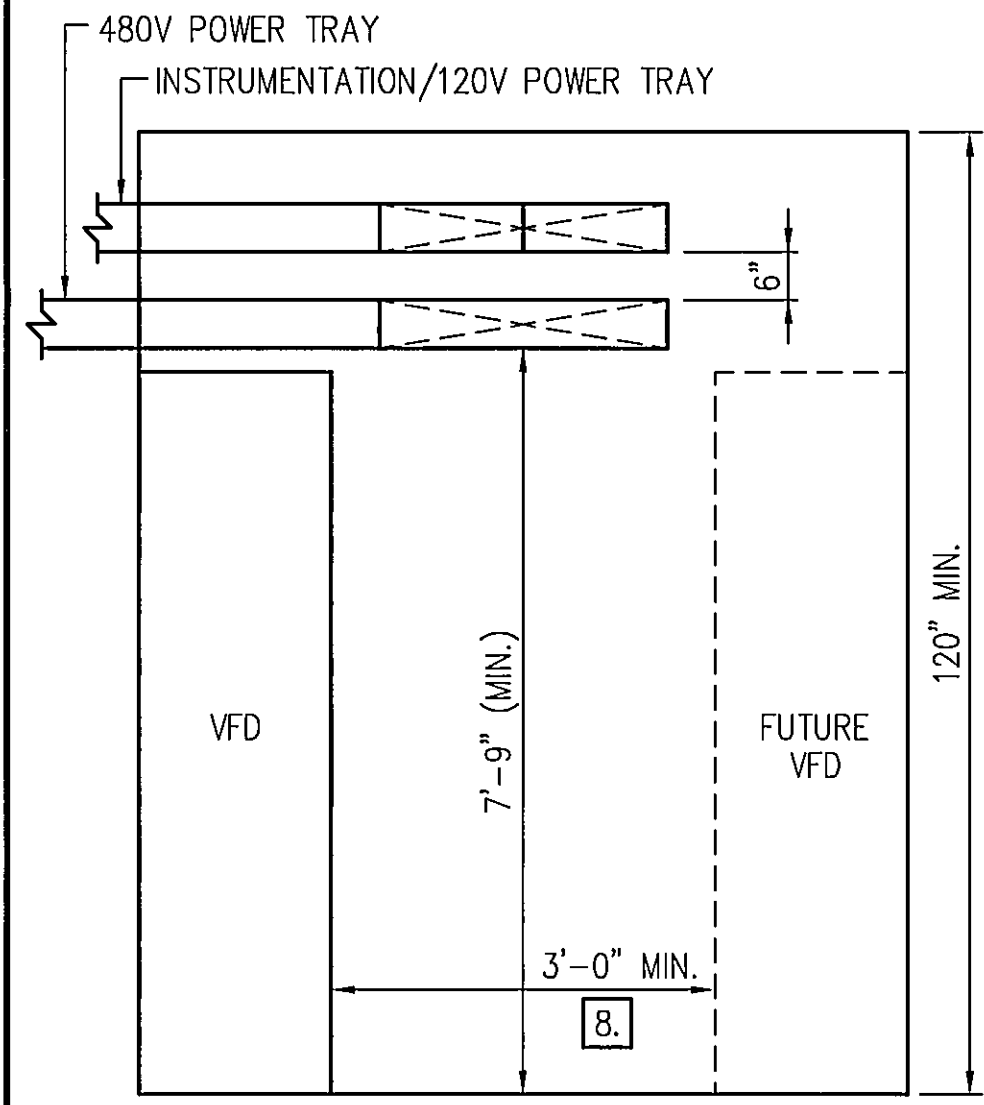

SECTION  
NOT TO SCALE

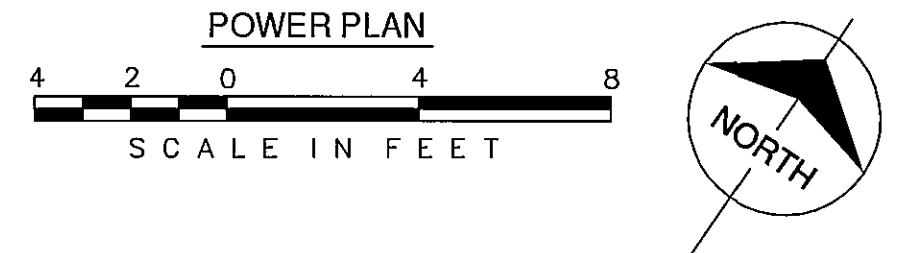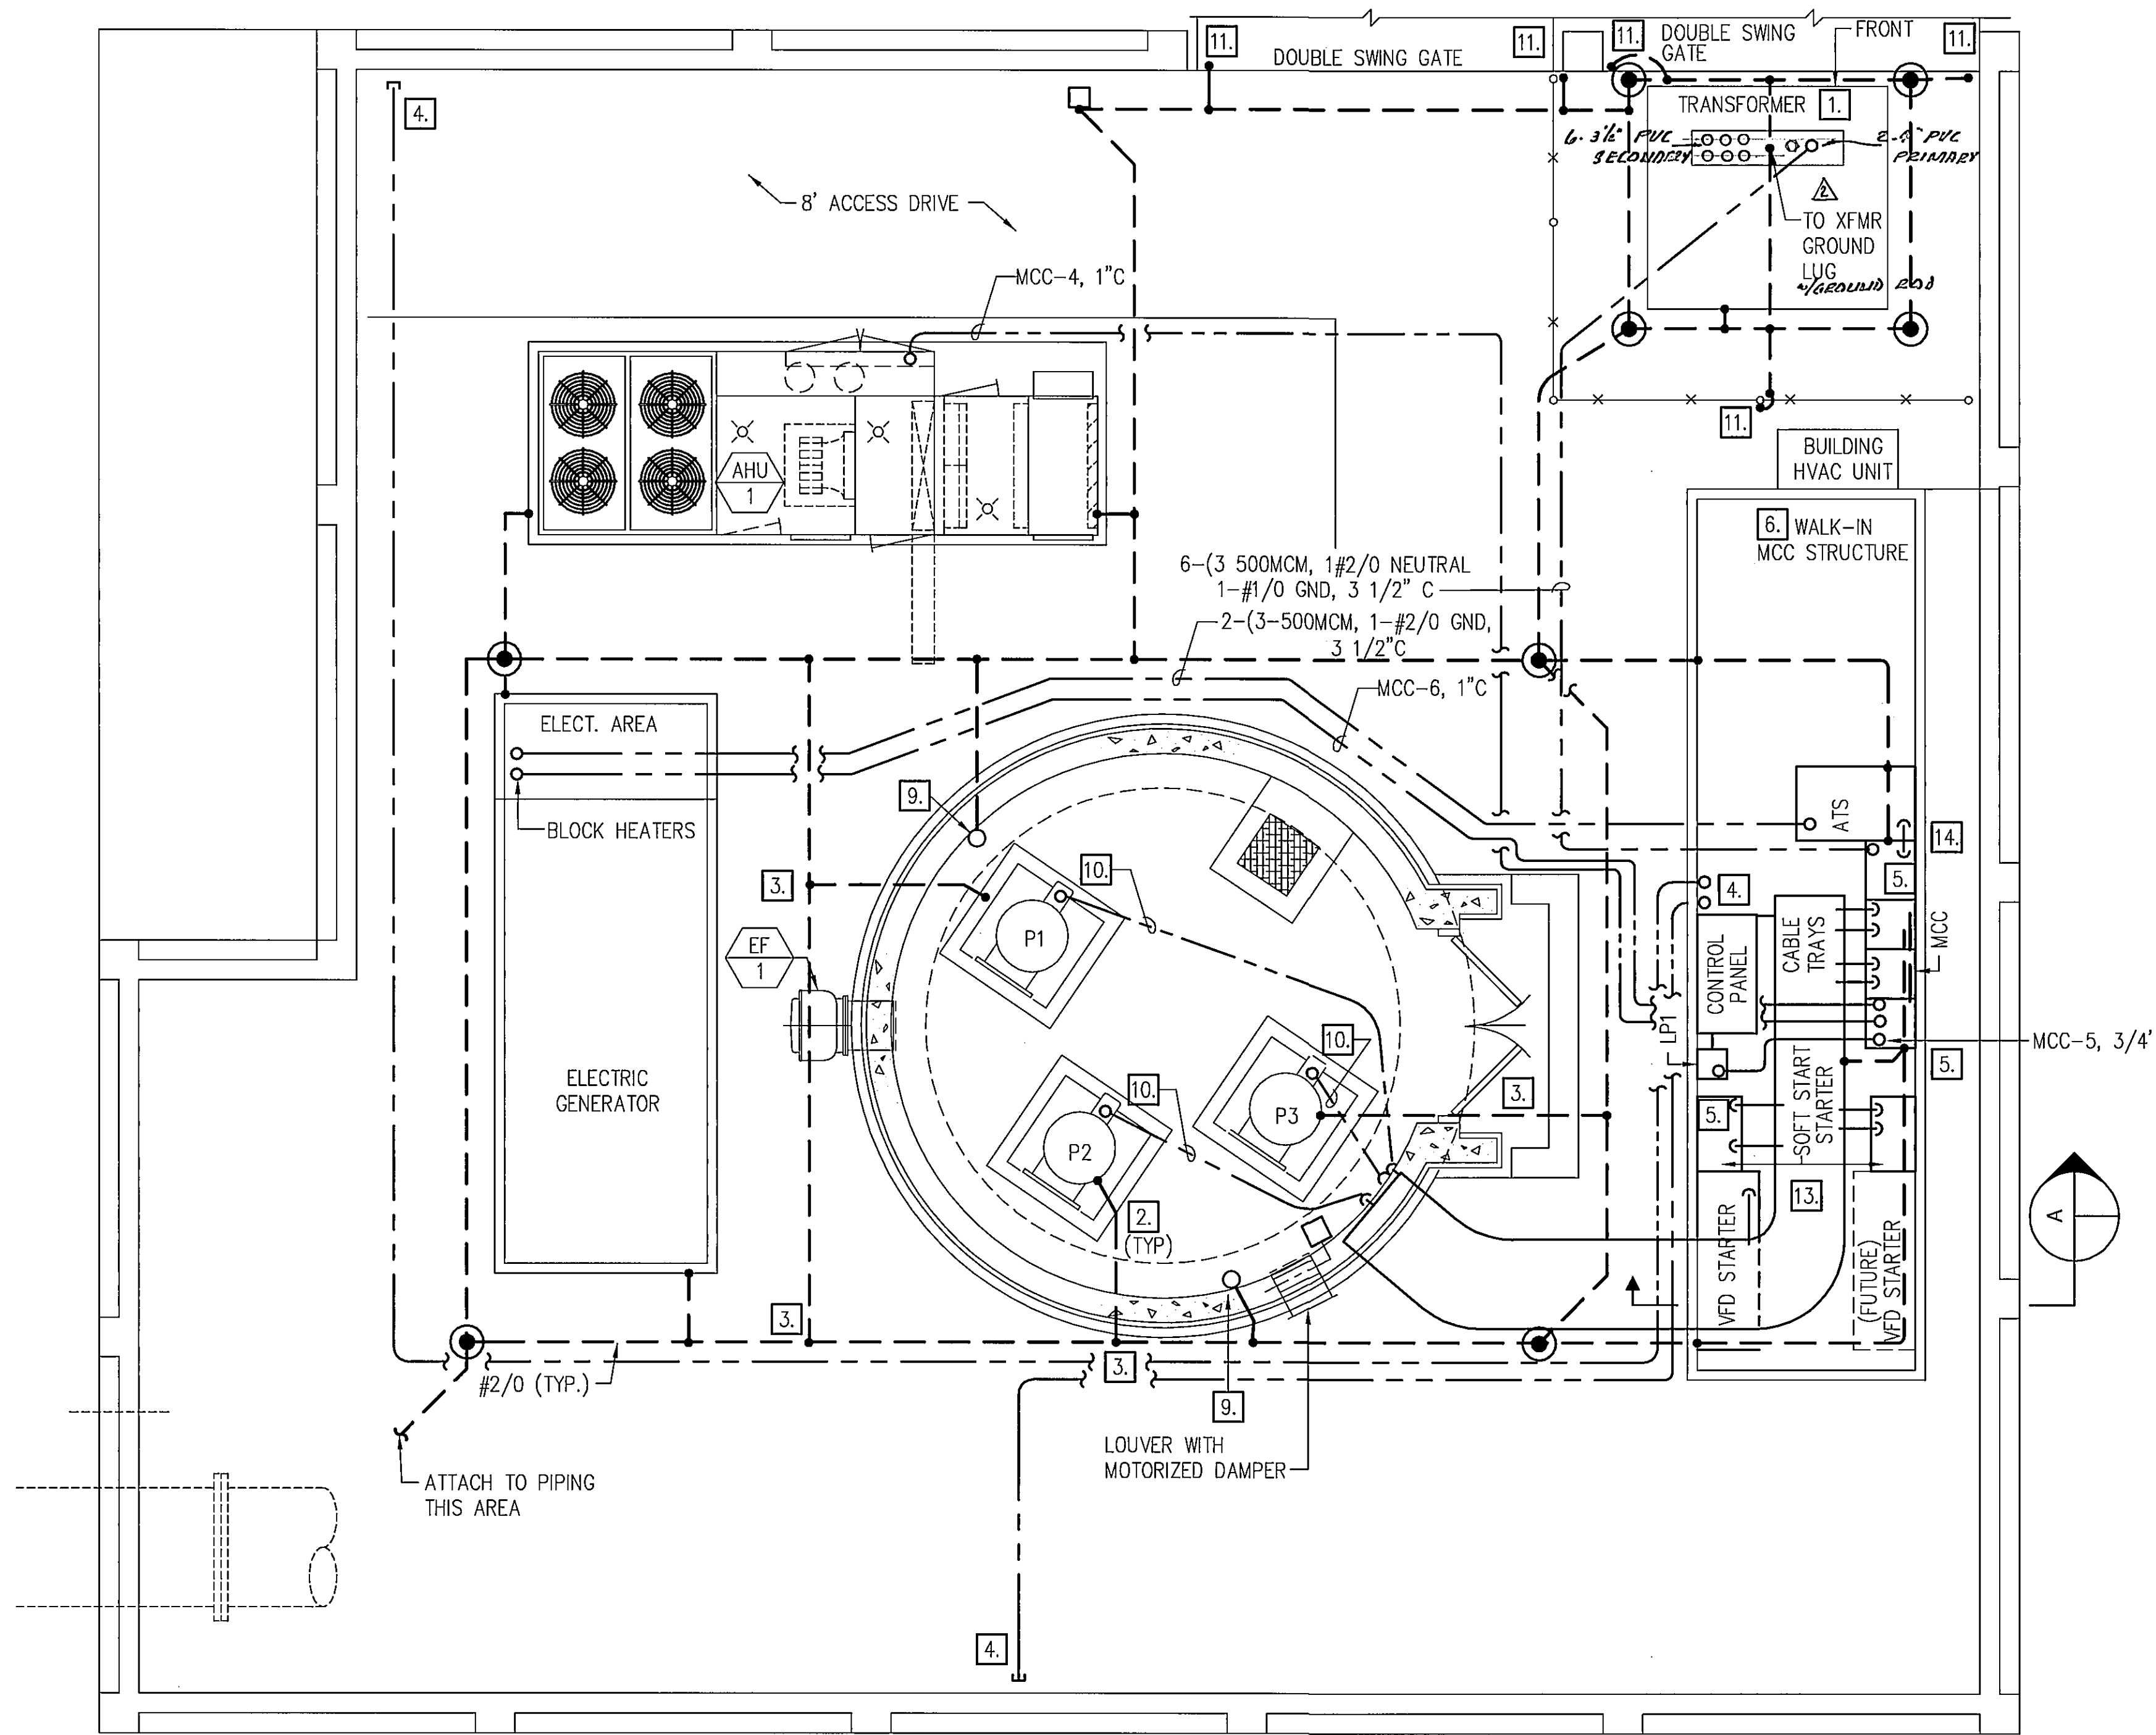

- NOTES:
1. PROVIDE TRANSFORMER PAD PER CITIZENS UTILITY COMPANY STANDARDS AND RECOMMENDATIONS.
  2. CONTRACTOR TO COORDINATE LOCATION OF GROUNDING CONDUCTORS WITH ORIENTATION OF PUMP MOTOR TO PROVIDE MINIMUM EXPOSED LENGTH OF GROUNDING CONDUCTOR AND FACILITATE CONNECTION TO PUMP MOTOR.
  3. CONTRACTOR SHALL LEAVE FIVE FEET OF SLACK IN GROUNDING CONDUCTOR WHERE GROUNDING CONDUCTOR ENTERS PUMP HOUSE SLAB. SLACK IN GROUNDING CONDUCTOR TO ALLOW FOR SETTLING OF SOIL AROUND WELL.
  4. PROVIDE 1" CONDUIT FOR FUTURE SCADA SYSTEM ANTENNA. STUB UP 6" ABOVE GROUND, CAP BOTH ENDS AND MAKE WATERTIGHT.
  5. CONNECT GROUNDING CONDUCTORS TO MCC GROUND BUS.
  6. CONTRACTOR SHALL VERIFY SLAB DIMENSIONS, THICKNESS AND REINFORCING WITH EQUIPMENT MANUFACTURER.
  7. COORDINATE CONDUIT ENTRANCE INTO ALL EQUIPMENT WITH APPROPRIATE MANUFACTURER'S DRAWINGS SHOWING CONDUIT ACCESS.
  8. PROVIDE SPACE FOR N.E.C. REQUIREMENTS, BASED ON EQUIPMENT FURNISHED.
  9. PROVIDE MECHANICAL CONNECTION TO METAL ROOF SUPPORT FOR #2/0 BARE COPPER CONDUCTOR FROM GROUNDING SYSTEM. PROVIDE APPROX. FIVE FEET OF SLACK IN GROUNDING CONDUCTOR BETWEEN FINAL WALL SUPPORT AND ROOF CONNECTION. COIL CONDUCTOR INSIDE ROOF CAVITY. SEE STRUCTURAL DRAWING S3 FOR POINT OF CONNECTION.
  10. CONDUIT RUN DEPICTS ROUTING OF TWO POWER CONDUITS (3" C) AND ONE CONTROL CONDUIT (3/4" C) TO EACH PUMP MOTOR.
  11. BOLT GROUND CABLE TO GATE'S STEEL SUPPORT. PROVIDE GROUND STRAP BETWEEN STEEL SUPPORT AND GATE AS SPECIFIED.
  12. ALL POWER, LIGHTING, INSTRUMENTATION, ETC., TO UTILIZE CABLE TRAY TO RUN BACK TO ELECTRICAL BUILDING.
  13. PROVIDE SUPPORTS FOR CABLE TRAY AS REQUIRED BY NEC. PROVIDE #2 GROUND CONDUCTOR LENGTH OF TRAY, ATTACH TO EACH INDIVIDUAL SECTION WITH BOLTED CONNECTION.
  14. BOND UTILITY TRANSFORMER GROUND AND NEUTRAL TO GROUND AT MAIN SWITCH.

**SPECIAL NOTE TO CONTRACTOR:**  
NO CONNECTIONS TO REMOVABLE ROOF ALLOWED EXCEPT AS NOTED FOR GROUNDING SYSTEM.

no.	date	by	revision
1	1-3-01	TJM	(A1-G16) REVISE DRAWING TO ACCOMMODATE COLLECTOR WELL "AS BUILT" CONDITION
2	8-15-01	JDF	DETAILED TRANSFORMER
3	8-15-01	JDF	AS-BUILT

**Burns & McDonnell**  
SINCE 1898


date  
DECEMBER, 26, 2000

designed  
T. MOLL


detailed  
D.DOMBROSKI

checked  
E.L.T.

"AS-BUILT"

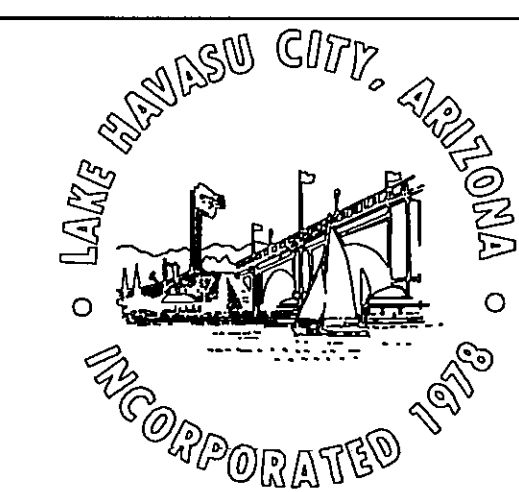


CALL TWO WORKING DAYS BEFORE YOU DIG  
**1-800-STAKE-IT**  
1-800-782-5348  
(OUTSIDE MARICOPA COUNTY)

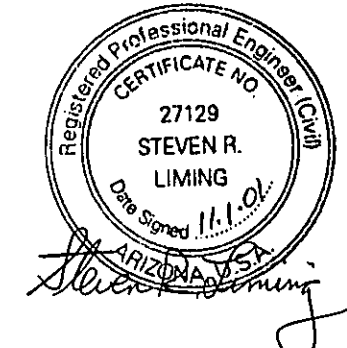

LONDON BRIDGE BEACH PUMP HOUSE			
ELECTRICAL POWER PLAN			
project	97-777-1-002	contract	W-183-00
drawing	<b>E3</b>	rev.	<b>#2</b>
sheet	17	of	21 sheets
file	Lbbphe3A.dwg	01-02-2001 11:14	DHD



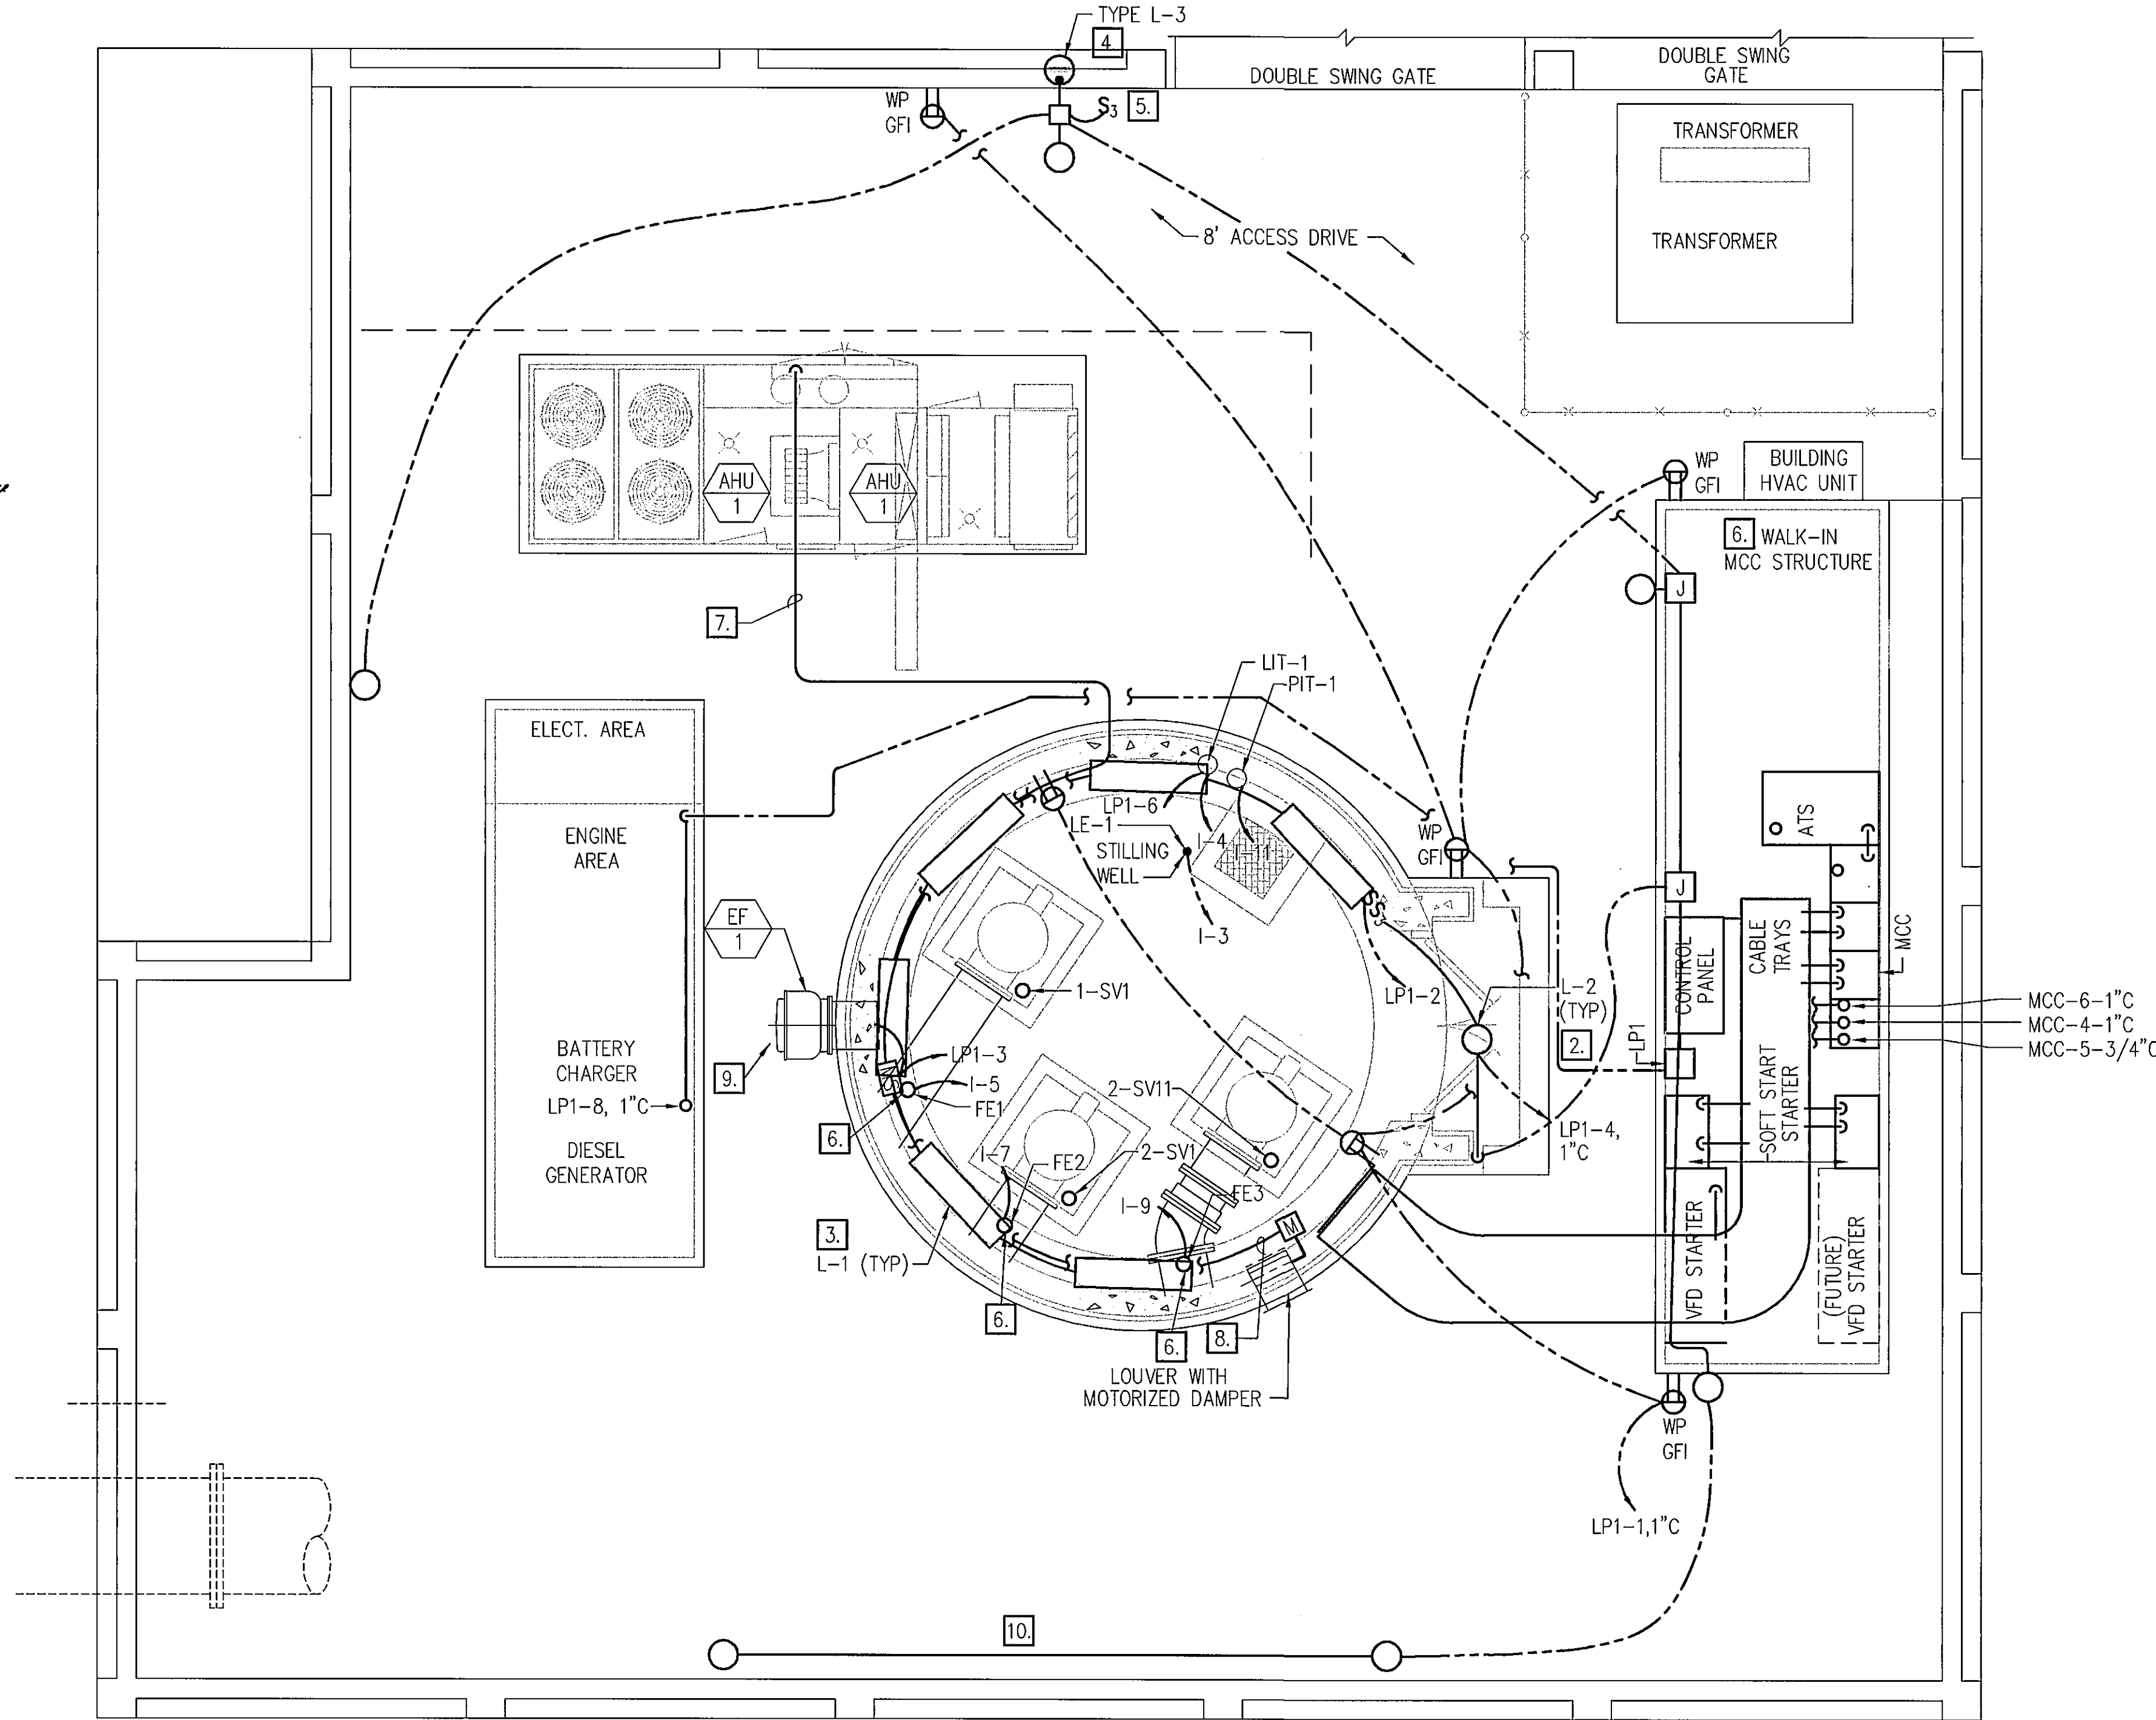


- 
- Diagram illustrating the installation of a stilling well. The well is constructed from 2" SCHEDULE 80 PVC WITH STAINLESS STEEL HARDWARE FASTENED TO CAISSON WALL. The well extends from the FLOOR (EL. 445') down to the END OF STILLING WELL (EL. 378'-0"). A KELLEMS STRAIN RELIEF is shown at the top of the well, connected to LIT-1. A TRANSDUCER is located at EL. 380'-0". The well is labeled LE-1.

LIGHTING, SMALL POWER AND CONTROL PLAN


4 2 0 4 8

SCALE IN FEET


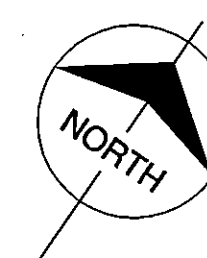


Registered Professional Engineer (Civil)  
 CERTIFICATE NO.  
 27129  
 STEVEN R.  
 LIMING  
 Date Signed 11-1-01  
 ARIZONA, U.S.A.  
 Steven R. Liming

sheet	18	of	21	sheets
file	Lbbphe4A.dwg	01-02-2001	10:46	DHD

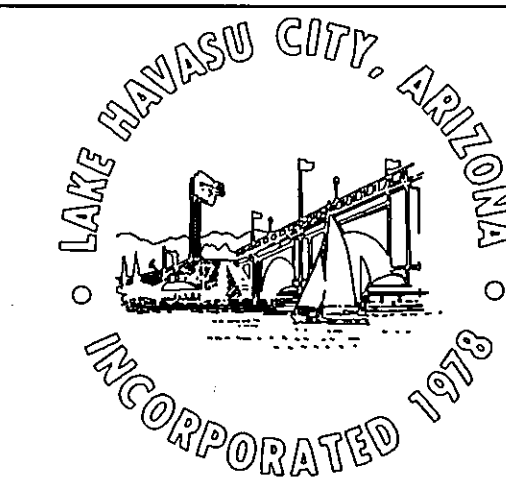



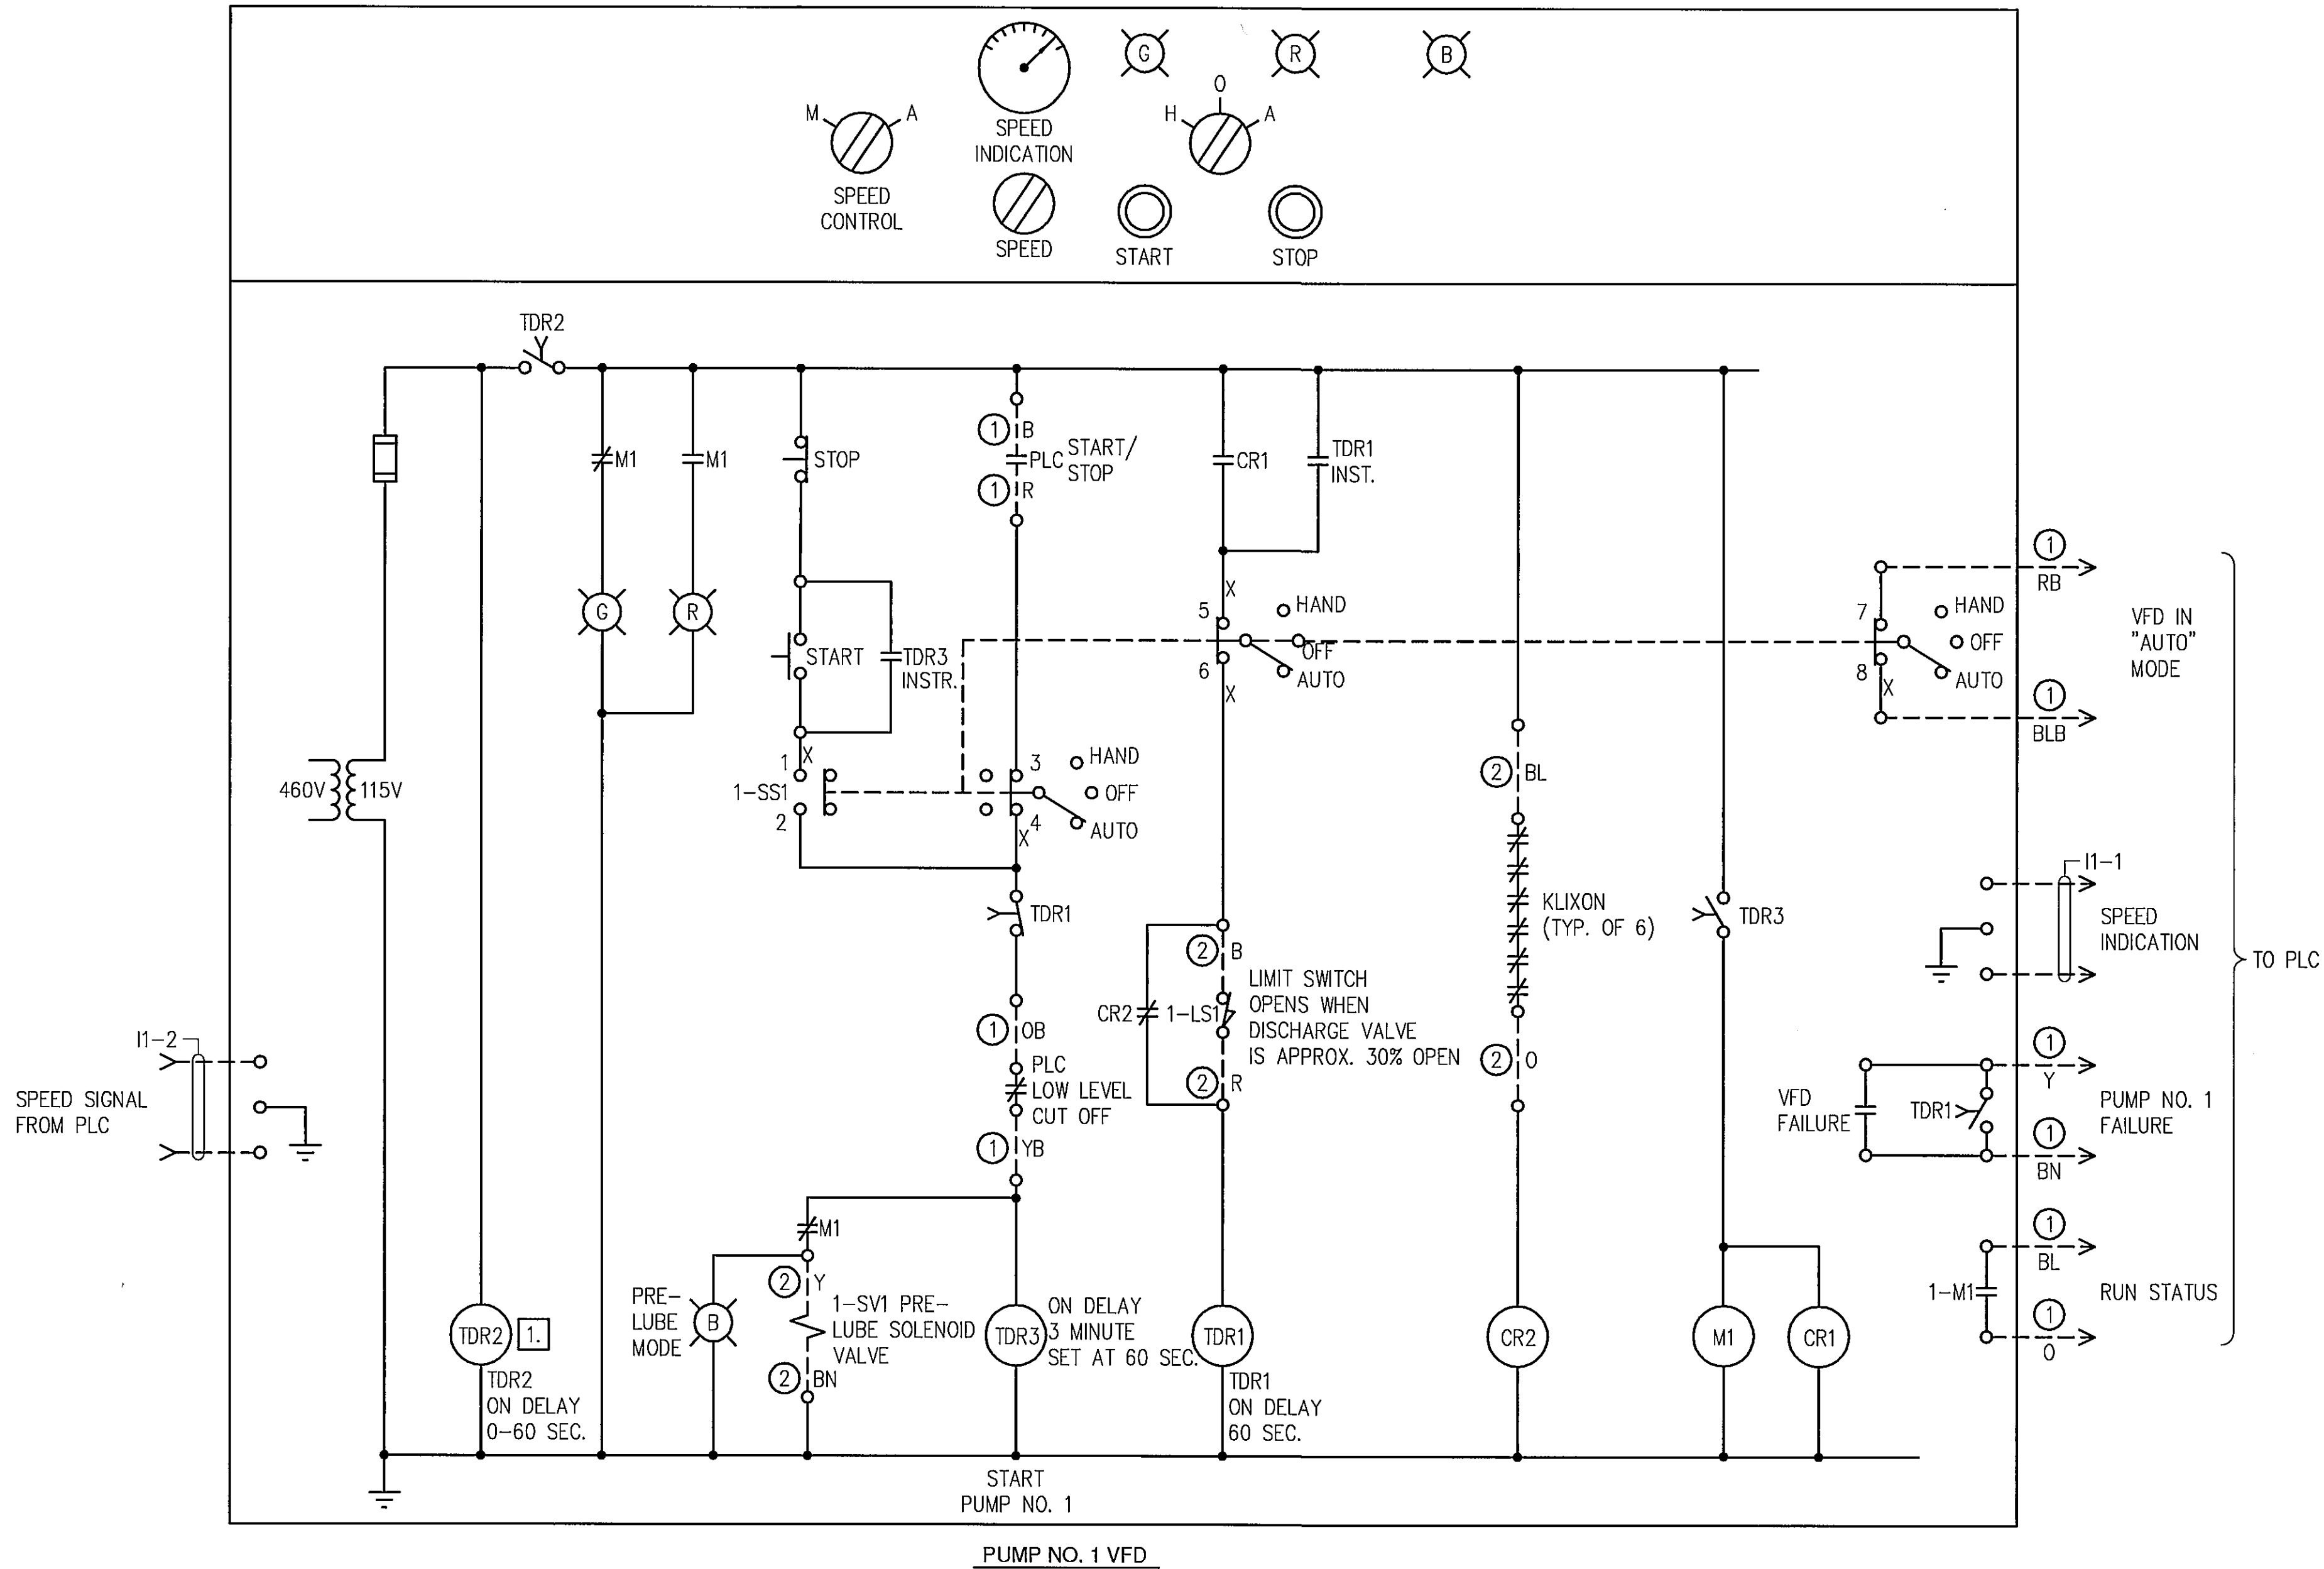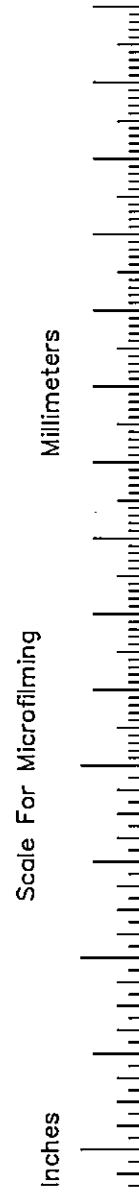

CONTACT DEVELOPMENT CONTROL SELECTOR SWITCH SS1			
CONTACTS	POSITIONS		
	HAND	OFF	AUTO
1-2	X		
3-4			X
5-6	X		X
7-8			X

X=CLOSED CONTACT

TIME DELAY RELAY SETTINGS		
PUMP	TDR	SETTINGS
PUMP NO. 1	1-TDR2	20 SEC.
PUMP NO. 1	1-TDR3	60 SEC.

DESCRIPTION OF OPERATION

**PUMP CONTROL**  
THE PUMP VFD SHALL HAVE A H-O-A SWITCH WITH CONTROLS AS FOLLOWS:  
HAND - THE PUMP SHALL BE STARTED/STOPPED FROM THE VFD.  
OFF - THE PUMP IS OFF.  
AUTO - THE PUMP SHALL BE CONTROLLED BY THE PLC.  
IF THE LEVEL FALLS TO 390'-0", THE PLC SHALL INITIATE A BACKUP, LOW LEVEL CUTOFF COMMAND TO ALL PUMPS.  
IF THE DISCHARGE VALVE FAILS TO OPEN OR HIGH MOTOR TEMPERATURE AFTER THE PUMP STARTS, TDR1 TIMES OUT IN 60 SECONDS AND SHUTS DOWN THE PUMP. TDR2 IS RESET AT EACH POWER FAILURE AND WILL NOT ALLOW THE PUMP TO START UNTIL IT TIMES-OUT AFTER POWER IS RESTORED.

**PRE-LUBRICATION**  
THE PRE-LUBRICATION SYSTEM IS ENERGIZED (PRE-LUB SOLENOID 1-SV1) IMMEDIATELY WHEN THE "START" PUSHBUTTON IS DEPRESSED OR THE PLC "START" COMMAND IS ISSUED. THE BLUE "PRE-LUBE" LIGHT IS ILLUMINATED. THE PRE-LUBRICATION PROCESS LASTS ONE (1) MINUTE AND THEN THE PUMP IS STARTED. AFTER THE PUMP IS RUNNING THE PRE-LUBRICATION SYSTEM IS DE-ENERGIZED AND THE BLUE LIGHT IS NO LONGER ILLUMINATED.

**SPEED CONTROL**  
LOCATION WHERE SPEED IS TO BE CONTROLLED IS DESIGNATED BY A MANUAL/AUTO SWITCH ON THE VFD. CONTROL IS AS FOLLOWS.  
AUTO - SPEED WILL BE CONTROLLED BY A SPEED POTENTIOMETER AT THE VFD.  
MANUAL - THE PUMP SPEED WILL BE CONTROLLED BY THE PLC IN THE PUMP CONTROL PANEL.

**INDICATING LIGHTS**  
LIGHTS ARE TO BE PROVIDED ON THE VFD AS FOLLOWS:  
RED - RUN  
GREEN - OFF  
BLUE - PRE-LUBE


**ANNUNCIATION**  
PUMP SHUTDOWN DUE TO DISCHARGE VALVE FAILURE TO OPEN, OR COMMON VFD FAILURE.

**NOTES:**  
1. RELAY TDR2 DELAYS OPERATION OF THE PUMP UPON RESTORATION OF POWER FOLLOWING POWER FAILURE. SEE CHART ON THIS DRAWING FOR SETTING.


TABLE OF INTERCONNECTION WIRING				
CIRCUIT NUMBER	COLOR	CONNECTIONS		FUNCTION
		FROM	TO	
C1-1	B	PUMP NO. 1 VFD	PUMP STATION PLC	CONTROL
	R			
	BL			RUN STATUS
	O			
	Y			FAILURE
	BN			ALARM
	RB			INDICATION
	BLB			
	OB			CONTROL
	YB			
C1-2	BNB			SPARE
	BR			
I1-1		PUMP NO. 1 VFD	PUMP STATION PLC	
	ONE			SPEED
	PAIR			INDICATION
I1-2		PLC	PUMP NO. 1 VFD	
	ONE			SPEED
	PAIR			CONTROL

"AS-BUILT"

1

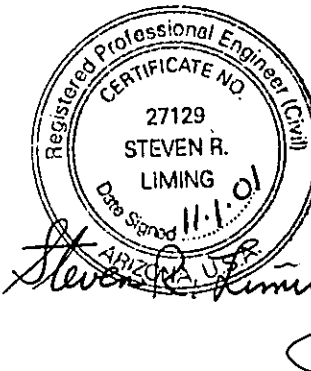


date NOV. 23, 1999 detailed J. RECKART  
designed T. MOLL checked E.L.T.

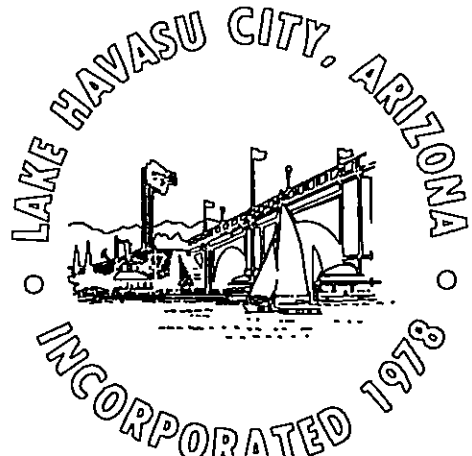

LONDON BRIDGE BEACH PUMP HOUSE  
PUMP CONTROL  
DIAGRAMS NO. 1

project 97-777-1-002 contract W-183-00  
drawing E5 rev. -  
sheet 19 of 21 sheets  
file Lbbphe05.dwg 03-21-2000 11:26 LJM

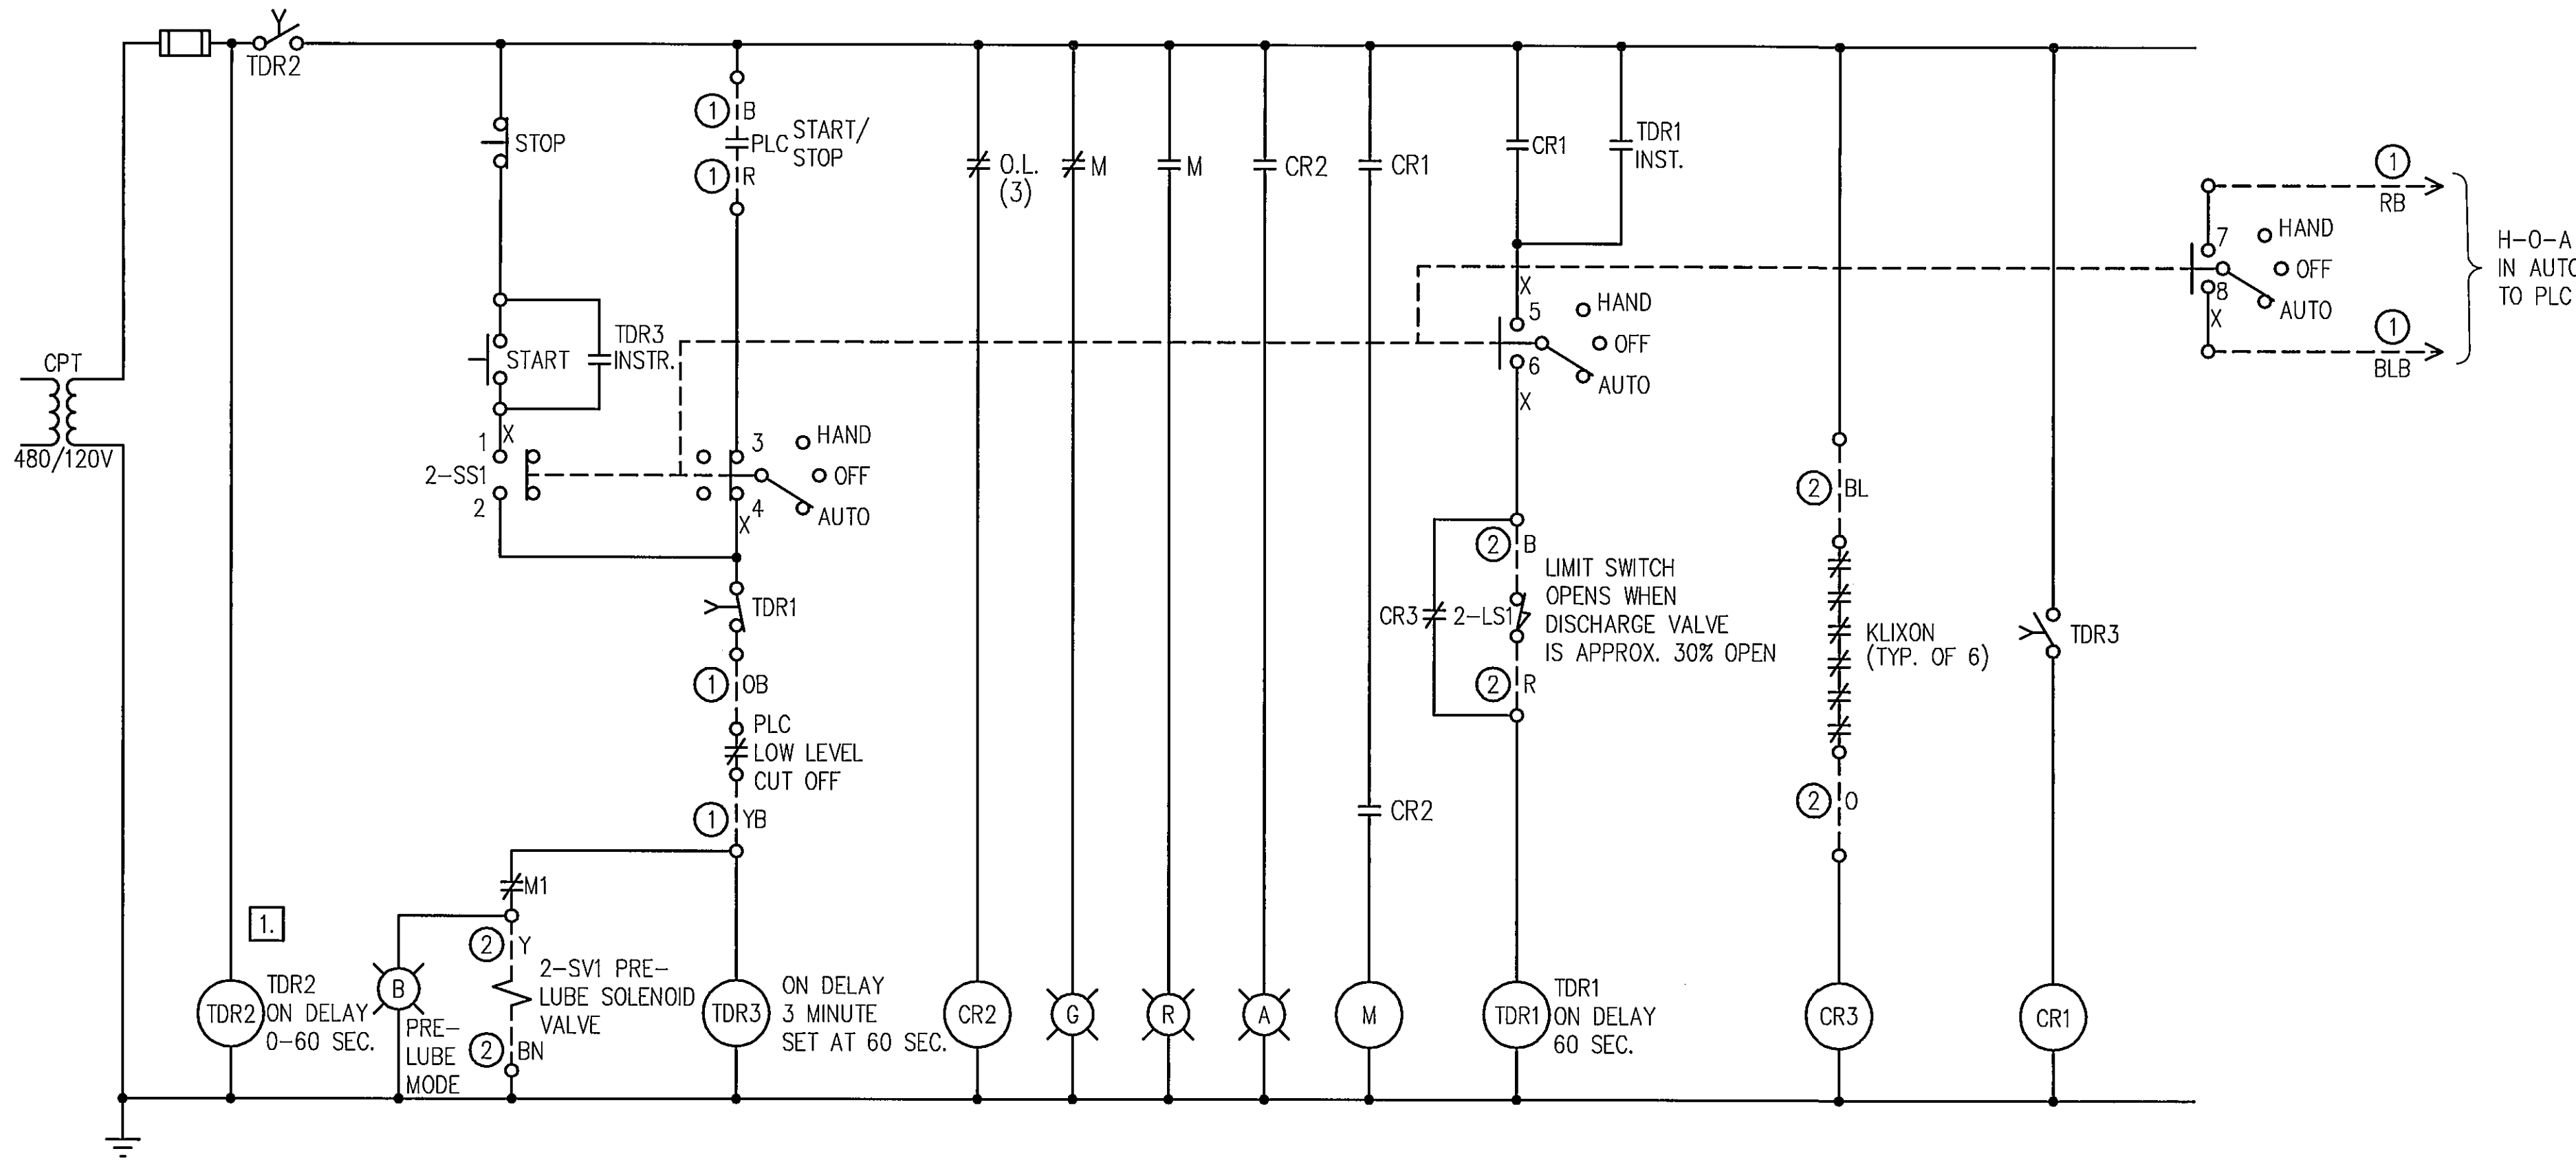

PUMP NO. 2 MOTOR STARTER  
(TYPICAL FOR PUMP NO. 3)

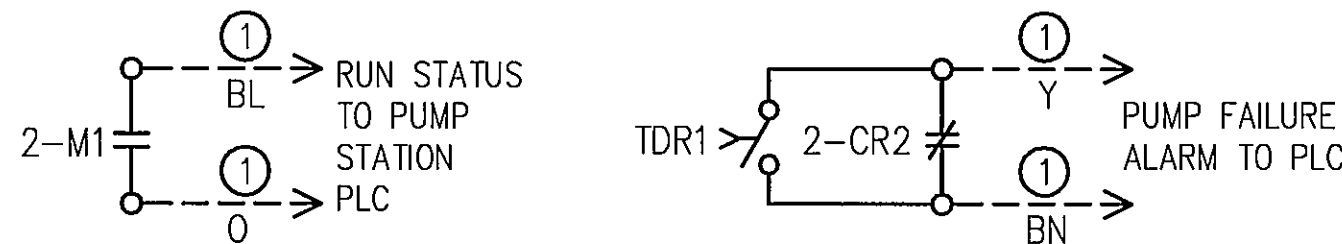


	TABLE OF CORRESPONDING DEVICES AND CIRCUITS								
	DEVICES								CIRCUITS
PUMP NO. 2	2-TDR1	2-TDR2	2-CR1	2-CR2	2-CR3	2-SS1	2-LS1	2-SV1	C2-1 C2-2
PUMP NO. 3	2-TDR11	2-TDR12	2-CR11	2-CR12	2-CR13	2-SS11	2-LS11	2-SV11	C2-11 C2-12

TIME DELAY RELAY SETTINGS		
PUMP	TDR	SETTINGS
PUMP NO. 2	2-TDR2	30 SEC.
PUMP NO. 2	2-TDR3	60 SEC.
PUMP NO. 3	2-TDR12	40 SEC.
PUMP NO. 3	2-TDR13	60 SEC.

CONTACT DEVELOPMENT CONTROL SELECTOR SWITCH SS1 AND SS11			
CONTACTS	POSITIONS		
	HAND	OFF	AUTO
1-2	X		
3-4			X
5-6	X		X
7-8			X

X=CLOSED CONTACT

DESCRIPTION OF OPERATION

PUMP CONTROL

THE PUMP STARTER SHALL HAVE A H-O-A SWITCH WITH CONTROLS AS FOLLOWS:  
HAND - THE PUMP SHALL BE STARTED/STOPPED FROM THE STARTER.

OFF - THE PUMP IS OFF.

AUTO - THE PUMP SHALL BE CONTROLLED BY THE PLC.

IF THE LEVEL FALLS TO 390'-0", THE PLC SHALL INITIATE A BACKUP, LOW LEVEL CUTOFF COMMAND TO ALL PUMPS.

IF THE DISCHARGE VALVE FAILS TO OPEN OR HIGH MOTOR TEMPERATURE AFTER THE PUMP STARTS, TDR1 TIMES OUT IN 60 SECONDS AND SHUTS DOWN THE PUMP. TDR2 IS RESET AT EACH POWER FAILURE AND WILL NOT ALLOW THE PUMP TO START UNTIL IT TIMES-OUT AFTER POWER IS RESTORED.

PRE-LUBRICATION

THE PRE-LUBRICATION SYSTEM IS ENERGIZED (PRE-LUBE SOLENOID 2-SV1) IMMEDIATELY WHEN THE "START" PUSHBUTTON IS DEPRESSED OR THE PLC "START" COMMAND IS ISSUED. THE BLUE "PRE-LUBE" LIGHT IS ILLUMINATED. THE PRE-LUBRICATION PROCESS LASTS ONE (1) MINUTE AND THEN THE PUMP IS STARTED. AFTER THE PUMP IS RUNNING THE PRE-LUBRICATION SYSTEM IS DE-ENERGIZED AND THE BLUE LIGHT IS NO LONGER ILLUMINATED.

INDICATING LIGHTS

LIGHTS ARE TO BE PROVIDED ON THE MOTOR STARTER AS FOLLOWS:

- RED - RUN
- GREEN - OFF
- BLUE - PRE-LUBE
- AMBER - PUMP OVERLOAD ALARM

ANNUNCIATION

PUMP SHUTDOWN DUE TO DISCHARGE VALVE FAILURE TO OPEN, OR COMMON STARTER FAILURE.

NOTES:


- RELAY TDR2 DELAYS OPERATION OF THE PUMP UPON RESTORATION OF POWER, FOLLOWING POWER FAILURE. SEE CHART ON THIS DRAWING FOR SETTINGS.

TABLE OF INTERCONNECTION WIRING				
CIRCUIT NUMBER	COLOR	CONNECTIONS		FUNCTION
		FROM	TO	
C2-1		PUMP NO. 3 MOTOR STARTER	PUMP STATION PLC	
	B			CONTROL
	R			
	BL			STATUS
	O			
	Y			CONTROL
	BN			
	RB			IN "AUTO" MODE
	BLB			
	OB			CONTROL
	YB			
	BNB			SPARES
	BR			
C2-2		PUMP NO. 3 MOTOR STARTER	PUMP MOTOR NO. 3	
	B			CONTROL
	R			
	BL			CONTROL
	O			
	Y			PRE-LUBE
	BN			
	RB			SPARE

no.	date	by	revision
8-1501	JDF	AS-BUILT	




date NOV. 23, 1999  
designed T. MOLL  
detailed J. RECKART  
checked E.L.T.

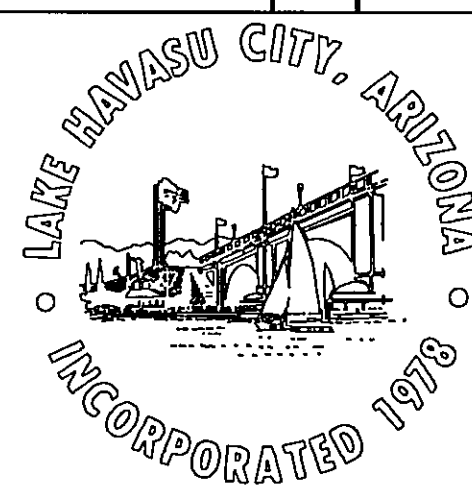


LONDON BRIDGE BEACH PUMP HOUSE  
PUMP CONTROL  
DIAGRAMS NO. 2


project 97-777-1-002 contract W-183-00  
drawing E6 rev. -  
sheet 20 of 21 sheets  
file Lbbphe06.dwg 03-21-2000 11:31 LJM

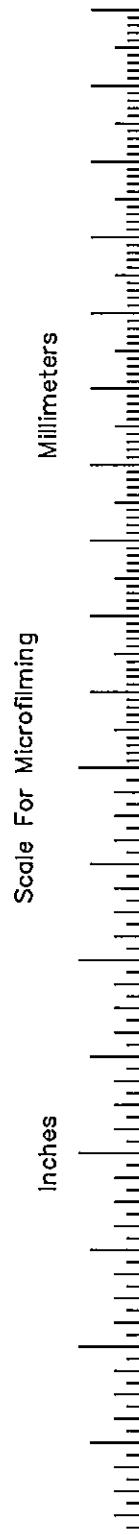


ANALOG INPUTS TO PLC

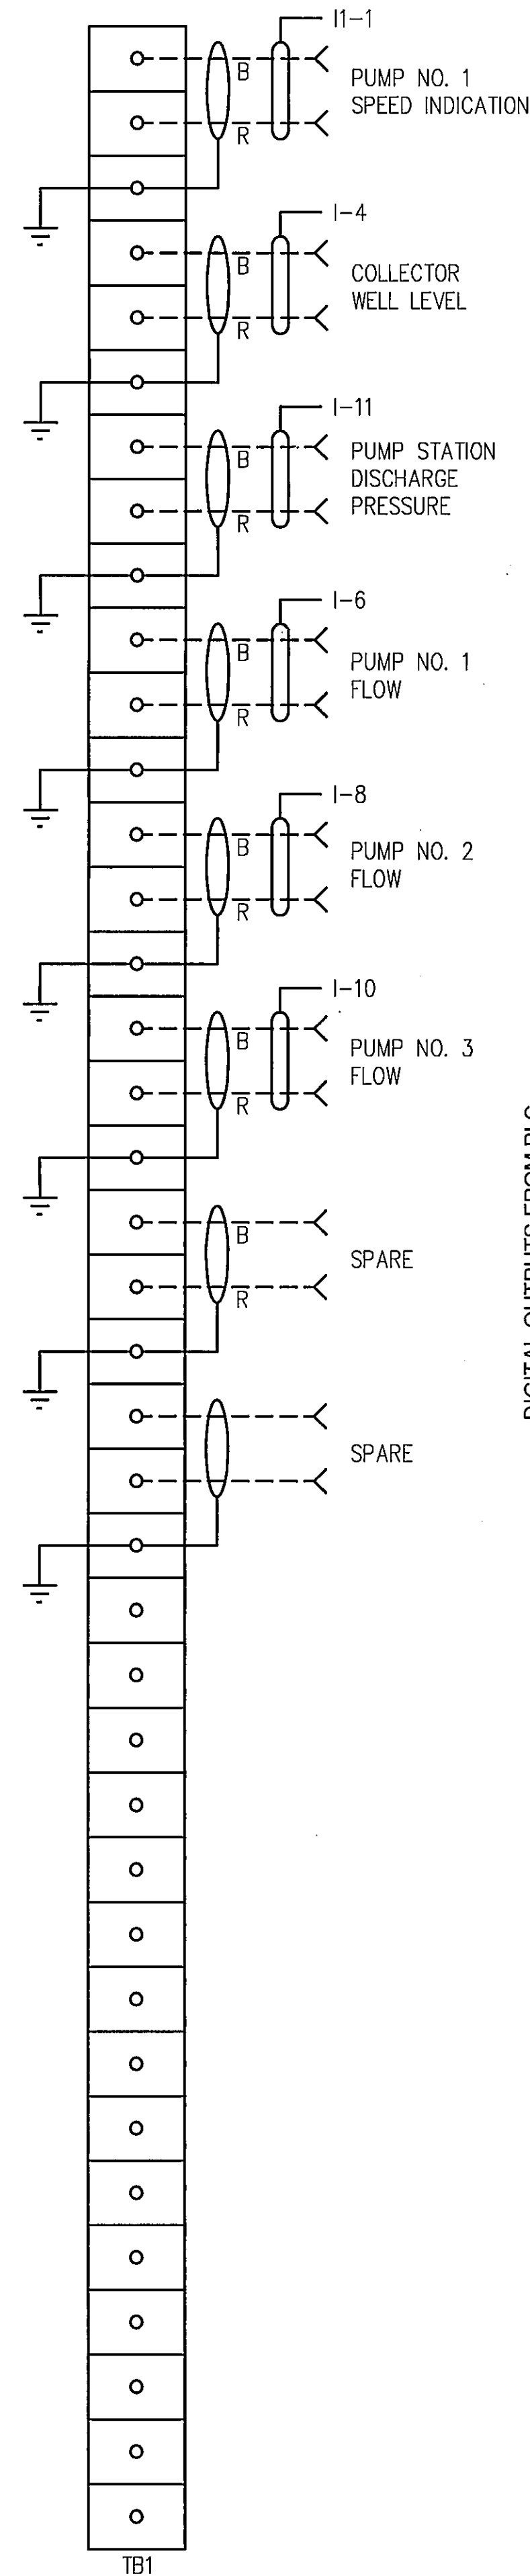


DIGITAL OUTPUTS FROM PLC

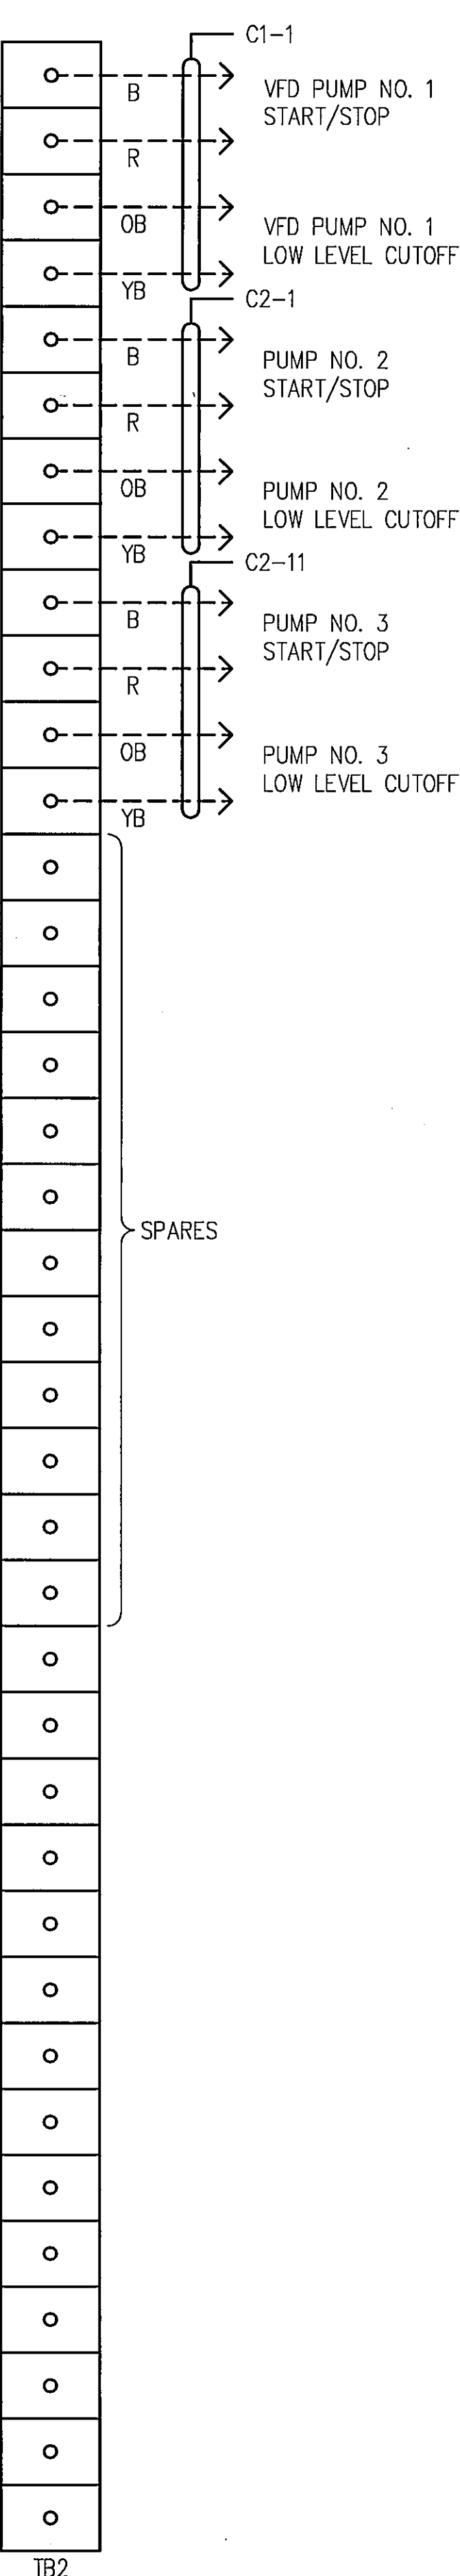


DIGITAL INPUTS TO PLC

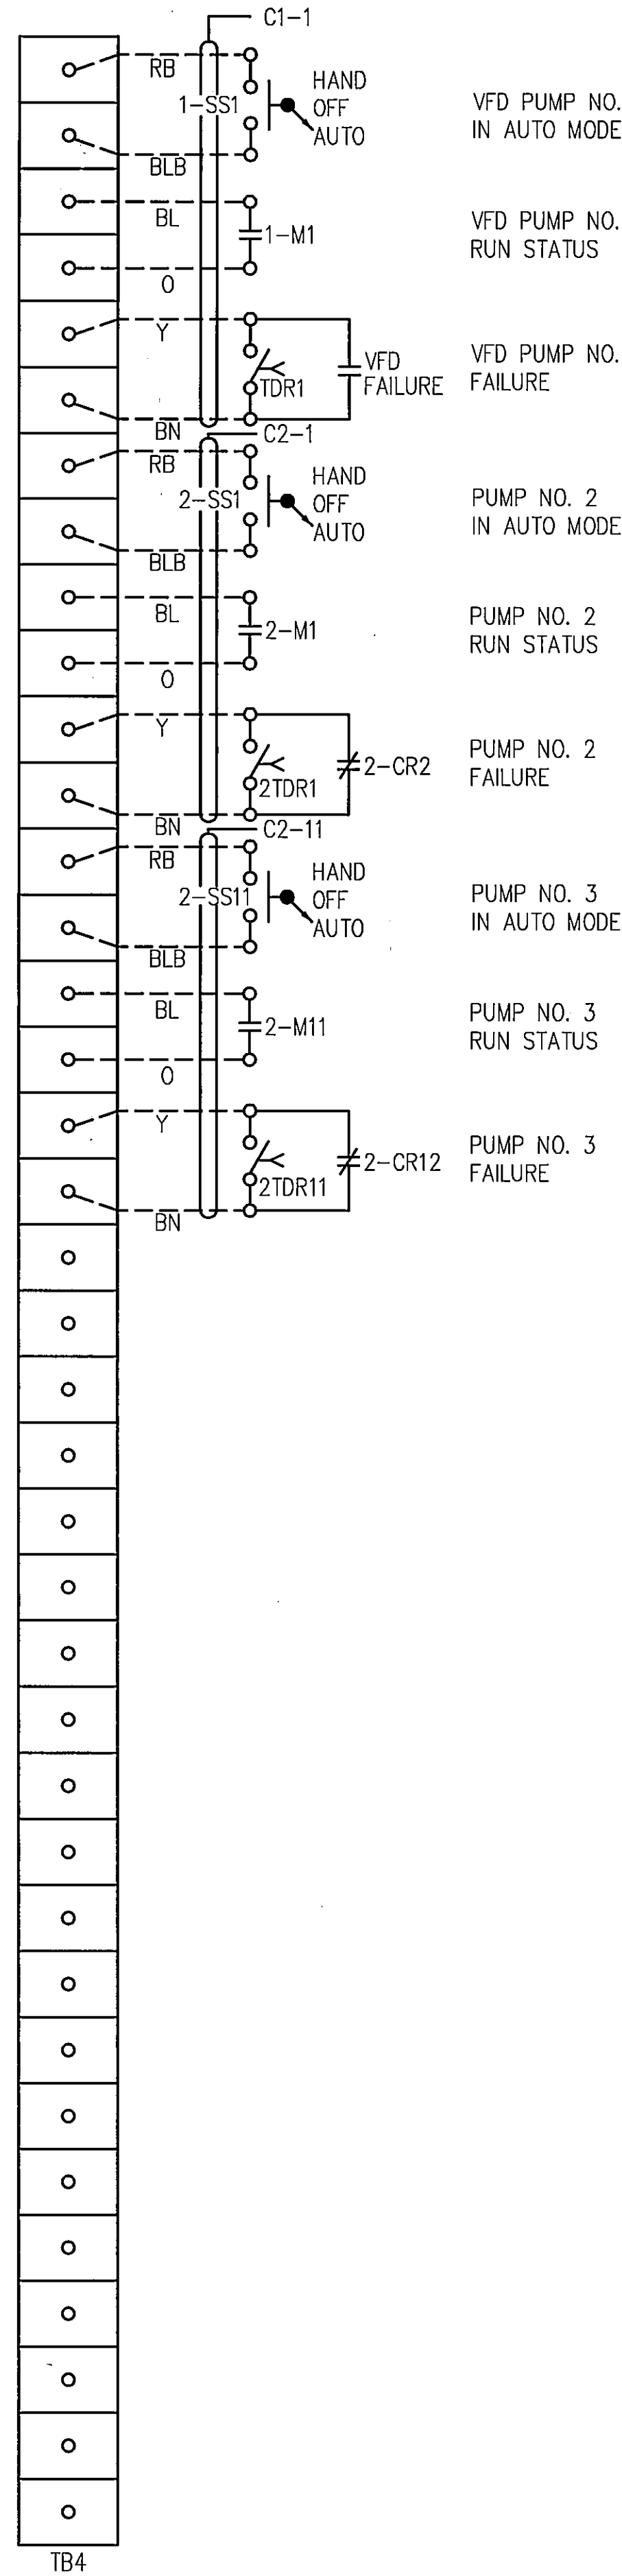

ANALOG OUTPUTS FROM PLC

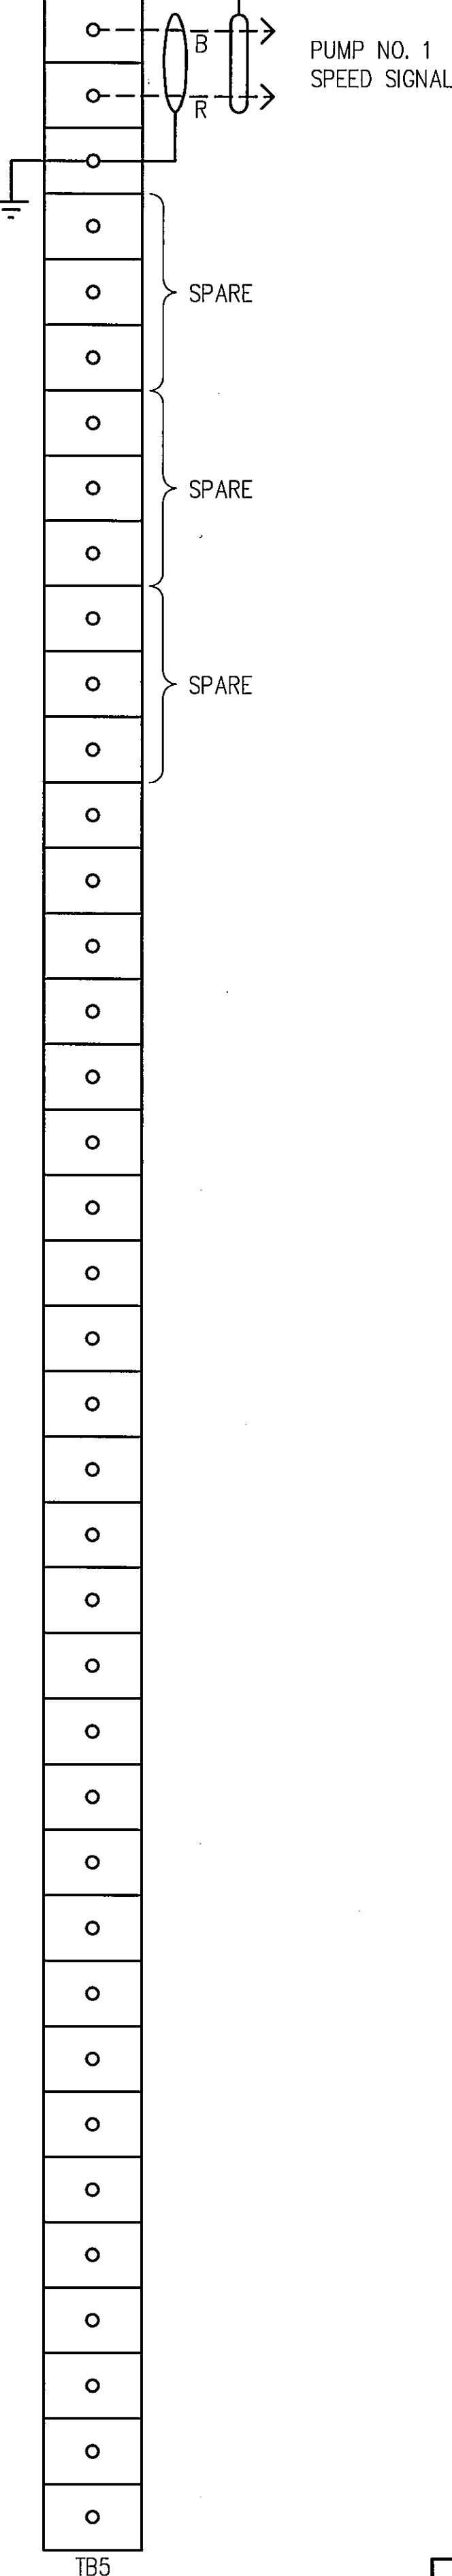


3

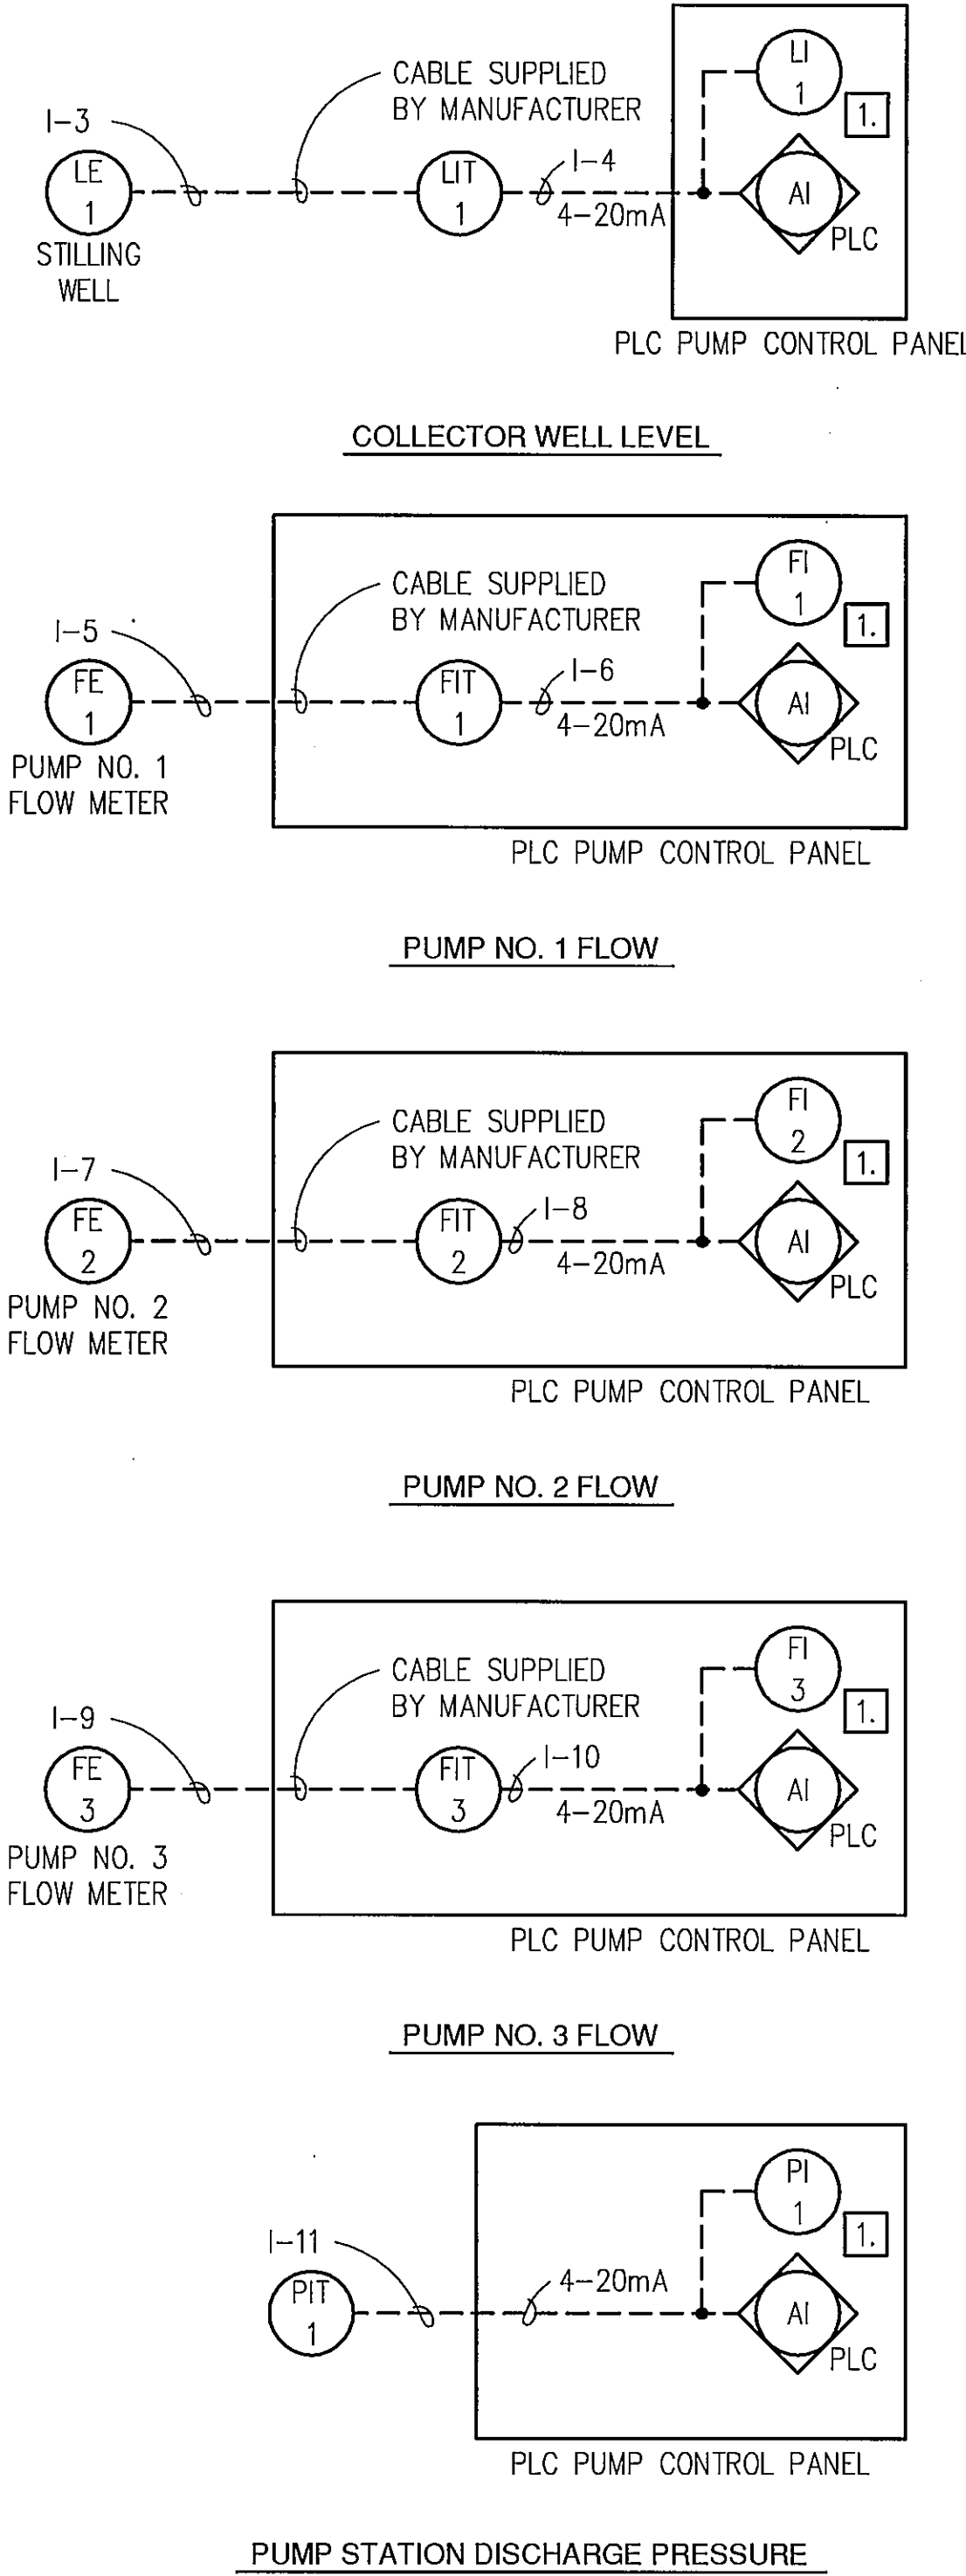

NOTES:

1. MOUNT ON FACE OF PLC PUMP CONTROL PANEL.
2. POWER INSTRUMENTATION AT PLC PUMP CONTROL PANEL ON ONE CIRCUIT. PROTECT EACH UNIT SEPARATELY BY FUSED DISCONNECT INSIDE THE CONTROL PANEL. SIZE ACCORDING TO NEC.

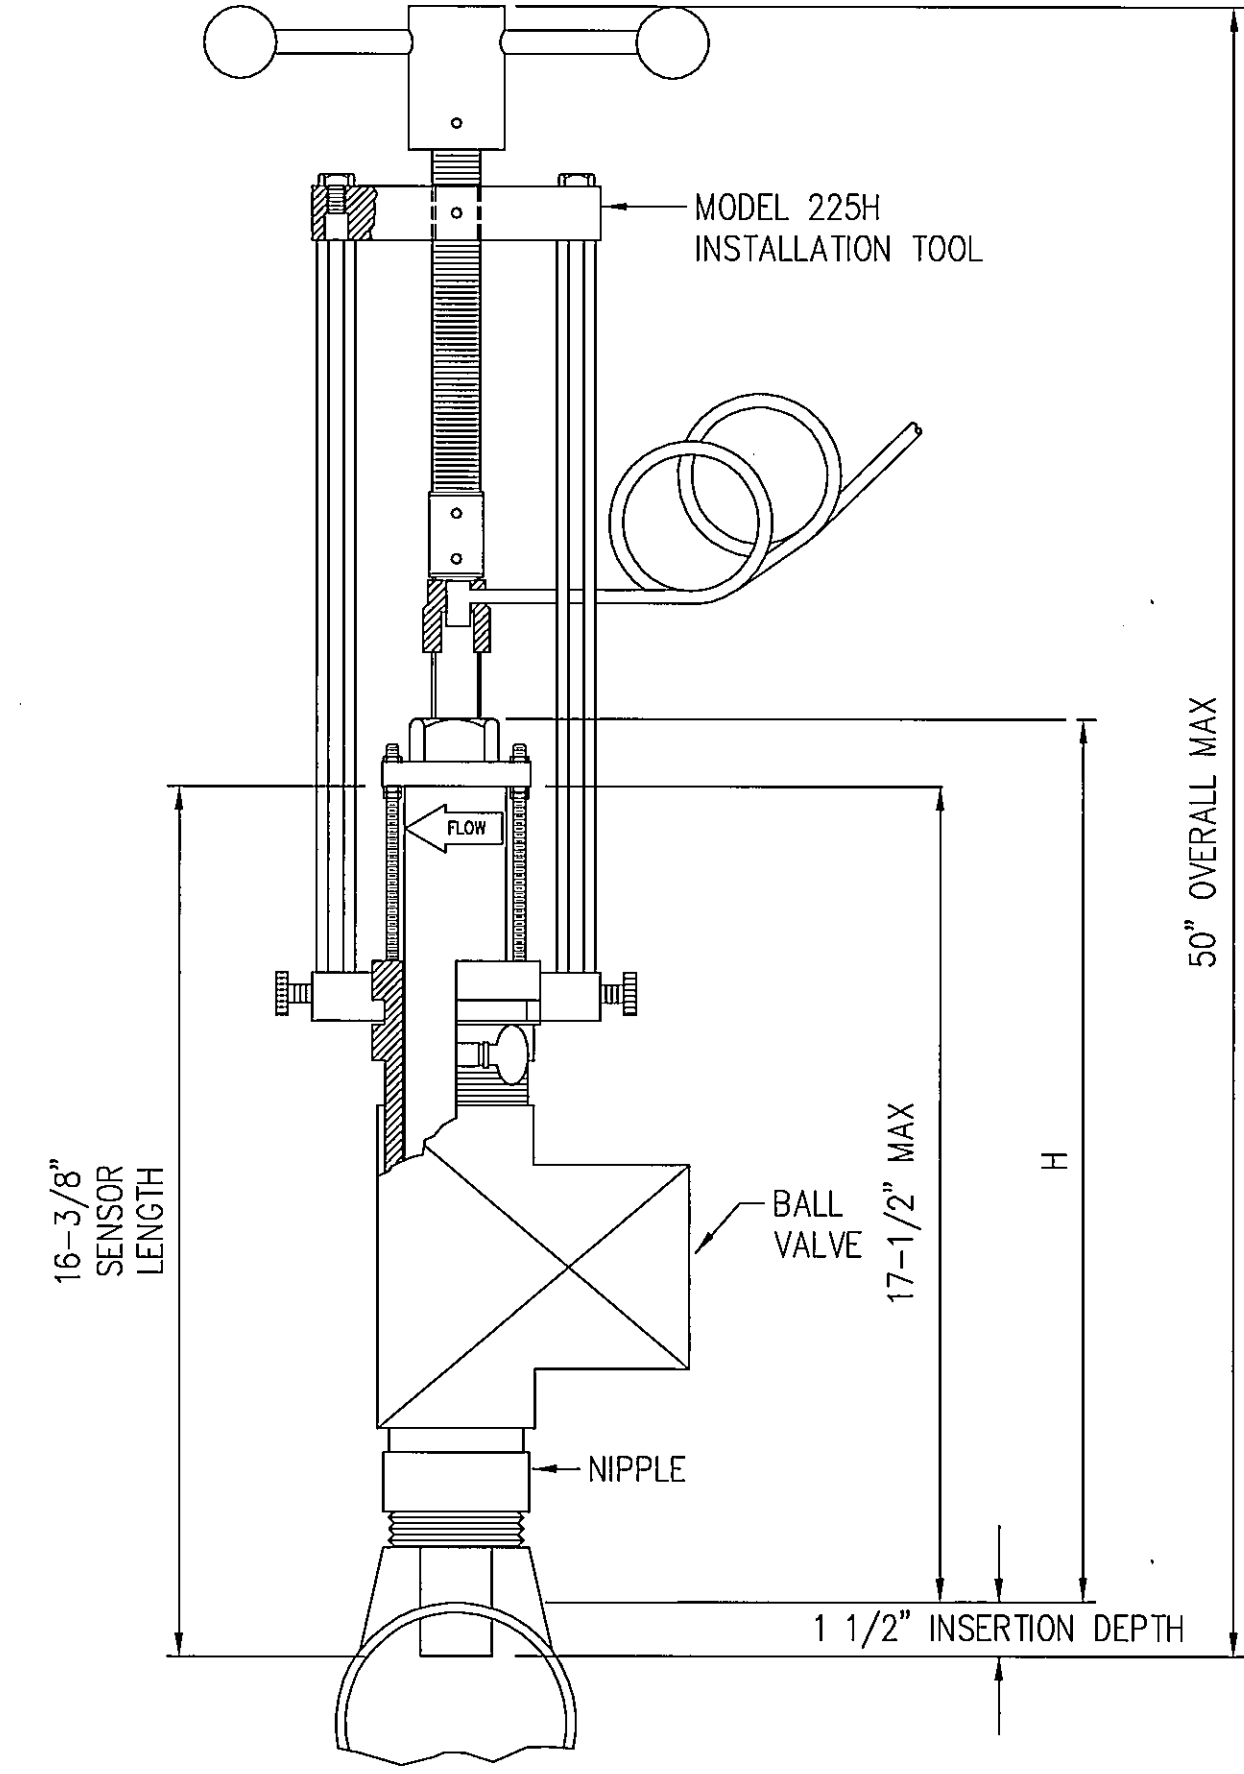

NOTES:  
1. ALL DIMENSIONS ARE FOR REFERENCE ONLY. CUTTING TOOL MAY REQUIRE ADDITIONAL CLEARANCE.  
TYPICAL FLOW SENSOR MOUNTING DETAIL.  
NOT TO SCALE

“AS-BUILT”



date DEC. 8, 1999  
designed T. MOLL  
detailed J. RECKART  
checked E.L.T.



LONDON BRIDGE BEACH PUMP HOUSE  
PLC I/O WIRING DIAGRAMS AND MISC. DETAILS  
project 97-777-1-002 contract W-183-00  
drawing E7 rev. —  
sheet 21 of 21 sheets  
file Lbbphe07.dwg 05-26-2000 16:32 M.J.N.

Scale For Microfilming  
Inches  
Millimeters

## PIPING

	GATE VALVE		BACKFLOW PREVENTER
	GLOBE VALVE		VACUUM BREAKER
	BUTTERFLY VALVE		MOISTURE SEPARATOR
	CHECK VALVE		IN-LINE FLOW METER
	STOP CHECK VALVE		SIGHT FLOW INDICATOR
	AUTOMATIC RECIRCULATION CHECK VALVE		FLEXIBLE HOSE
	PLUG VALVE		EXPANSION ELEMENT (JOINT)
	3-WAY PLUG VALVE (2-PORT)		Y-TYPE STRAINER
	3-WAY PLUG VALVE (3-PORT)		PIPE WITH HEATING CABLE
	4-WAY PLUG VALVE (4-PORT)		UNION
	3-WAY VALVE		REDUCER
	ANGLE VALVE		REMOVABLE PLUG
	RELIEF OR SAFETY VALVE		REMOVABLE CAP
	HOSE GATE DRAIN VALVE		WELDED CAP
	PINCH VALVE		BLIND FLANGE
	NEEDLE VALVE		CLEANOUT
	DIAPHRAGM VALVE		YARD HYDRANT
	BALL VALVE		AIR COCK
	SELF-CONTAINED PRESSURE REDUCING (REGULATING VALVE)		HOSE BIBB
	SURGE RELIEF VALVE		WALL HYDRANT
	KNIFE GATE VALVE		QUICK DISCONNECT COUPLING
	CORPORATION STOP		EXHAUST TO ATMOSPHERE (INSIDE)
	AIR RELEASE VALVE		EXHAUST TO ATMOSPHERE (OUTSIDE)
	VACUUM VALVE	VALVE OPERATORS	
	AIR AND VACUUM VALVE		CYLINDER
	LOCKED OPEN		DIAPHRAGM
	LOCKED CLOSED		MOTOR
			SOLENOID
			DIAPHRAGM WITH HANDWHEEL
			CHAINWHEEL
			FLOAT

## PIPING ABBREVIATIONS

CR	CONDENSATE RETURN	DIW (OR) DI	DEIONIZED WATER
CWS	CONDENSER WATER SUPPLY	DMW	DEMINERALIZED WATER
CWR	CONDENSER WATER RETURN	SP	SUMP PUMP
CHS	CHILLED WATER SUPPLY	RL	REFRIGERANT LIQUID
CHR	CHILLED WATER RETURN	RS	REFRIGERANT SUCTION
HPS	HIGH PRESSURE STEAM (50 PSIG & ABOVE)	RH	REFRIGERANT HOT GAS
LPS	LOW PRESSURE STEAM (BELOW 50 PSIG)	DIS	DEIONIZED STEAM
IA	INSTRUMENT AIR	HTWS	HIGH TEMP. WATER SUPPLY
CA	COMPRESSED AIR	HTWR	HIGH TEMP. WATER RETURN
D	DRIP	AV	AMMONIA VACUUM
BD	BLOWDOWN	AS	AMMONIA SOLUTION
DOS	DIESEL OIL SUPPLY	CV	CHLORINE VACUUM
DOR	DIESEL OIL RETURN	CG	CHLORINE GAS
FOS	FUEL OIL SUPPLY	CL	CHLORINE LIQUID
FOR	FUEL OIL RETURN	CS	CHLORINE SOLUTION
R	RELIEF LINE	RCP	REINFORCED CONCRETE PIPE
FW	FEEDWATER	D.I.P.	DUCTILE IRON PIPE
CF	CHEMICAL FEED	N.O.	NORMALLY OPENED
G	GAS (NATURAL)	NC	NORMALLY CLOSED
BP	BACKFLOW PREVENTER	NPW	NON POTABLE WATER
FP	FIRE PROTECTION	DCCV	DOUBLE CONTAINED CHLORINE VENT
GWH	GAS WATER HEATER	VC	VACUUM
IWH	INSTANTANEOUS WATER HEATER	HHWS	HOT WATER HEATING SUPPLY
FP	FIRE PROTECTION	HHWR	HOT WATER HEATING RETURN

## HEATING, VENTILATION AND AIR CONDITIONING

	COOLING COIL		DEWPOINT TRANSMITTER/SENSOR
	HEATING COIL		STATIC PRESSURE TRANSMITTER/SENSOR
	DAMPER		TEMPERATURE TRANSMITTER/SENSOR
	FLEXIBLE DUCT CONNECTION		MOTOR STARTER
	RECTANGULAR ELBOW W/ TURNING VANES (INDICATES TURNING VANES)		AIR FLOW SWITCH (SAIL SWITCH)
	TEE W/TURNING VANES		DAMPER MOTOR
	ADJUSTABLE EXTRACTING DEVICE		PNEUMATIC ELECTRIC SWITCH
	ADJUSTABLE SPLITTER DAMPER		SELECTOR SWITCH
	RISE IN RESPECT TO AIR FLOW		POSITION SWITCH
	DROP IN RESPECT TO AIR FLOW		POSITIONER
	SPLITTER DAMPER (ADJUSTABLE)		RECEIVER CONTROLLER
	SQUARE OR RECTANGULAR TO ROUND TRANSITION		ELECTRIC PNEUMATIC SWITCH
	SUPPLY OR OUTSIDE AIR DUCT SECTION		FREEZESTAT
	RETURN OR EXHAUST AIR DUCT SECTION		COMBUSTION DETECTOR
	CEILING DIFFUSER (W/BLANK OFF PLATE INDICATED)		CONTROLLER
	SIDEWALL (RA OR EA) REGISTER OR GRILLE		MANOMETER
	SIDEWALL (SA) REGISTER OR GRILLE		TEMPERATURE SENSOR
	FINNED TUBE RADIATION - LENGTH OF ELEMENT SHOWN		MAIN AIR SUPPLY
	SQUARE OR RECTANGULAR DIFFUSER		TEMPERATURE GAUGE
	ROUND DIFFUSER		HUMIDISTAT
	LINEAR OR SLOT DIFFUSER		INDICATING LIGHT
	ROUND FLEXIBLE DUCT		DIFFERENTIAL PRESSURE SWITCH
			DIFFERENTIAL PRESSURE INDICATOR
			SYMBOL - { L - LOCAL ADJ C - CONCEALED ADJ A - AVERAGING G - GUARD
			TEMPERATURE INDICATING CONTROLLER
			SAFETY VALVE ALARM
			CURRENT RELAY SWITCH
			VARIABLE SPEED CONTROLLER
AIR DISTRIBUTION DEVICE IDENTIFICATION			
	CFM		
	NECK SIZE		
	THROW - (H) HORIZ (V) VERT		
	SPEC TYPE		
	APPLICATION		













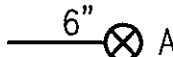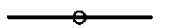

## HVAC ABBREVIATIONS



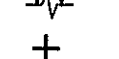
24x12	RECTANGULAR DUCT DIMENSION (1ST FIGURE IS SIDE SHOWN)	RA	RETURN AIR
24x12 OV	OVAL DUCT DIMENSION (1ST FIGURE IS SIDE SHOWN)	EA	EXHAUST AIR
12ø	ROUND DUCT DIMENSION	OA	OUTSIDE AIR
HVAC	HEATING, VENTILATION AND AIR CONDITIONING	MA	MIXED AIR
FUR	FURNACE	VD(A)	VOLUME DAMPER (SPEC TYPE)
EHC	ELECTRIC HEATING COIL	CD(A)	CONTROL DAMPER (SPEC TYPE)
TOD	TOP OF DUCT	FD(A)	FIRE DAMPER (SPEC TYPE)
BOD	BOTTOM OF DUCT	BD(A)	BACKDRAFT DAMPER (SPEC TYPE)
AHU	AIR HANDLING UNIT	MD	MANUAL DAMPER
MAU	MAKE-UP AIR UNIT	NC	NORMALLY CLOSED
CU	CONDENSING UNIT	NO	NORMALLY OPEN
ACC	AIR COOLED CONDENSING UNIT	AD	ACCESS DOOR
EF	EXHAUST FAN	RG	RETURN AIR GRILLE
F	FAN	EG	EXHAUST GRILLE
GUH	GAS UNIT HEATER	ER	EXHAUST REGISTER
EUH	ELECTRIC UNIT HEATER	SR	SUPPLY REGISTER
HWU	HOT WATER UNIT HEATER	RH	REHEAT
HWP	HOT WATER PANEL HEATER	L	LOUVER
EC	ELECTRIC CONVECTOR	RV	RELIEF VENT
P	PUMP	TA	TRANSFER AIR
OC	ODOR CONTROL	VCP	VENTILATION CONTROL PANEL
		CLDP	CHLORINE LEAK DETECTION CONTROL PANEL
		SA	SUPPLY AIR
		RH	RELATIVE HUMIDITY




## PLUMBING



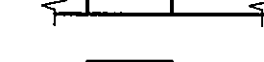
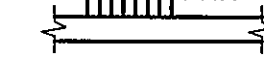
	SH	SHOWER		4\"/>	FLOOR DRAIN - SIZE - SPEC TYPE
	MB	MOP BASIN		4\"/>	EQUIPMENT DRAIN - SIZE - SPEC TYPE
	LS	LABORATORY SINK		4\"/>	ROOF DRAIN - SIZE - SPEC TYPE
	EWC	ELECTRIC WATER COOLER		WHA	WATER HAMMER ARRESTOR
	WH	WATER HEATER		P&T	PRESSURE/TEMPERATURE RELIEF VALVE
	WC	WATER CLOSET (FLUSH VALVE TYPE)			COLD WATER (CW)
	WC	WATER CLOSET (TANK TYPE)			HOT WATER (HW)
	U	URINAL			DEIONIZED WATER (DIW)
	L	LAVATORY			HOT WATER RECIRCULATING (HWR)
	ES/EW	EMERGENCY SHOWER AND EYEWASH			GAS (G)
	ES	EMERGENCY SHOWER			COMPRESSED AIR (CA)
	EW	EMERGENCY EYEWASH			SOIL OR WASTE (ABOVE GRADE)
	CS	CUP SINK			SOIL OR WASTE (BELOW GRADE)
	AC	AIR COMPRESSOR			VENT
	AD	AIR DRYER			VTR VENT THROUGH ROOF
	VAC	VACUUM PUMP			RD ROOF DRAIN (ABOVE GRADE)
					RD ROOF DRAIN (BELOW GRADE)
PLUMBING RISER IDENTIFICATION					




## FIRE PROTECTION

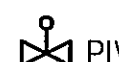	6" ASR	AUTOMATIC SPRINKLER RISER
		STANDARD UPRIGHT SPRINKLER HEAD
		PENDANT TYPE SPRINKLER HEAD
		OPEN SPRINKLER HEAD (NO FUSIBLE LINK)
		PENDANT HEAD MOUNTED ON CEILING
		UPRIGHT SPRINKLER ON RISER NIPPLE
		SIDEWALL SPRINKLER HEAD (H) HORIZONTAL
		SPRAY (FOG) VALVE
	AV	ALARM VALVE
	DPV	DRY PIPE VALVE
		DRY PIPE VALVE W/ACCELERATOR OR EXHAUSTER
	(DV)	DELUGE VALVE
	(PV)	PREACTION VALVE
	(FV)	FLOW CONTROL VALVE

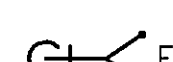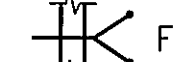VALVE OPERATORS	
	PIV POST INDICATOR VALVE
	WALL TYPE POST INDICATOR VALVE (S) SUPERVISED (R) RECESSED
	OS & Y OUTSIDE SCREW AND YOKE VALVE (S) SUPERVISED

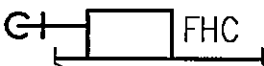FIRE DEPARTMENT PUMPER CONNECTIONS	
	FDPC YARD TYPE FREE STANDING
	FDPC WALL MOUNTED
	FDPC FLUSH MOUNTED

FIRE HOSE STATIONS	
	FHC IN SURFACE MOUNTED CABINET
	FHC IN RECESSED CABINET
	FHR FIRE HOSE RACK
	FHRL FIRE HOSE REEL

FIRE EXTINGUISHERS	
	FE SURFACE MOUNTED
	FHC IN RECESSED CABINET
	FHC IN SURFACE MOUNTED CABINET

## ALARM AND DETECTION EQUIPMENT

	S	SMOKE DETECTOR		F	FIRE ALARM MANUAL PULL STATION
	I	IONIZATION DETECTOR			CENTRIFUGAL FIRE PUMP
	T	THERMAL DETECTOR		(D)	DIESEL DRIVE
	R	RATE COMPENSATING DETECTOR		(E)	ELECTRIC DRIVE
	W	CONTINUOUS WIRE DETECTOR			VERTICAL TURBINE FIRE PUMP
	RR	RATE OF RISE DETECTOR		(D)	DIESEL DRIVE
	(E)	ELECTRIC		(E)	ELECTRIC DRIVE
	(P)	PNEUMATIC		PFM	PUMP FLOW METER
	P	PHOTOELECTRIC DETECTOR			PUMP HOSE TEST HEADER
	FAP	FIRE ALARM CONTROL PANEL		2 1/2\"/>	NUMBER REQUIRED
	FAA	FIRE ALARM ANNUNCIATOR			WALL HYDRANT (WH) FLUSH TYPE (FWH)
		ELECTRIC ALARM BELL		2 - 2 1/2\"/>	OUTLETS (FDPC) W/FIRE DEPT. PUMPER CONNECTION (HV) W/HOSE VALVES
	HA	HORN			
	SA	SIREN			

## INSTRUMENTS

	FLOW METERING ELEMENT		P - PRESSURE GAUGE
	GG - GAUGE GLASS		PC - PRESSURE CONTROLLER
	LI - LEVEL INDICATOR		PS - PRESSURE SWITCH
	LC - LEVEL CONTROLLER		PX - PRESSURE TRANSMITTER
	LLS - LIQUID LEVEL SWITCH		V - VACUUM GAUGE
	LX - LEVEL TRANSMITTER		P - DIFFERENTIAL PRESSURE GAUGE
	FI - FLOW INDICATOR		PC - DIFFERENTIAL PRESSURE CONTROLLER
	FC - FLOW CONTROLLER		PS - DIFFERENTIAL PRESSURE SWITCH
	FS - FLOW SWITCH		PX - DIFFERENTIAL PRESSURE TRANSMITTER
	FX - FLOW TRANSMITTER		S - SAMPLE CONNECTION
	T - THERMOMETER		CONTROL FUNCTION LINE
	TC - THERMOCOUPLE		AE - ANALOG ELEMENT
	TCT - TEMPERATURE CONTROLLER		AC - ANALOG CONTROLLER
	TS - TEMPERATURE SWITCH		HS - HAND SWITCH
	TX - TEMPERATURE TRANSMITTER		
	RTD - RESISTANCE TEMPERATURE DETECTOR		
	TC - TEST CONNECTION		
	PT - PRESSURE TAP		

## GENERAL LEGEND

CONNECT TO EXISTING

## NOTE:

THIS IS A STANDARD MECHANICAL LEGEND AND NOT ALL ITEMS OR EQUIPMENT AS DESIGNATED HEREON ARE USED ON THIS PROJECT.

no. date by revision

8-15-01 JDF As-Built



date DEC. 16, 1999 detailed R.L. BENNETT  
designed R.L. BENNETT checked R.G.H.




LONDON BRIDGE BEACH PUMP HOUSE

MECHANICAL LEGEND

project 97-777-1-002 contract W-183-00  
drawing M1 rev. -  
sheet 12 of 21 sheets  
file Lbbphtml.dwg 04-19-2000 08:19 RLB




COPYRIGHT © 2000 BURNS AND McDONNELL ENGINEERING COMPANY, INC.

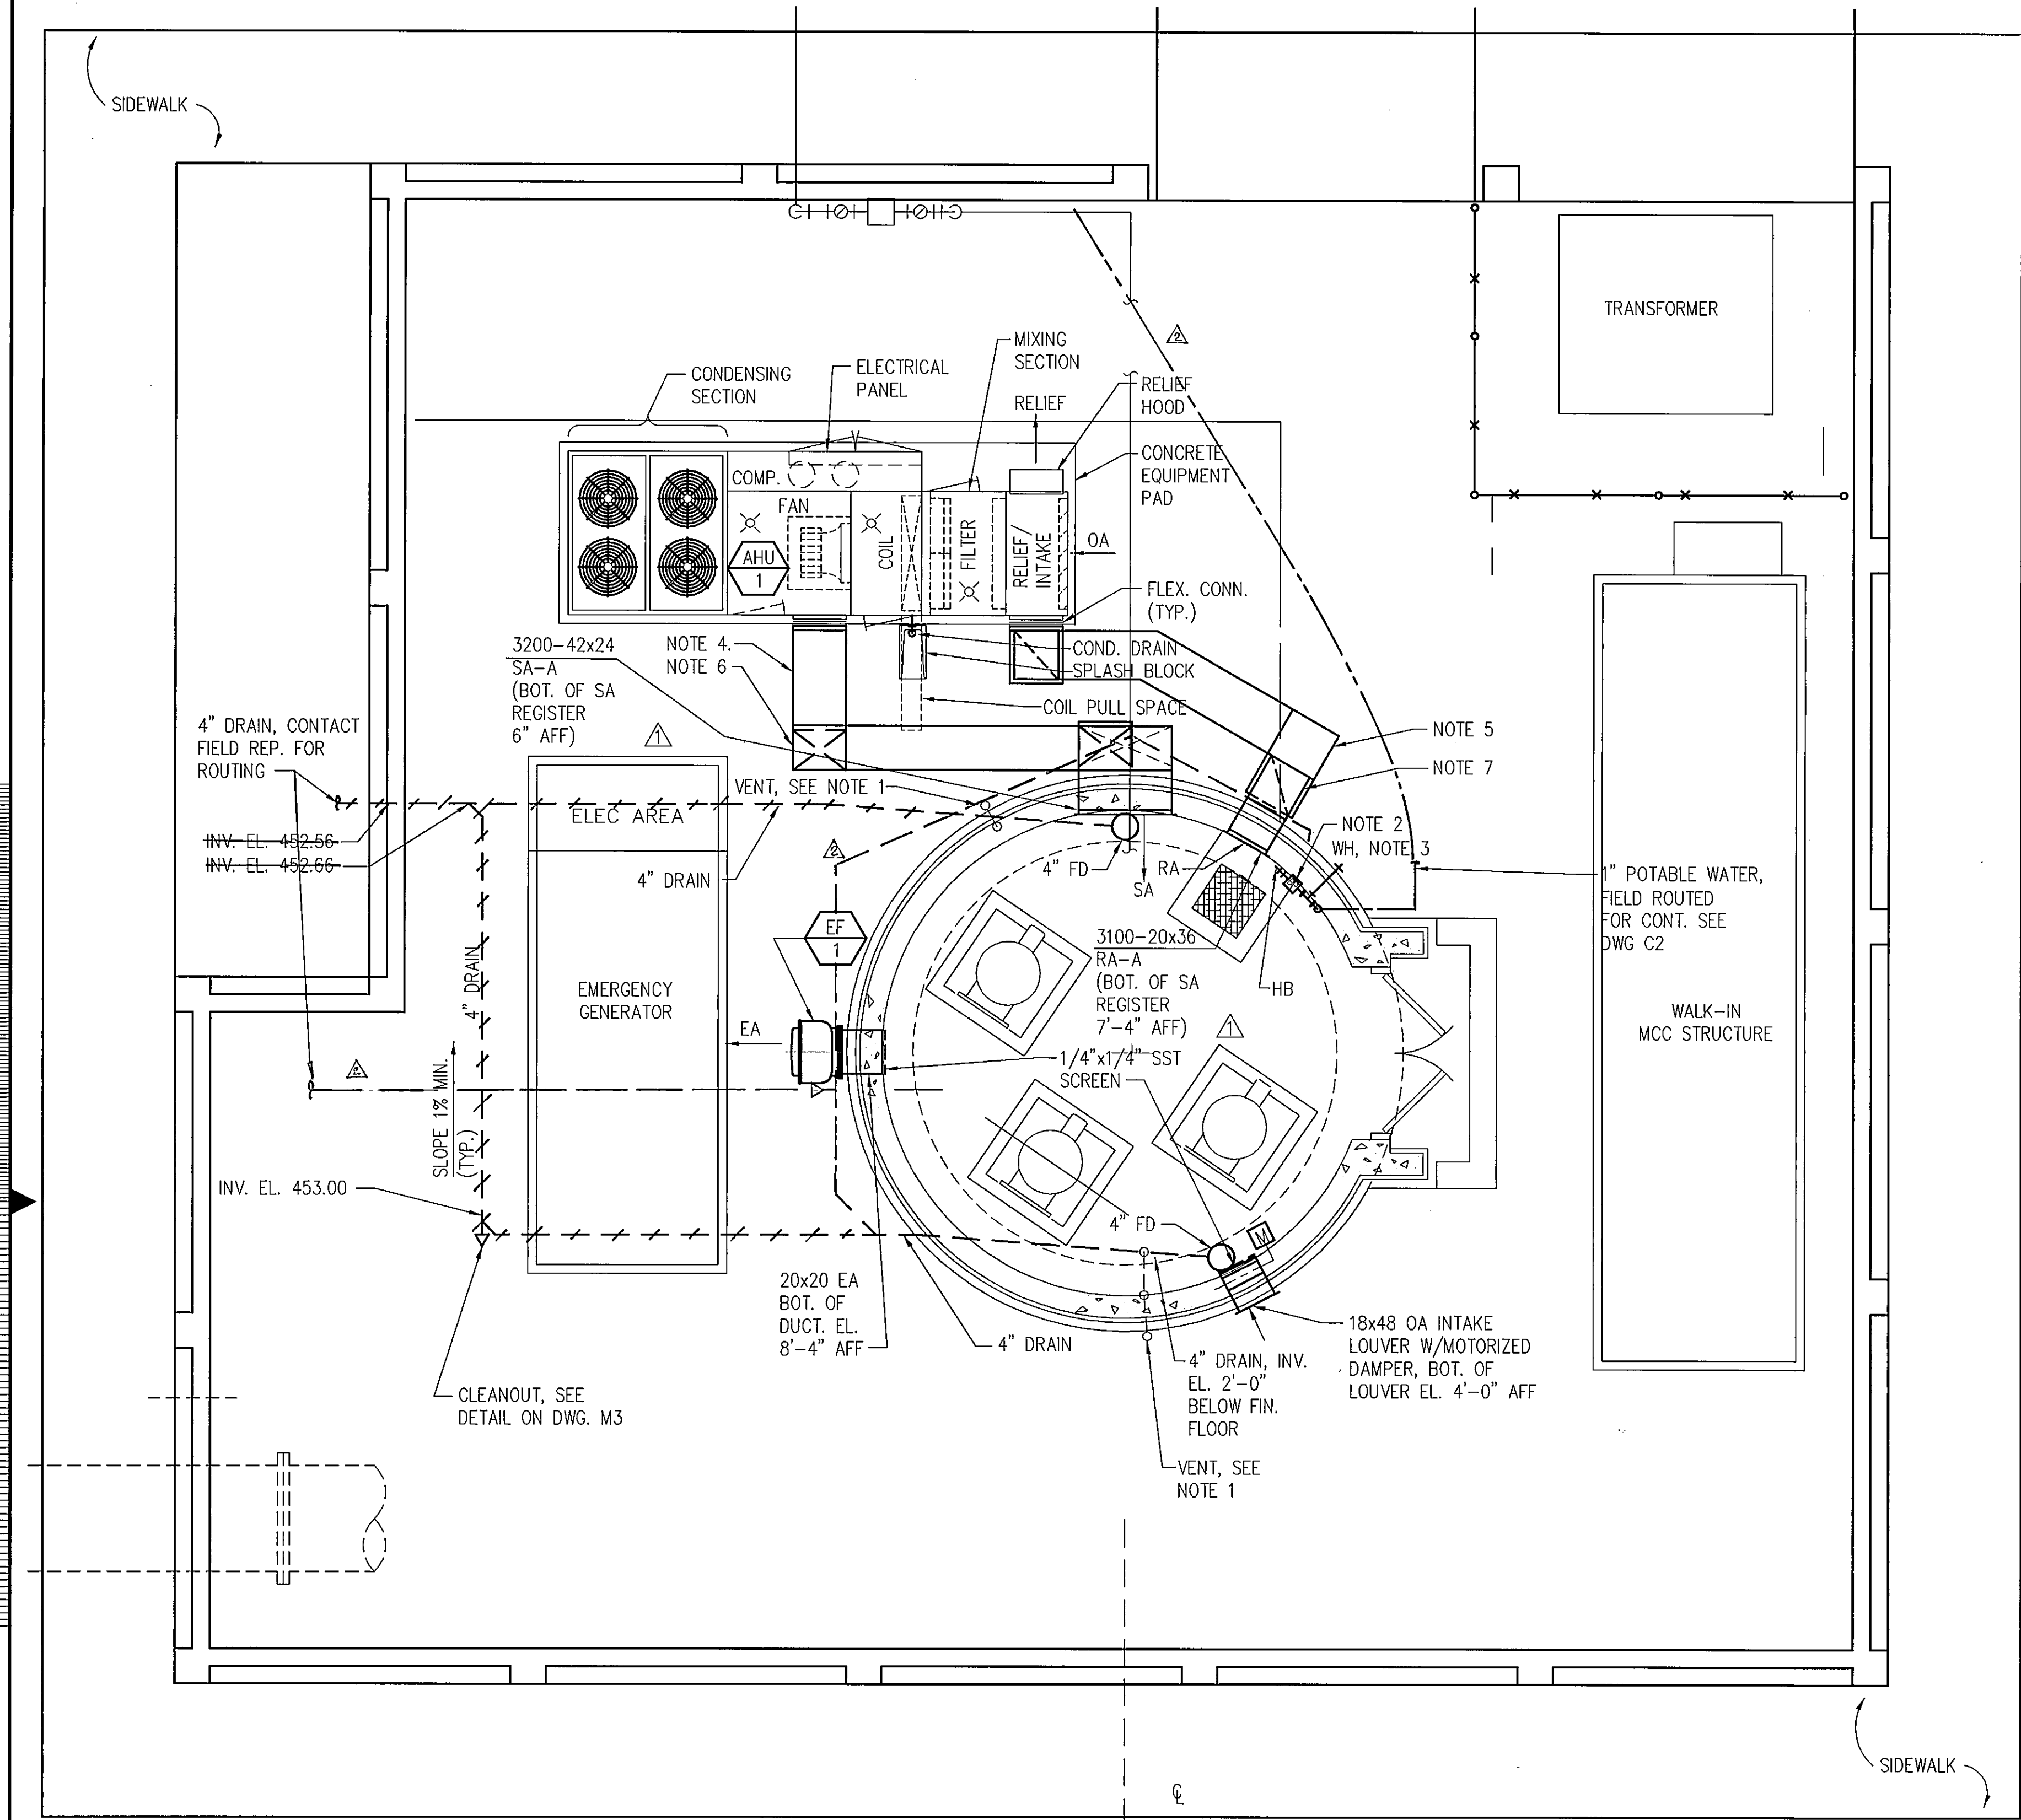


NOTES:

1. FLOOR DRAIN VENT TO PENETRATE PUMP HOUSE WALL AT 8'-6" ABOVE FINISHED FLOOR, TOP OF VENT ON OUTSIDE WALL SHALL BE 9'-6" ABOVE FINISHED FLOOR. (TYPICAL 2 PLACES)
2. 1" BACKFLOW PREVENTER, ? EL. 3'-6" ABOVE FINISHED FLOOR.
3. WALL HYDRANT (WH) AND HOSE BIBB (HB) ? EL. AT 3'-6" ABOVE FINISHED FLOOR.
4. 24x18 SA DUCT, BOTTOM OF DUCT EL.  $\pm 3'-9"$  ABOVE CONC. EQUIP. PAD.
5. 24x18 RA DUCT, BOTTOM OF DUCT EL.  $\pm 8"$  ABOVE CONC. EQUIP. PAD.
6. 24x18 90° ELBOW DOWN. TRANSITION FROM 24x18 TO 42x18.
7. 24x18 90° ELBOW UP. TRANSITION FROM 24x18 TO 20x20.

MECHANICAL FLOOR PLAN  
SCALE IN FEET

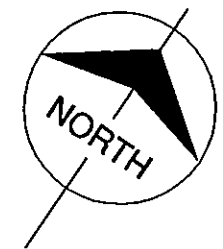

no.	date	by	revision
1	7-25-01	JJM	(A1 -G8) REVISE DRAWING TO ACCOMMODATE COLLECTOR WELL "AS BUILT" CONDITION
2	8-15-01	JDF	REVISED WATER & DRAIN LINES
3	8-15-01	JDF	AS-BUILT

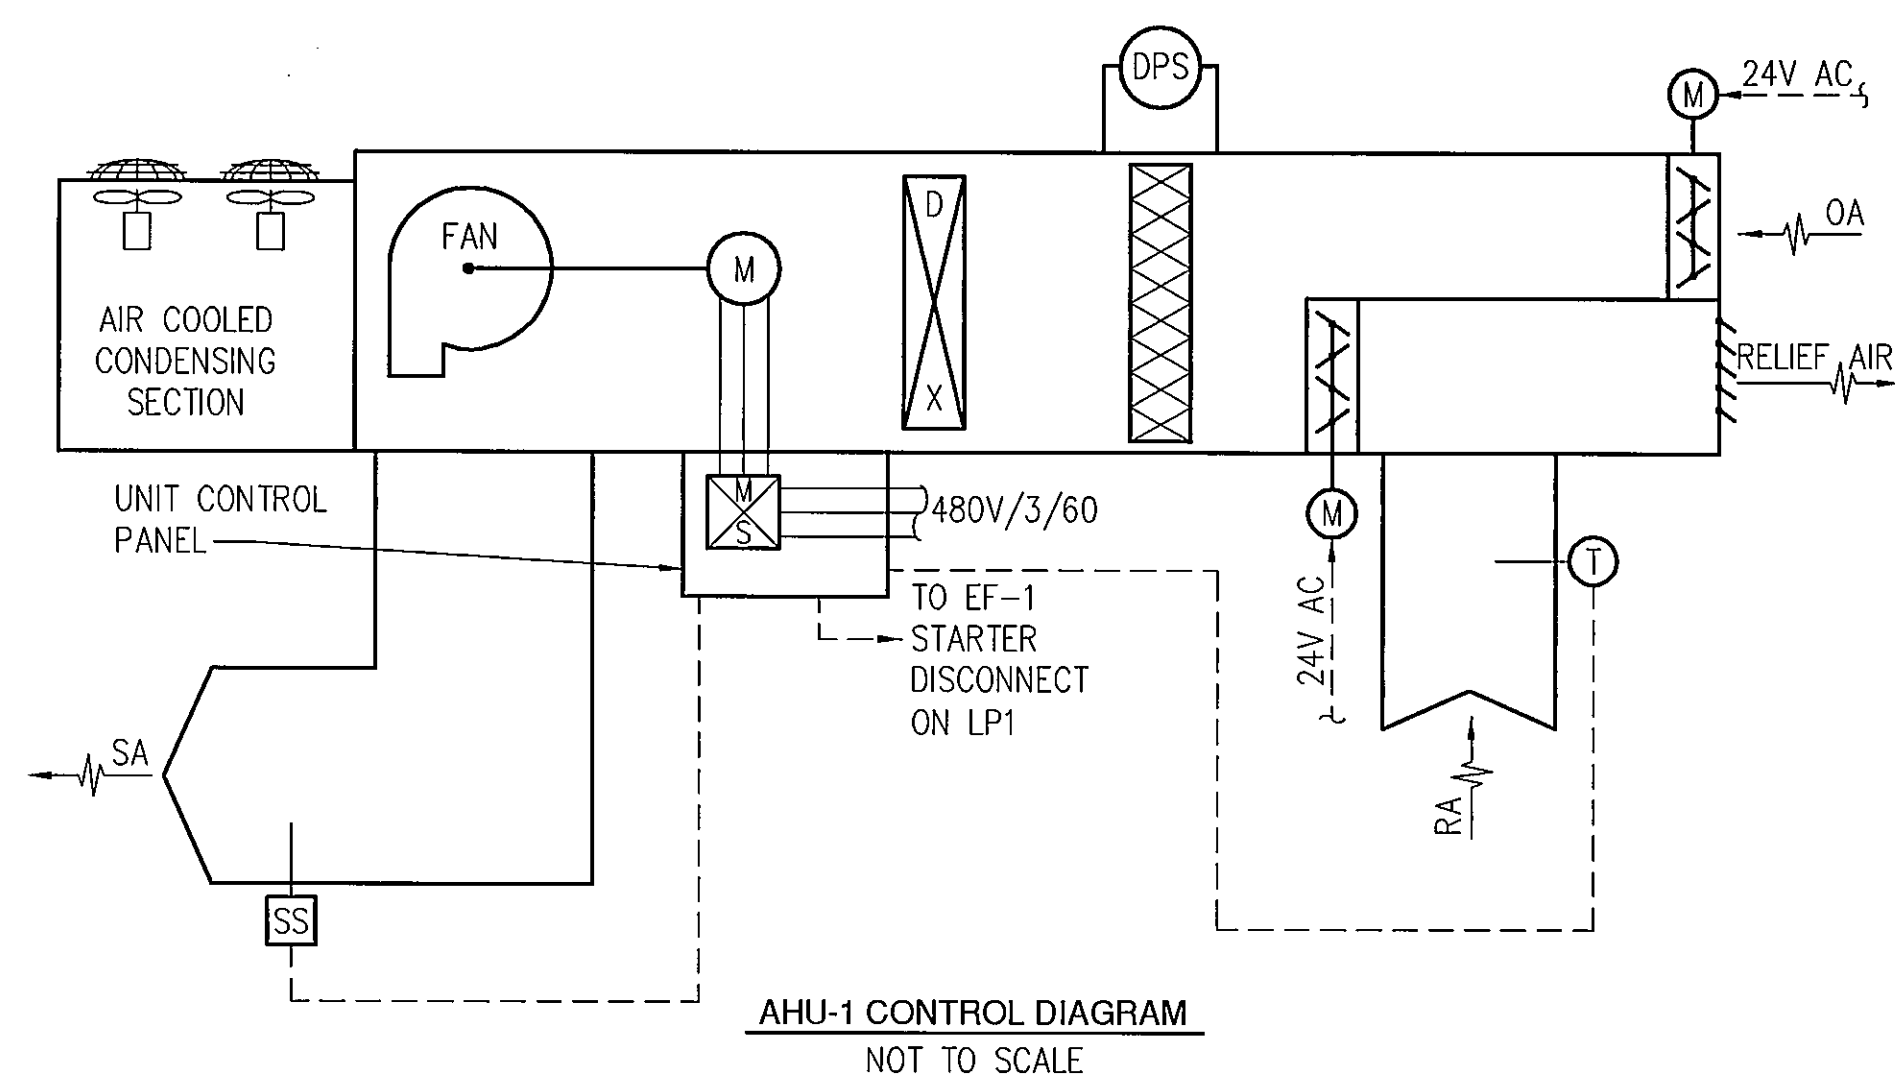

DESCRIPTION:

SYSTEM SHALL BE CONSTANT VOLUME, COOLING/VENTILATION AIR HANDLING UNIT TO MAINTAIN SUPPLY AIR TEMPERATURE OF 95°F (ADJ.) UNIT SHALL BE CONTROLLED BY A ROOM THERMOSTAT.

SEQUENCE OF OPERATION

COOLING:

1. GENERAL:

ALL SETPOINTS SHALL BE ADJUSTABLE. CONTROLS SHALL BE PROVIDED BY UNIT MOUNTED CONTROLLER.

2. AHU OPERATION:

THE SUPPLY FAN SHALL OPERATE CONTINUOUSLY. OUTDOOR AIR DAMPER SHALL BE IN MINIMUM OPEN POSITION. AS RETURN AIR TEMPERATURE RISES ABOVE COOLING SETPOINT OF 95°F, OUTDOOR AIR DAMPER SHALL MODULATE OPEN AND THE RETURN AIR DAMPER SHALL MODULATE CLOSED TO SATISFY RETURN AIR TEMPERATURE. OUTDOOR AIR DAMPER SHALL MODULATE TO MINIMUM OPEN POSITION WHEN OUTDOOR AIR ENTHALPY IS GREATER THAN SETPOINT ENTHALPY (REFERENCE ENTHALPY ECONOMIZER). ON A CONTINUED RISE IN RETURN AIR TEMPERATURE, FIRST STAGE OF MECHANICAL COOLING SHALL BE ENERGIZED. MECHANICAL COOLING SHALL BE STAGED UP AS RETURN AIR TEMPERATURE CONTINUES TO RISE. ON A DROP IN SPACE TEMPERATURE THE REVERSE SEQUENCE SHALL OCCUR.

SAFETY CONTROLS:

SUPPLY FAN


1. SUPPLY AIRFLOW SWITCH, SS, MAKES ON SUPPLY AIR SHUT OFF. EF-1 IS ENERGIZED.
2. SUPPLY AIRFLOW SWITCH, SS, OPENS ON SUPPLY AIRFLOW. EF-1 IS DE-ENERGIZED.

DIRTY FILTER


1. DIFFERENTIAL PRESSURE SWITCH, DPS, MAKES ON INCREASING STATIC PRESSURE WHEN DIFFERENTIAL PRESSURE ACROSS THE 30% ASHRAE EFFICIENCY FILTER REACHES 1.0 IN. W.C. (ADJ.). "DIRTY 30% FILTER" INDICATION IS ENERGIZED ON THE UNIT CONTROL PANEL.

NOTE:


1. EXHAUST FAN, EF-1, SHALL BE CONTROLLED THROUGH THE FAN COMBINATION STARTER. WHEN THE H-O-A IS IN THE AUTOMATIC (A) POSITION, THE FAN SHALL RUN WHEN A PERMISSIVE START IS RECEIVED FROM THE AIR HANDLING UNIT. WHEN H-O-A IS PLACED IN THE HAND (H) POSITION, THE FAN SHALL RUN CONTINUOUSLY.

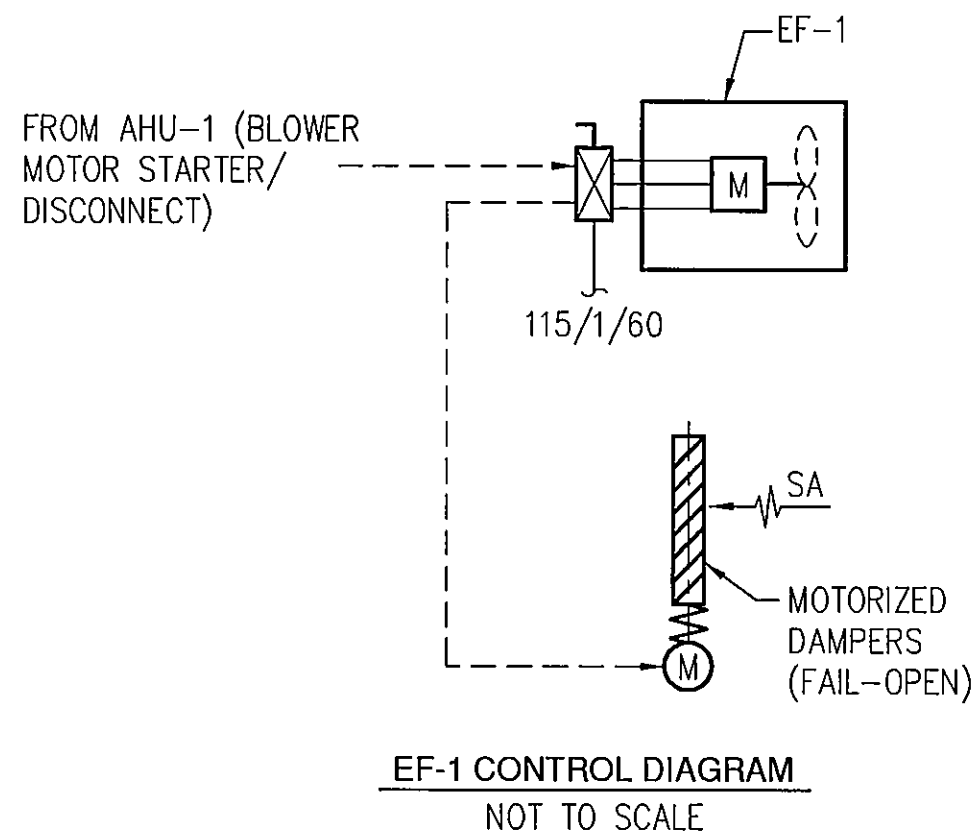

"AS-BUILT"

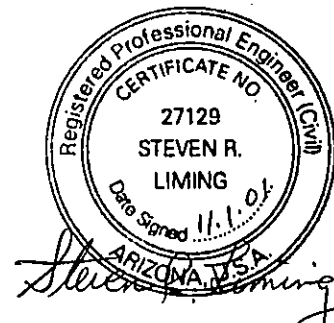

date NOV. 12, 1999  
designed R.L. BENNETT  
checked R.G.H.


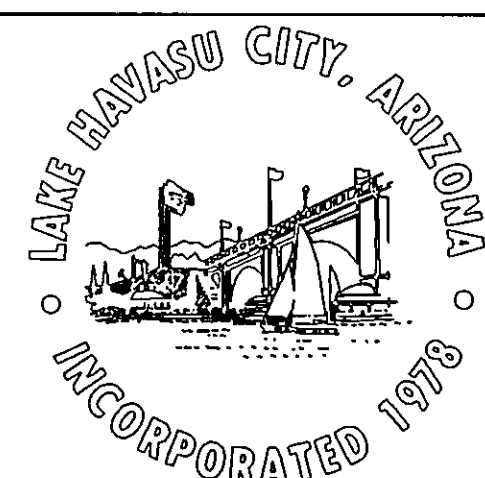


LONDON BRIDGE BEACH PUMP HOUSE  
HVAC AND PLUMBING FLOOR PLAN  
AND HVAC CONTROL SEQUENCE  
OF OPERATION DIAGRAMS



project 97-777-1-002  
drawing M2  
sheet 13 of 21 sheets  
file Lbbphm01.dwg 06-14-2000 13:34 LJM

Copyright © 2000 Burns and McDonnell Engineering Company, Inc.




no.	date	by	revision
	8-15-01	JDF	As-Built

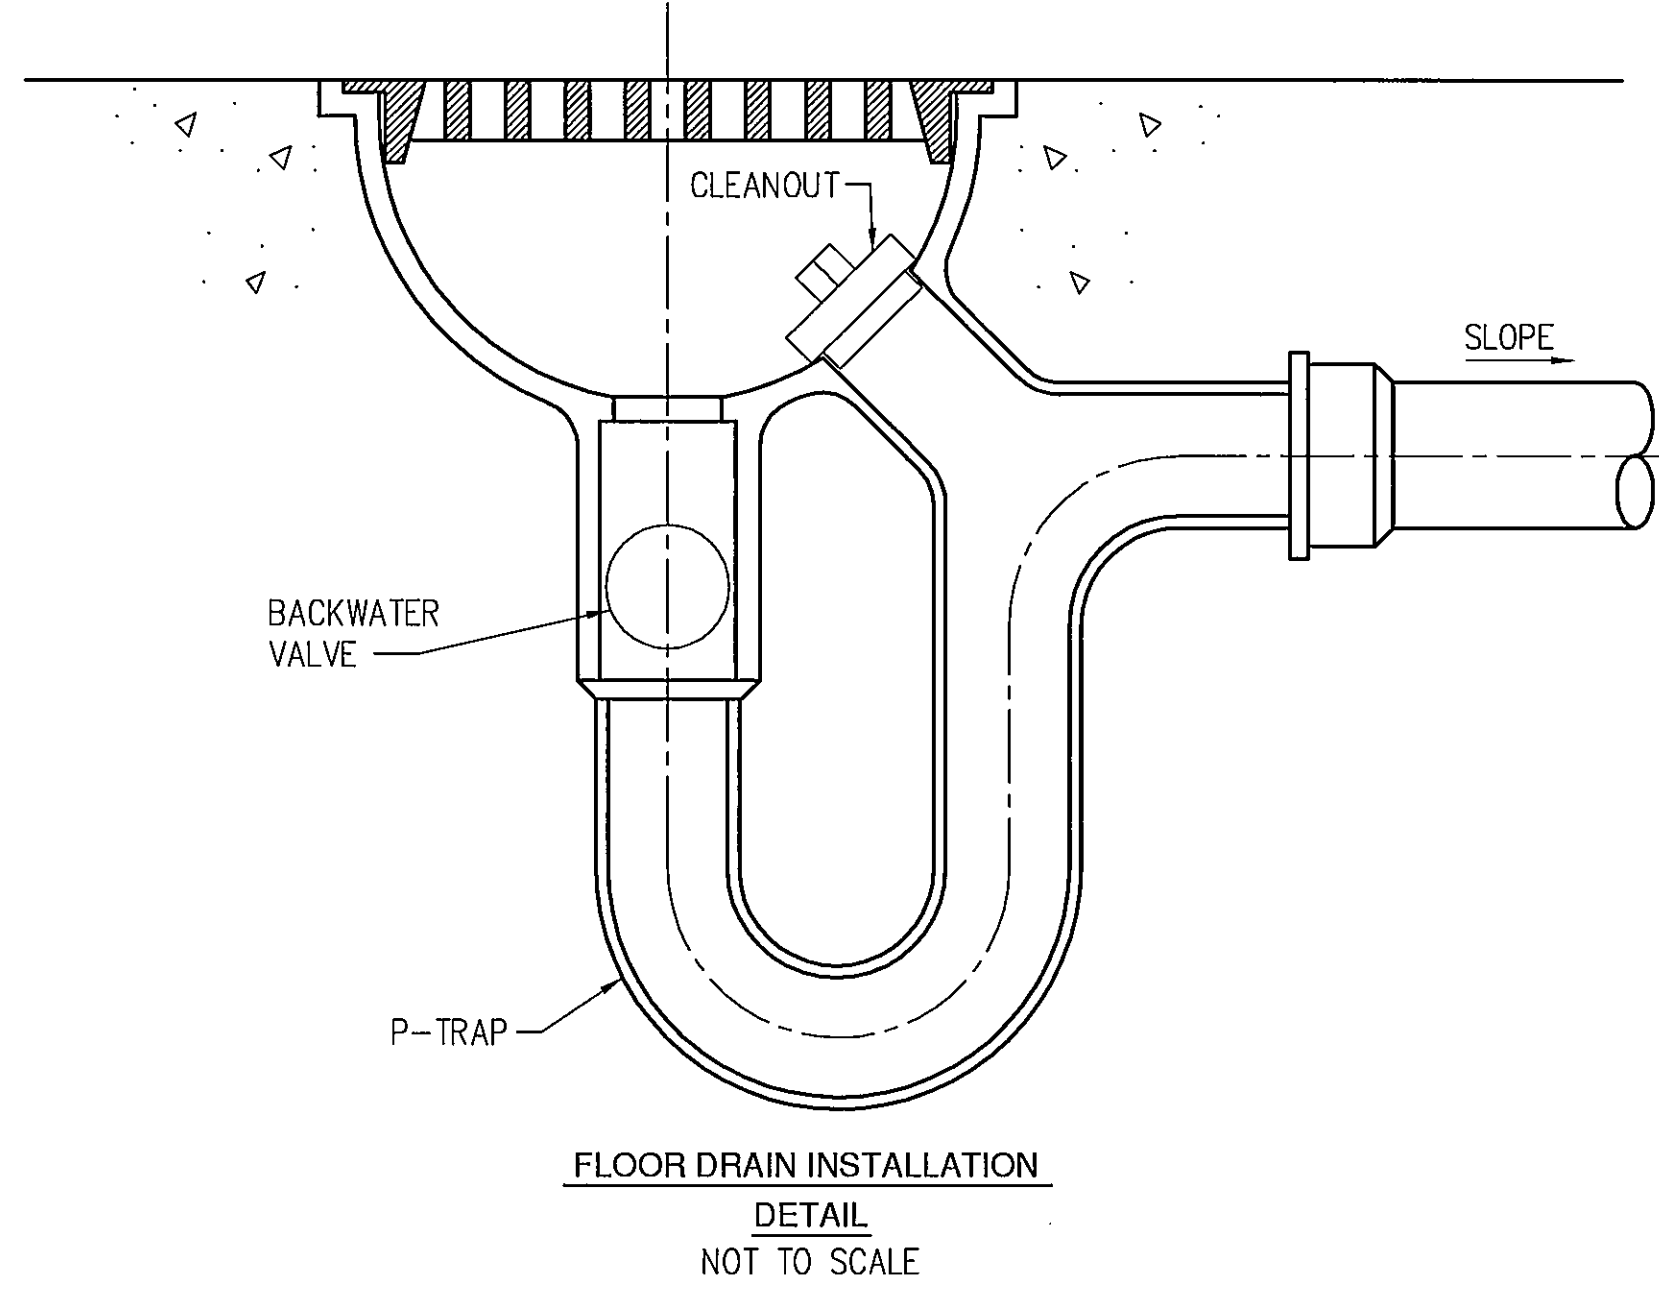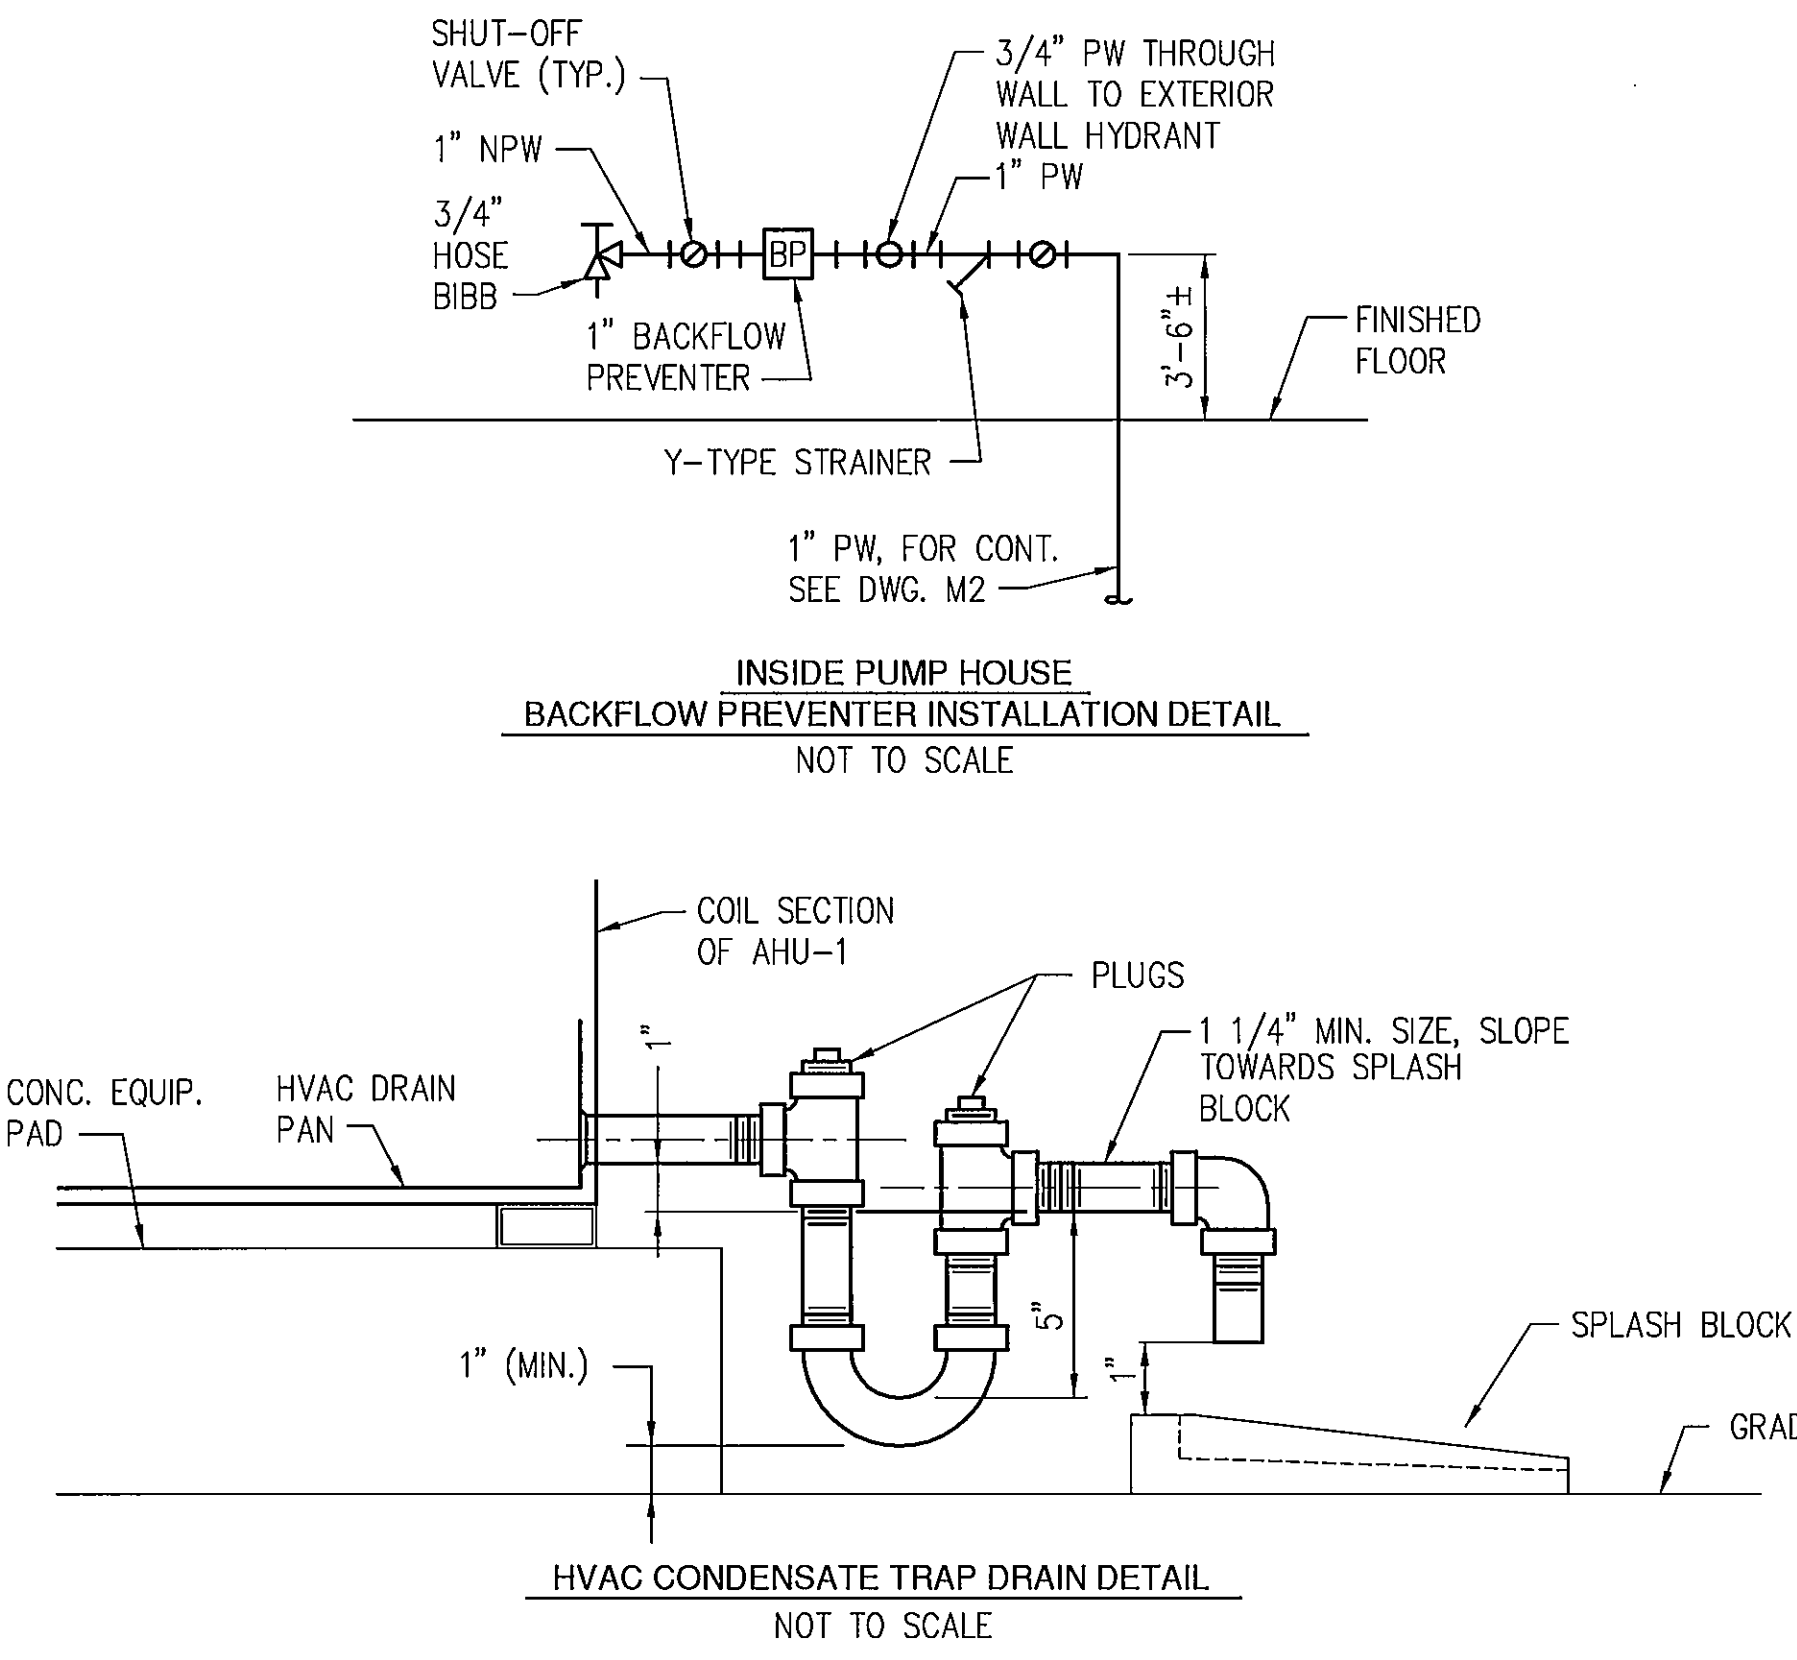

EXHAUST FAN (EF) SCHEDULE	
FAN NUMBER	EF-1
LOCATION DRAWING NUMBER	M2
MANUFACTURER	GREENHECK
MODEL NUMBER	GWB-14
CFM @ STANDARD CONDITIONS	1,500
STATIC PRESSURE (INCHES W.C.)	0.375
APPROX WHEEL RPM	1090
APPROX MOTOR H.P.	1/4
MAX. SONES	7.4
ELECTRICAL DATA (VOLTS/PHASE/HERTZ)	120/1/60
DRIVE TYPE	BELT
FAN TYPE	DOVE
FAN MOUNTING	WALL MOUNTED

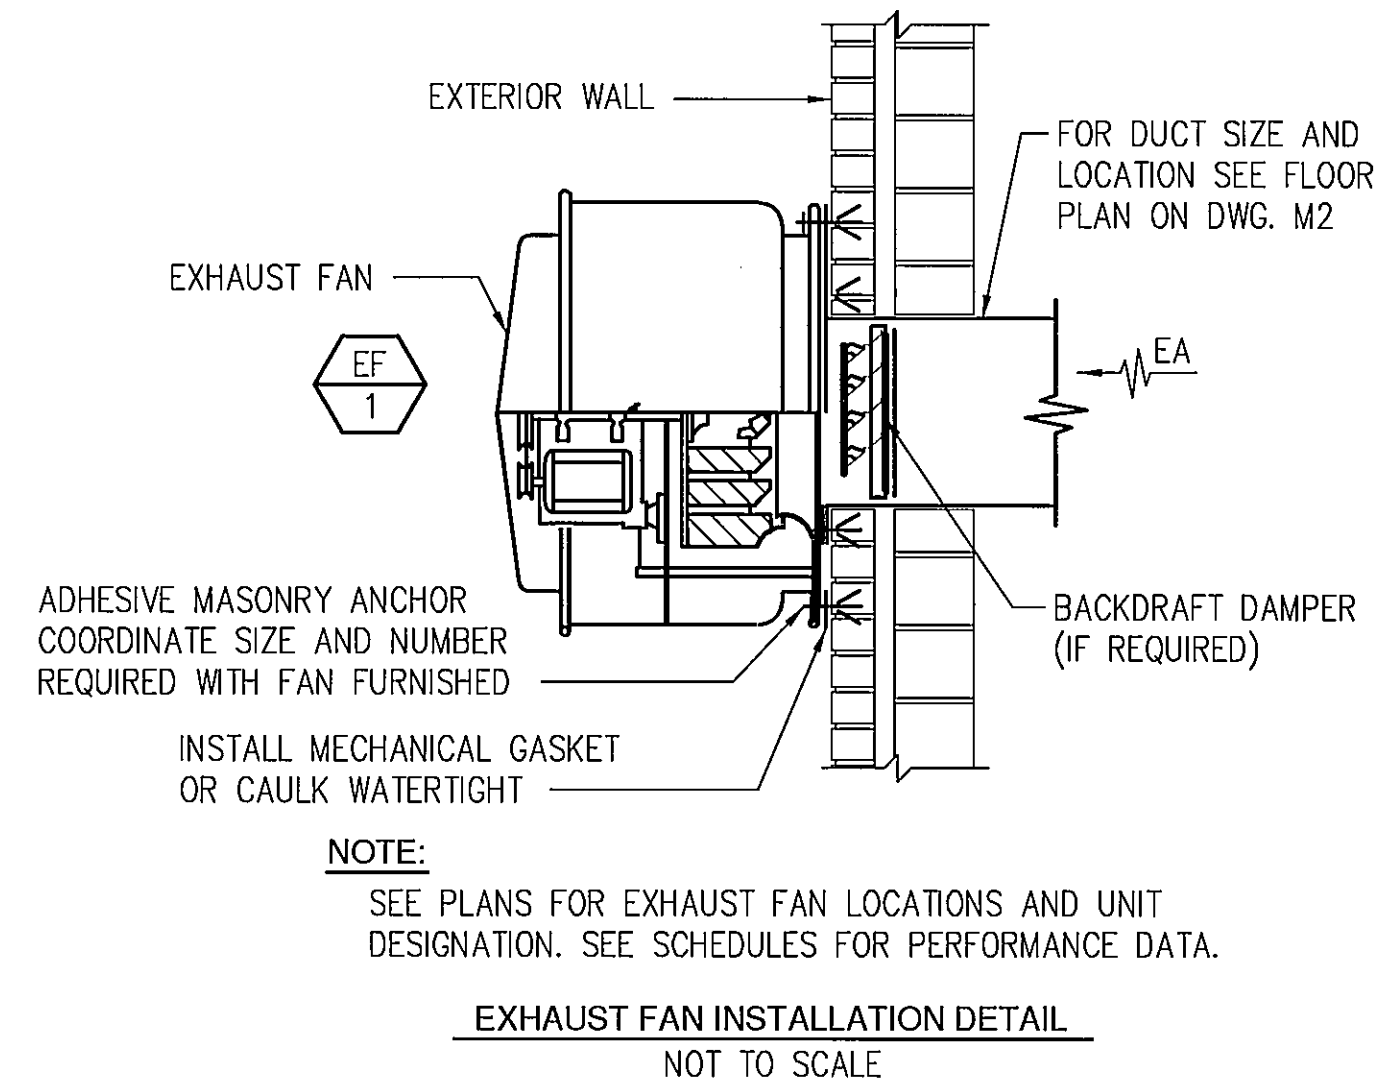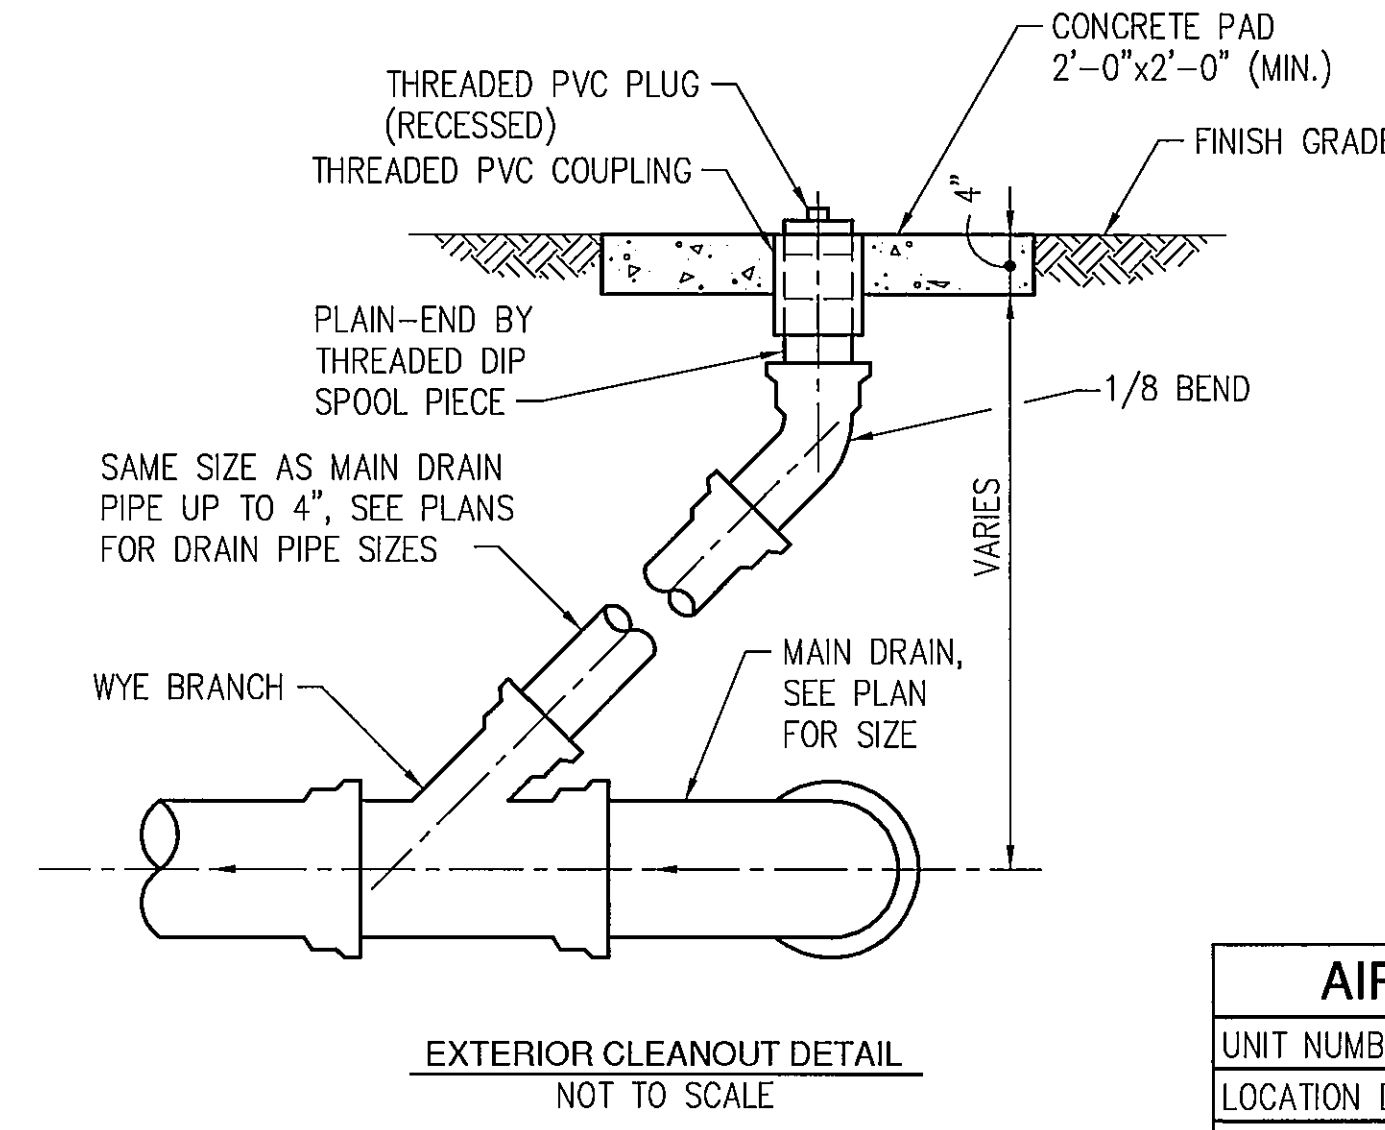

AIR HANDLING UNIT (AHU) SCHEDULE	
UNIT NUMBER	AHU-1
LOCATION DRAWING NUMBER	M2
MANUFACTURER	ENGINEERED AIR
FAN DATA:	
SUPPLY:	
MODEL NUMBER	FWB-152
TOTAL FLOW (SCFM)	3,200
OUTSIDE AIR FLOW (SCFM)	500
EXTERNAL STATIC PRESSURE (IN. W.C.)	1.50
APPROX. MOTOR H.P.	5
ELECTRICAL DATA (VOLTS/PHASE/HERTZ)	460/3/60
RETURN:	
TOTAL FLOW (SCFM)	3,100
COOLING COIL DATA:	
TYPE	DX
MAX. COIL FACE VELOCITY (FPM)	500
TOTAL COIL LOAD (BTUH)	152,667
TOTAL SENSIBLE COIL LOAD (BTUH)	152,562
ENTERING AIR TEMP DB / WB (F)	98.4/67
LEAVING AIR TEMP DB / WB (F)	55/51
NUMBER OF COMPRESSORS	2
NUMBER OF CONDENSER FANS	4
AMBIENT DESIGN TEMPERATURE (F)	125

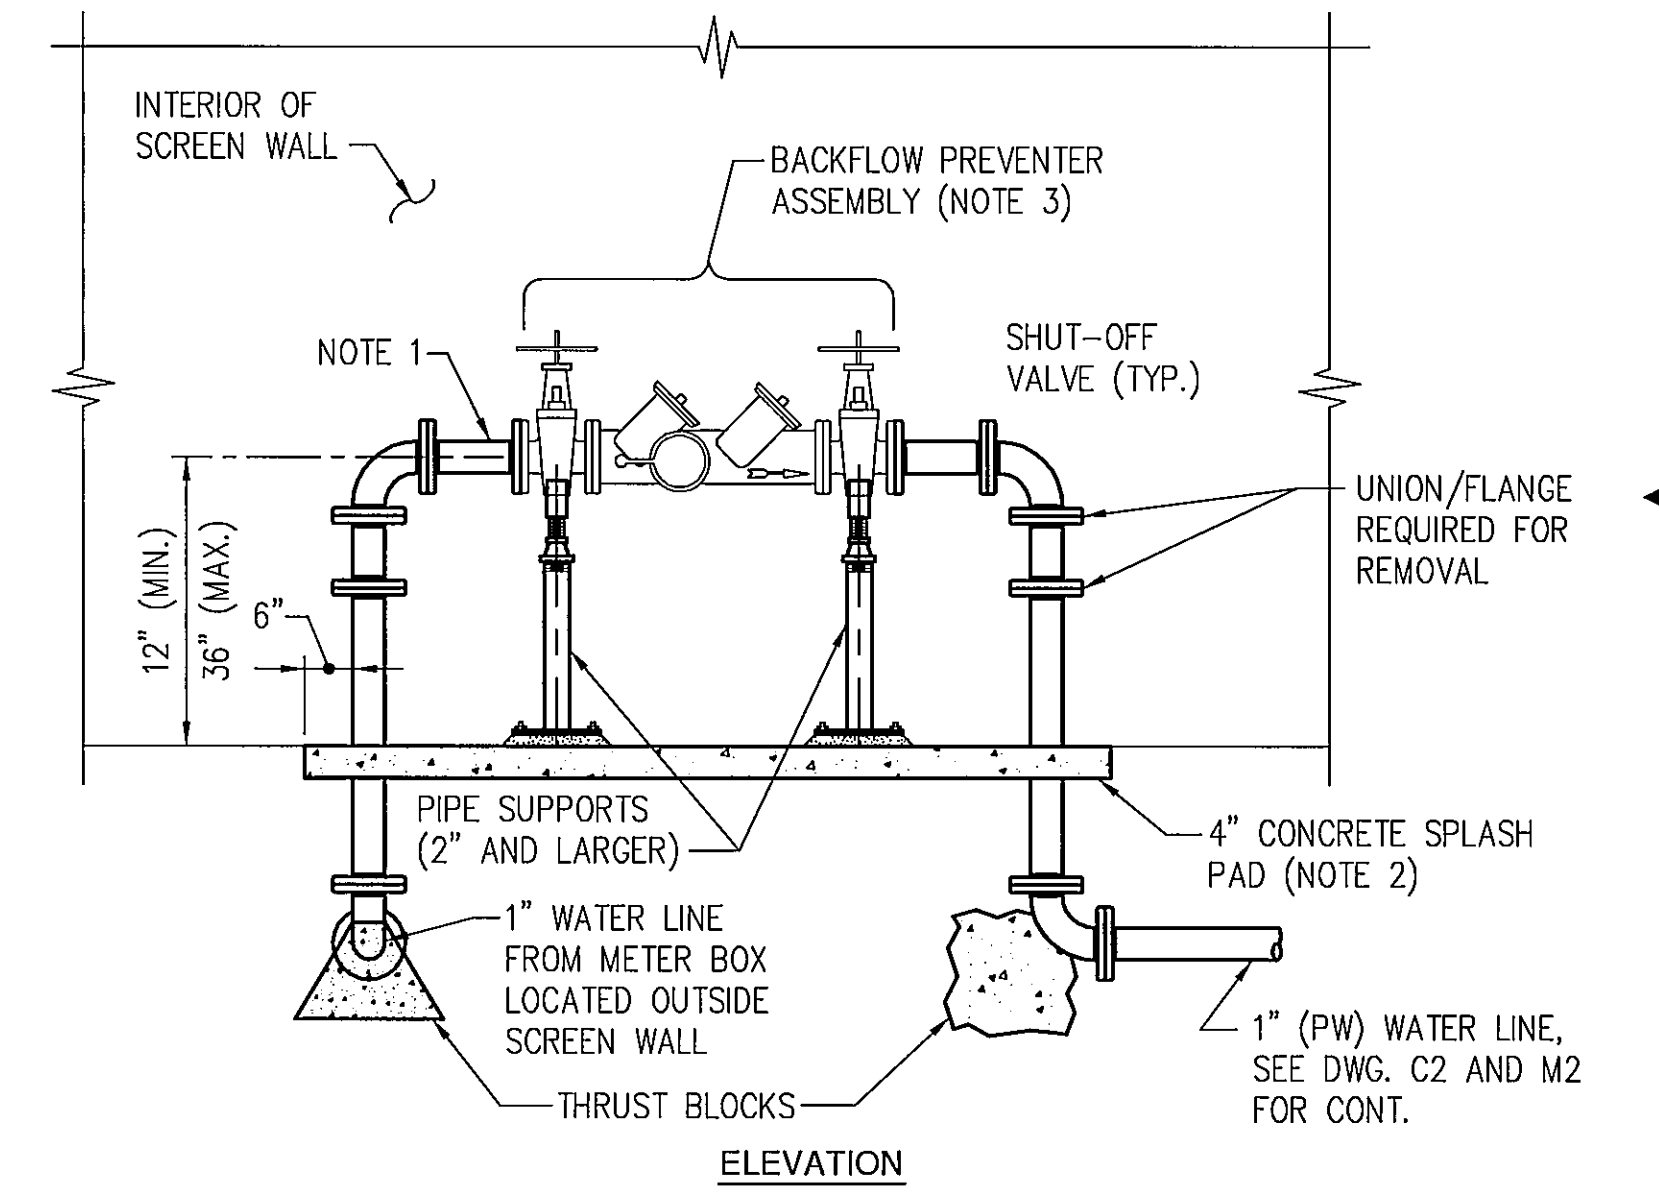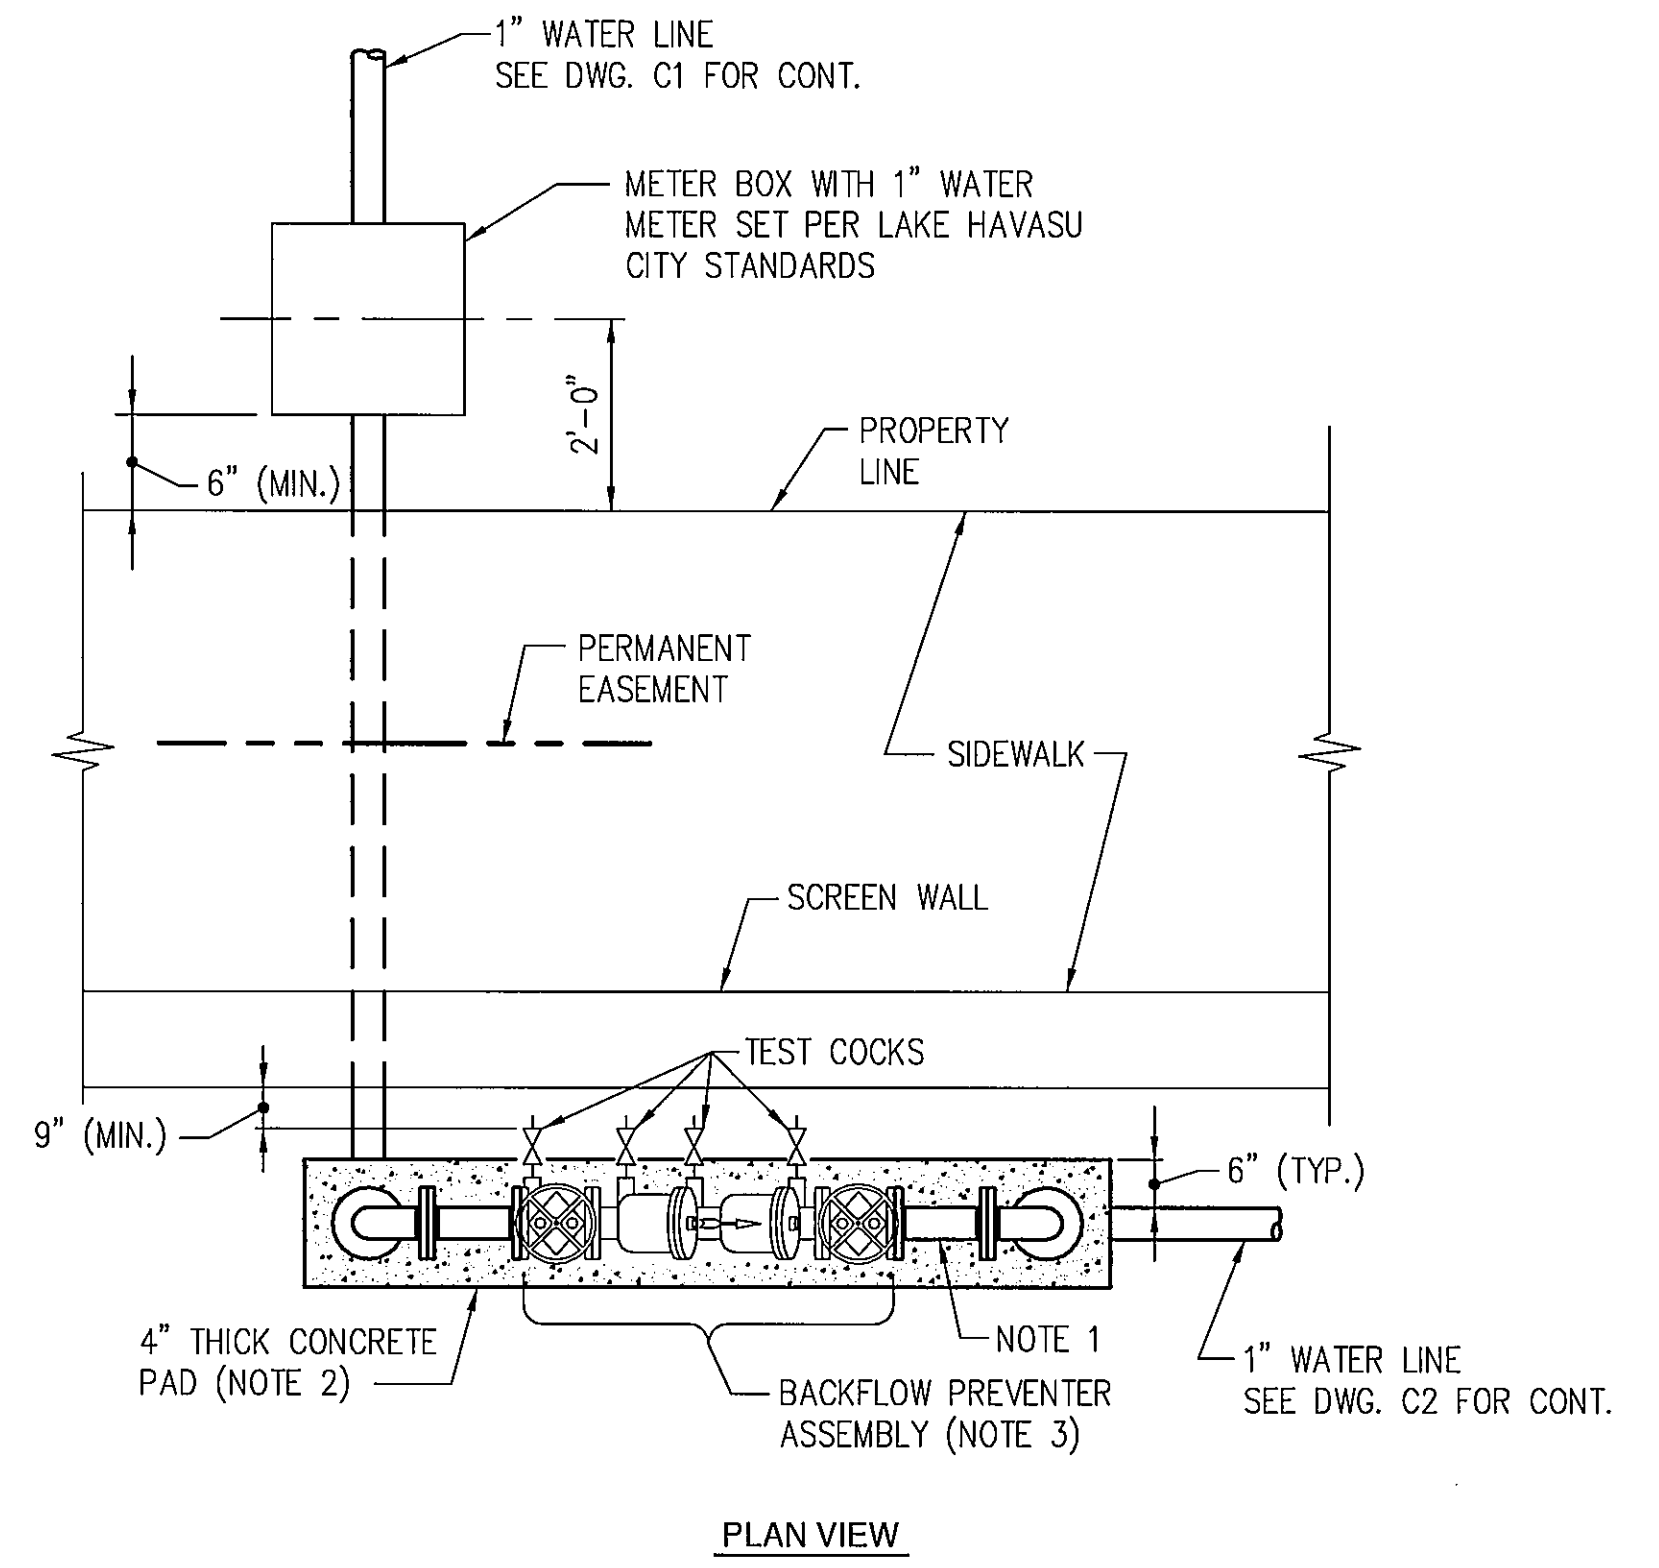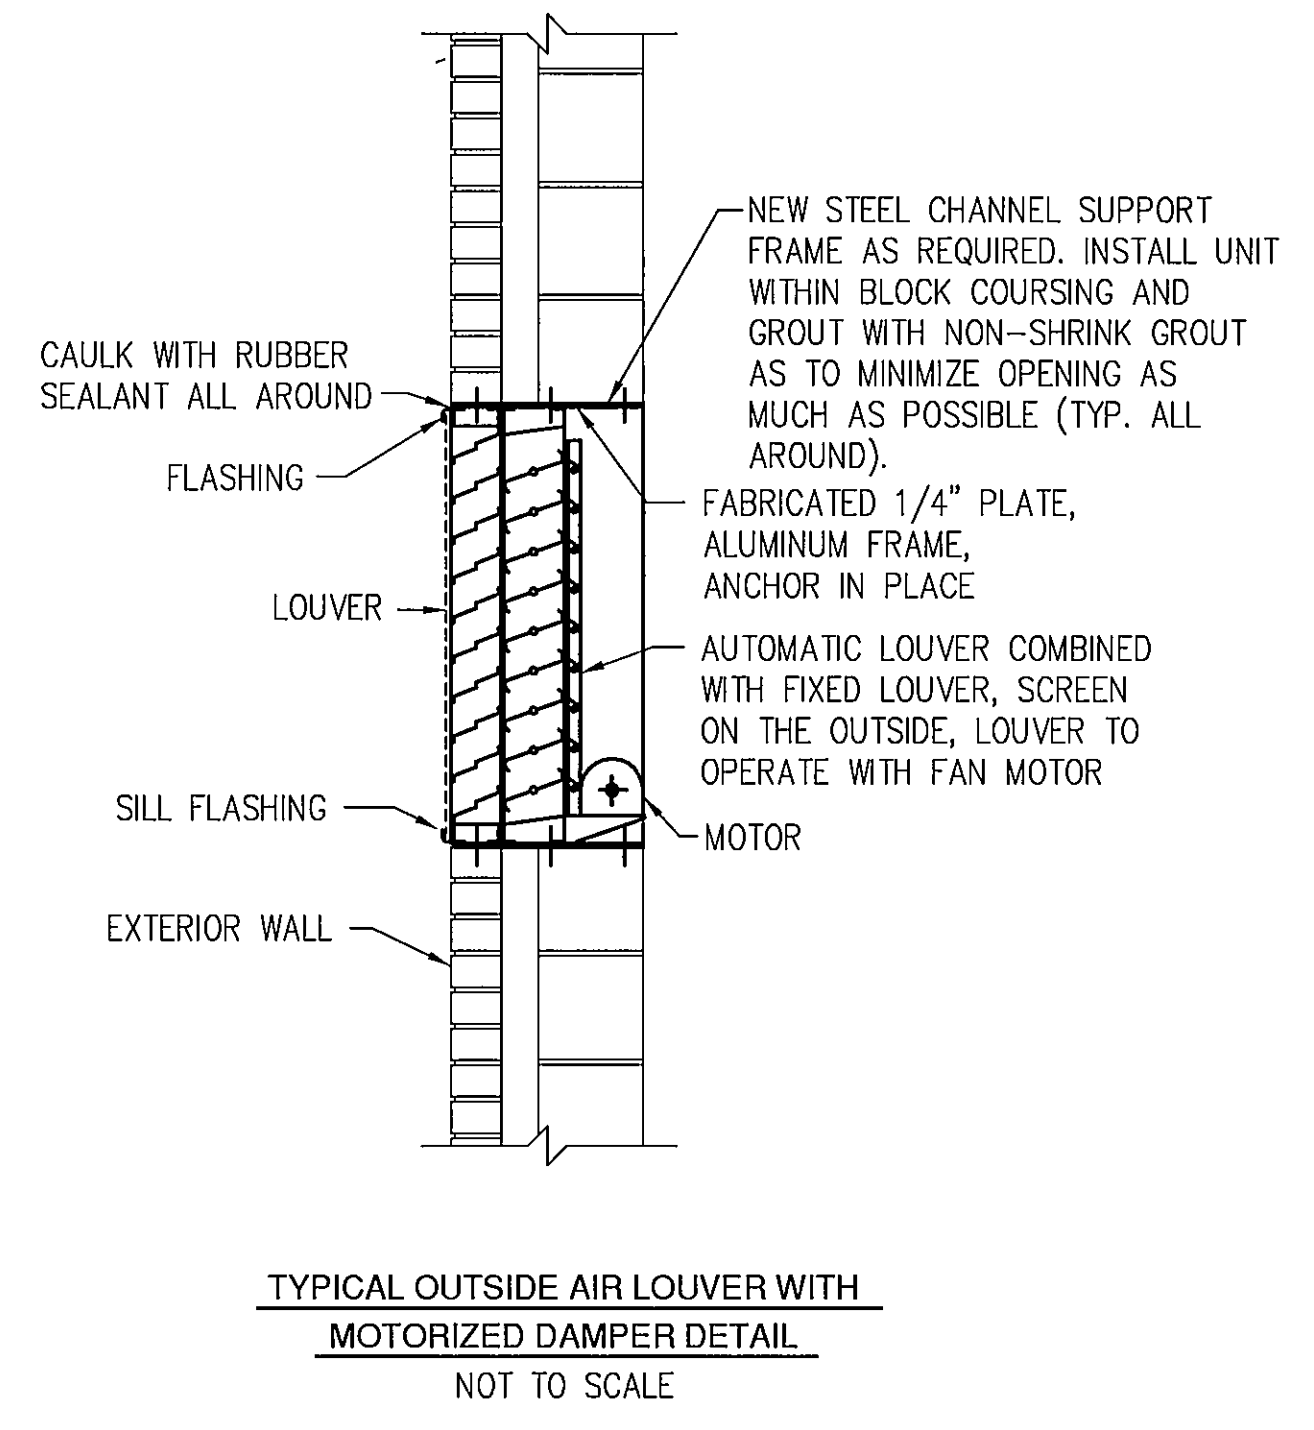


- NOTES:**
- ALL PIPING ABOVE GROUND SHALL BE BRASS, COPPER (TYPE K) OR D.I.P.
  - CONCRETE PAD SHALL BE 2500 PSI.
  - USS-FCCCHR APPROVED BACKFLOW PREVENTER ASSEMBLY.

**WATER SUPPLY AT METER LOCATION  
BACKFLOW PREVENTER INSTALLATION DETAIL**  
NOT TO SCALE



date	NOV. 23, 1999	detailed	R.L. BENNETT
designed	R.L. BENNETT	checked	R.G.H.

“AS-BUILT”

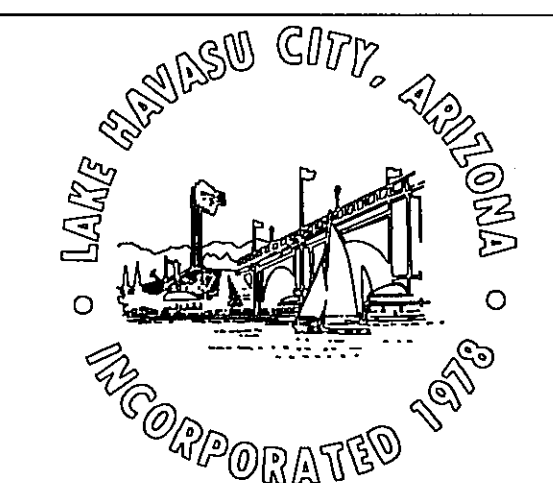

LONDON BRIDGE BEACH PUMP HOUSE			
MISCELLANEOUS DETAILS AND SCHEDULES			
project		contract	
97-777-1-002		W-183-00	
drawing		rev.	
<b>M3</b>		<b>—</b>	
sheet	14	of	21 sheets
file	LBBPHM03.dwg	04-19-2000	08:18 RLB




Scale For Microfilming  
Inches  
Millimeters

COPYRIGHT © 2000 BURNS AND McDONNELL ENGINEERING COMPANY, INC.

PIPING			
	GATE VALVE		BACKFLOW PREVENTER
	GLOBE VALVE		VACUUM BREAKER
	BUTTERFLY VALVE		MOISTURE SEPARATOR
	CHECK VALVE		IN-LINE FLOW METER
	STOP CHECK VALVE		SIGHT FLOW INDICATOR
	AUTOMATIC RECIRCULATION CHECK VALVE		FLEXIBLE HOSE
	PLUG VALVE		EXPANSION ELEMENT (JOINT)
	3-WAY PLUG VALVE (2-PORT)		FLEXIBLE BALL JOINT
	3-WAY PLUG VALVE (3-PORT)		BASKET TYPE STRAINER
	4-WAY PLUG VALVE (4-PORT)		TEE TYPE STRAINER
	3-WAY VALVE		Y-TYPE STRAINER
	ANGLE VALVE		CONICAL STRAINER
	RELIEF OR SAFETY VALVE		DUPLEX STRAINER
	HOSE GATE DRAIN VALVE		STEAM TRAP ASSEMBLY
	PINCH VALVE		SLEEVE COUPLING (SC)
	NEEDLE VALVE		HARNESSED SLEEVE COUPLING (HSC)
	DIAPHRAGM VALVE		INSULATED SLEEVE COUPLING (ISC)
	BALL VALVE		FLANGED COUPLING ADAPTER (FCA)
	SELF-CONTAINED PRESSURE REDUCING (REGULATING VALVE)		DRAINER ASSEMBLY
	SURGE RELIEF VALVE		SAMPLE COOLER
	KNIFE GATE VALVE		INSULATING FLANGE (I.F.)
	CORPORATION STOP		RESTRICTING ORIFICE
	AIR RELEASE VALVE		STRAIGHTENING VANE
	VACUUM VALVE		RUPTURE DISK
	AIR AND VACUUM VALVE		PIPE GUIDE
	BLOW-OFF VALVE ASSEMBLY		PIPE WITH HEATING CABLE
	LOCKED OPEN		DRIP POCKET ASSEMBLY
	LOCKED CLOSED		UNION
	GAUGE SEAL		PIPE ANCHOR
VALVE OPERATORS			REDUCER
	CYLINDER		DISCHARGE ELBOW ASSEMBLY
	DIAPHRAGM		REMOVABLE PLUG
	MOTOR		REMOVABLE CAP
	SOLENOID		WELDED CAP
	DIAPHRAGM WITH HANDWHEEL		BLIND FLANGE
	CHAINWHEEL		CLEANOUT
	FLOAT		YARD HYDRANT
			AIR COCK
			HOSE BIBB
			WALL HYDRANT
			QUICK DISCONNECT COUPLING
			EXHAUST TO ATMOSPHERE (INSIDE)
			EXHAUST TO ATMOSPHERE (OUTSIDE)

ABBREVIATIONS			
A.A.C.	ARIZONA ADMINISTRATIVE CODE	NC	NORMALLY CLOSED
ACP	ASBESTOS CEMENT PIPE	N.O.	NORMALLY OPENED
ADOT	ARIZONA DEPARTMENT OF TRANSPORTATION	P-1	PUMP NO. 1
ARV	COMBINATION AIR/VACUUM RELIEF VALVE OR AIR RELIEF VALVE	PCCP	PRESTRESSED CONCRETE CYLINDER PIPE
BFV	BUTTERFLY VALVE	PP	POWER POLE
CP	COUPLING/CONNECTOR	PS-1	PIPE SUPPORT-1
CV	CHECK VALVE	PUE	PUBLIC UTILITY EASEMENT
DE	DRAINAGE EASEMENT	PVI	POINT OF VERTICAL INFLECTION
D.I.P.	DUCTILE IRON PIPE	RCP	REINFORCED CONCRETE PIPE
EL	ELEVATION	RJ	RESTRAINED JOINT
FH	FIRE HYDRANT	R/W	RIGHT OF WAY
FL	FLOW LINE	SV	SEWER VALVE
GV	GATE VALVE	TJB	TELEPHONE JUNCTION BOX
GM	GAS METER	UGT	UNDERGROUND TELEPHONE LINE
G	GAS LINE	WM	WATER METER
INV	INVERT	WV	WATER VALVE
LP	LIGHT POLE		
MJ	MECHANICAL JOINT		
MW	GROUNDWATER MONITORING WELL		


INSTRUMENTS	
	FLOW METERING ELEMENT
	GG - GAUGE GLASS
	LI - LEVEL INDICATOR
	LC - LEVEL CONTROLLER
	LLS - LIQUID LEVEL SWITCH
	LX - LEVEL TRANSMITTER
	FI - FLOW INDICATOR
	FC - FLOW CONTROLLER
	FS - FLOW SWITCH
	FX - FLOW TRANSMITTER
	T - THERMOMETER
	TC - THERMOCOUPLE
	TCT - TEMPERATURE CONTROLLER
	TS - TEMPERATURE SWITCH
	TX - TEMPERATURE TRANSMITTER
	RTD - RESISTANCE TEMPERATURE DETECTOR
	P - PRESSURE GAUGE
	PC - PRESSURE CONTROLLER
	PS - PRESSURE SWITCH
	PX - PRESSURE TRANSMITTER
	P - DIFFERENTIAL PRESSURE GAUGE
	PC - DIFFERENTIAL PRESSURE CONTROLLER
	PS - DIFFERENTIAL PRESSURE SWITCH
	PX - DIFFERENTIAL PRESSURE TRANSMITTER
	TC - TEST CONNECTION
	PT - PRESSURE TAP
	SAMPLE CONNECTION
	CONTROL FUNCTION LINE

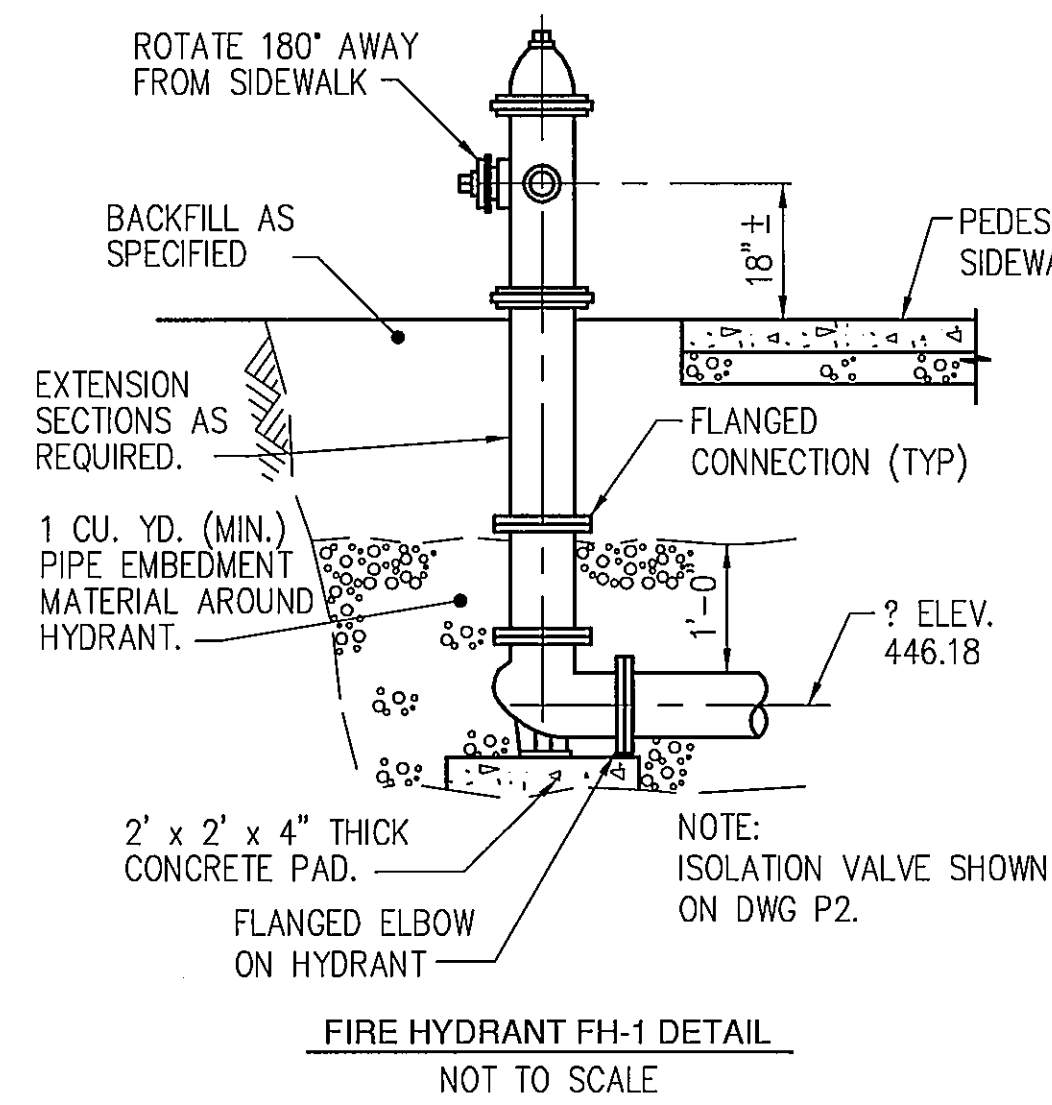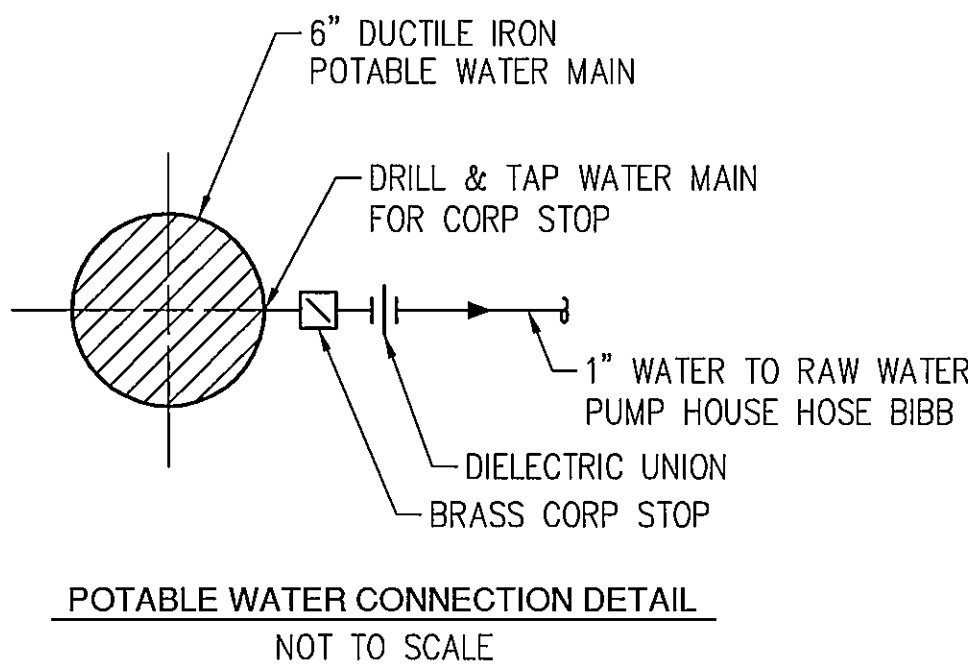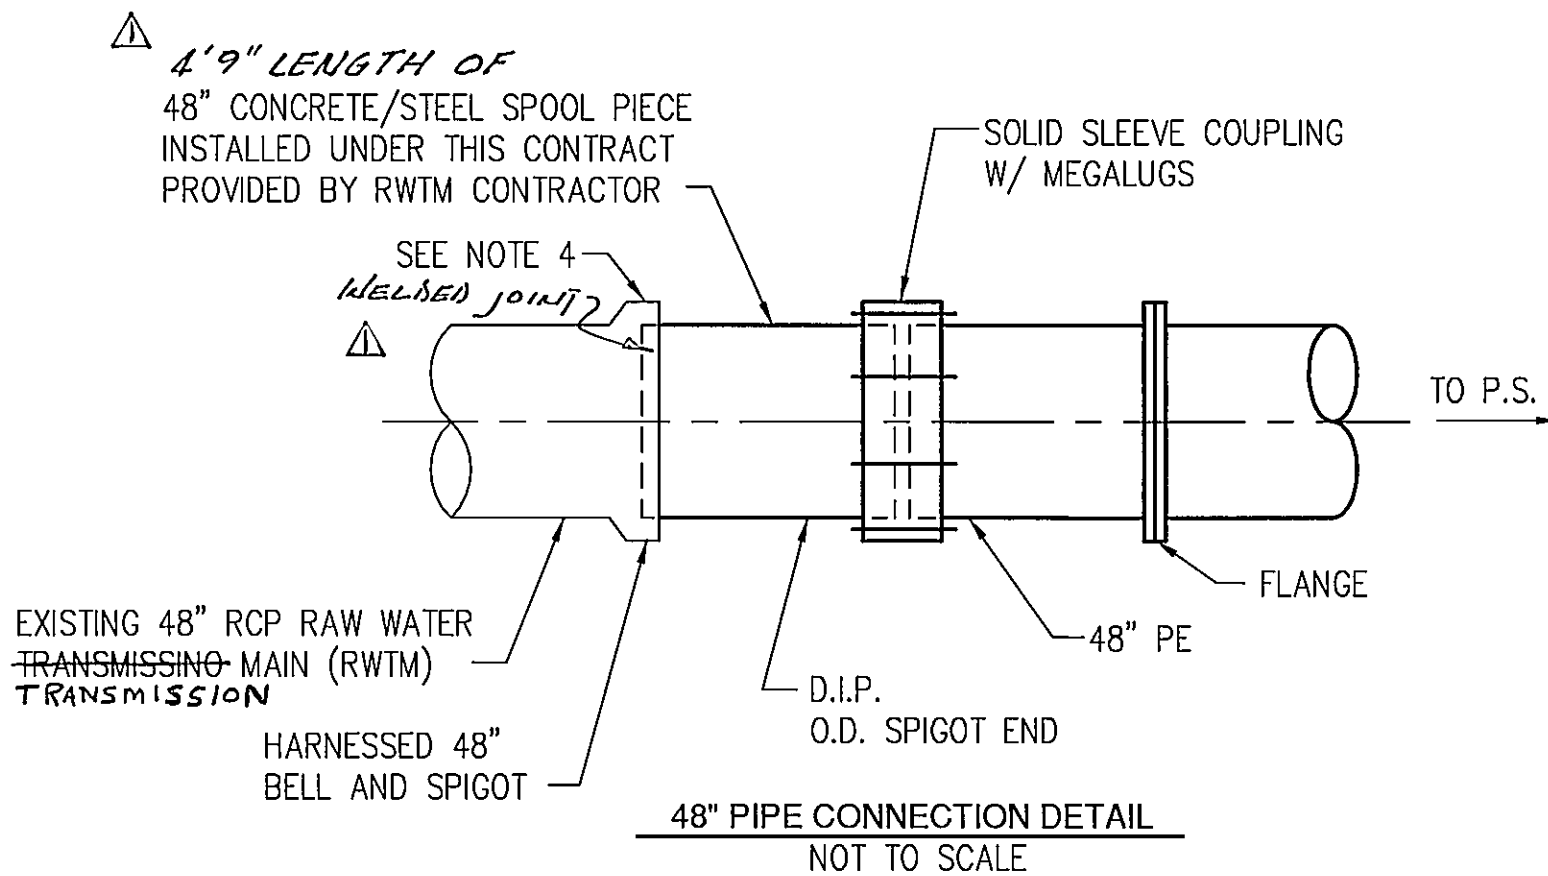


	CATV	CABLE TELEVISION		W	WATER
	G	GAS		FM	FORCE MAIN
	OE	OVERHEAD ELECTRIC			FENCE
	UE	UNDERGROUND ELECTRIC			PROPERTY LINE
	S	SANITARY SEWER			RIGHT OF WAY
	SS	STORM SEWER			PERMANENT EASEMENT
	T	TELEPHONE			SECTION LINE
	UT	UNDERGROUND TELEPHONE		FO	FIBER OPTIC

NOTES:

1. THIS IS A STANDARD PROCESS LEGEND AND NOT ALL ITEMS OR EQUIPMENT AS DESIGNATED HEREON ARE USED ON THIS PROJECT.

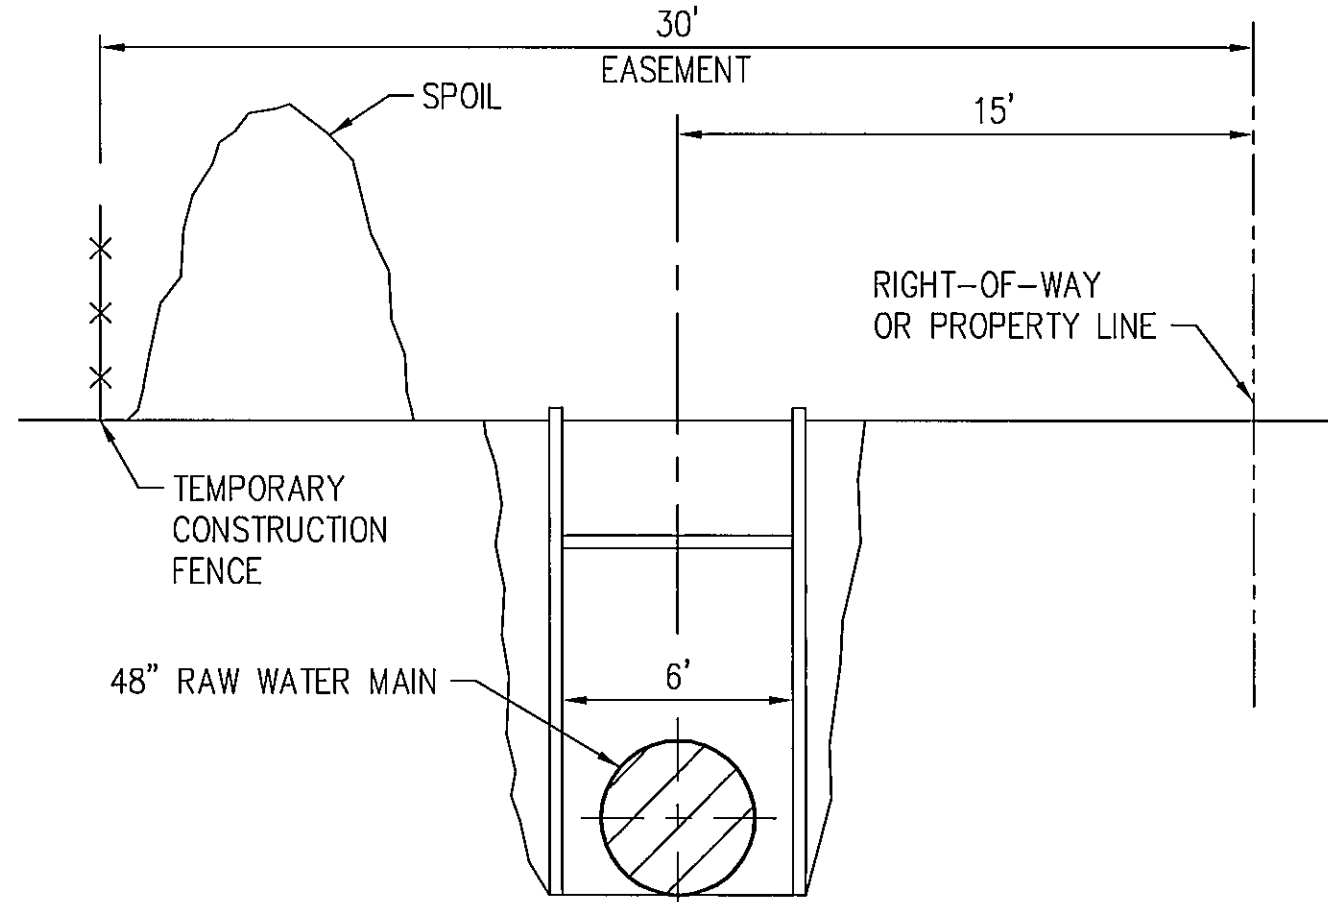


TYPICAL RAW WATER CONSTRUCTION ACCESS LIMITS NOT TO SCALE

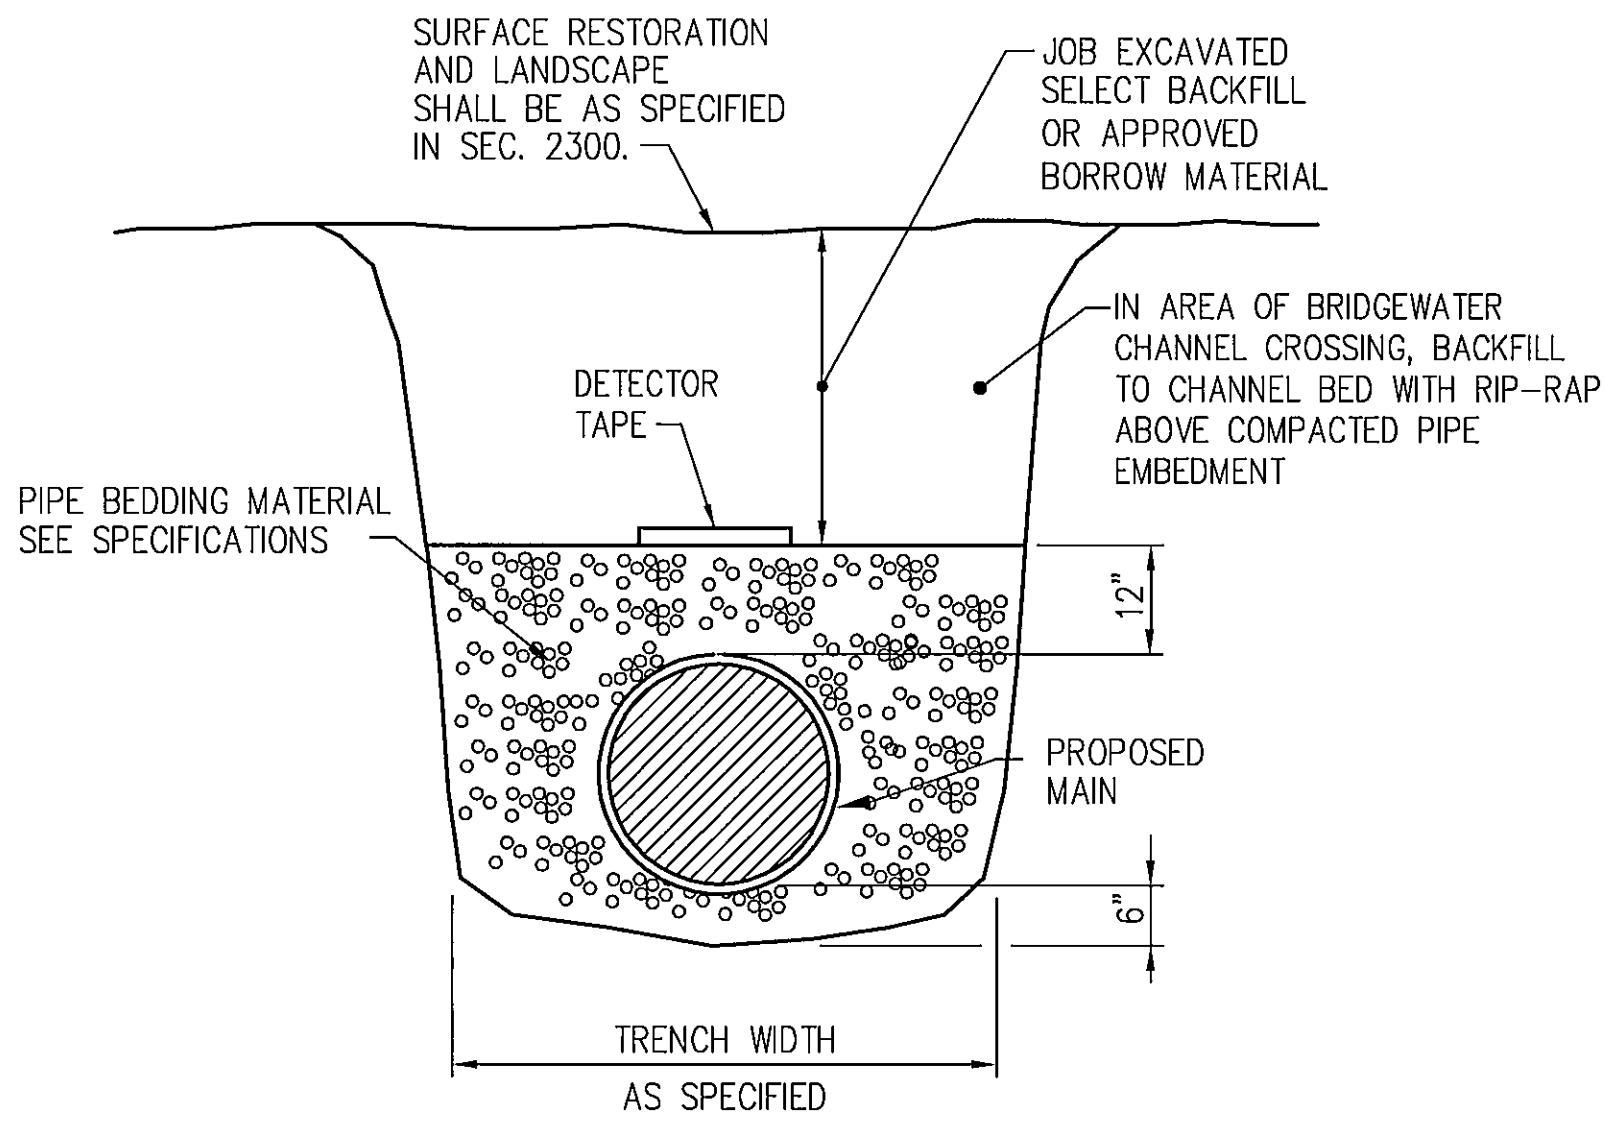

TYPICAL TRENCH DETAIL NOT TO SCALE

"AS-BUILT"

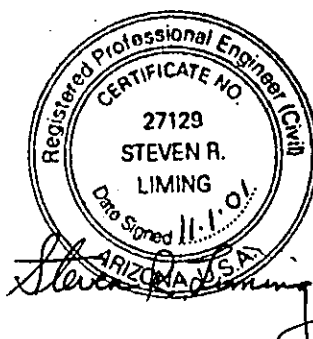

no.	date	by	revision
1	8-15-01	JDF	MODIFIED 48" PIPE CONNECTION DETAIL.
2	8-15-01	JDF	AS-BUILT



date	DEC. 7, 1999	detailed	G. PORTER
designed	T. CROWLEY	checked	J.L.S.




LONDON BRIDGE BEACH PUMP HOUSE

PROCESS LEGEND

project	97-777-1-002	contract	W-183-00
drawing	P1	rev.	
sheet	g	of	21 sheets
file	Lbbphp01.dwg	06-13-2000 15:19	LJM



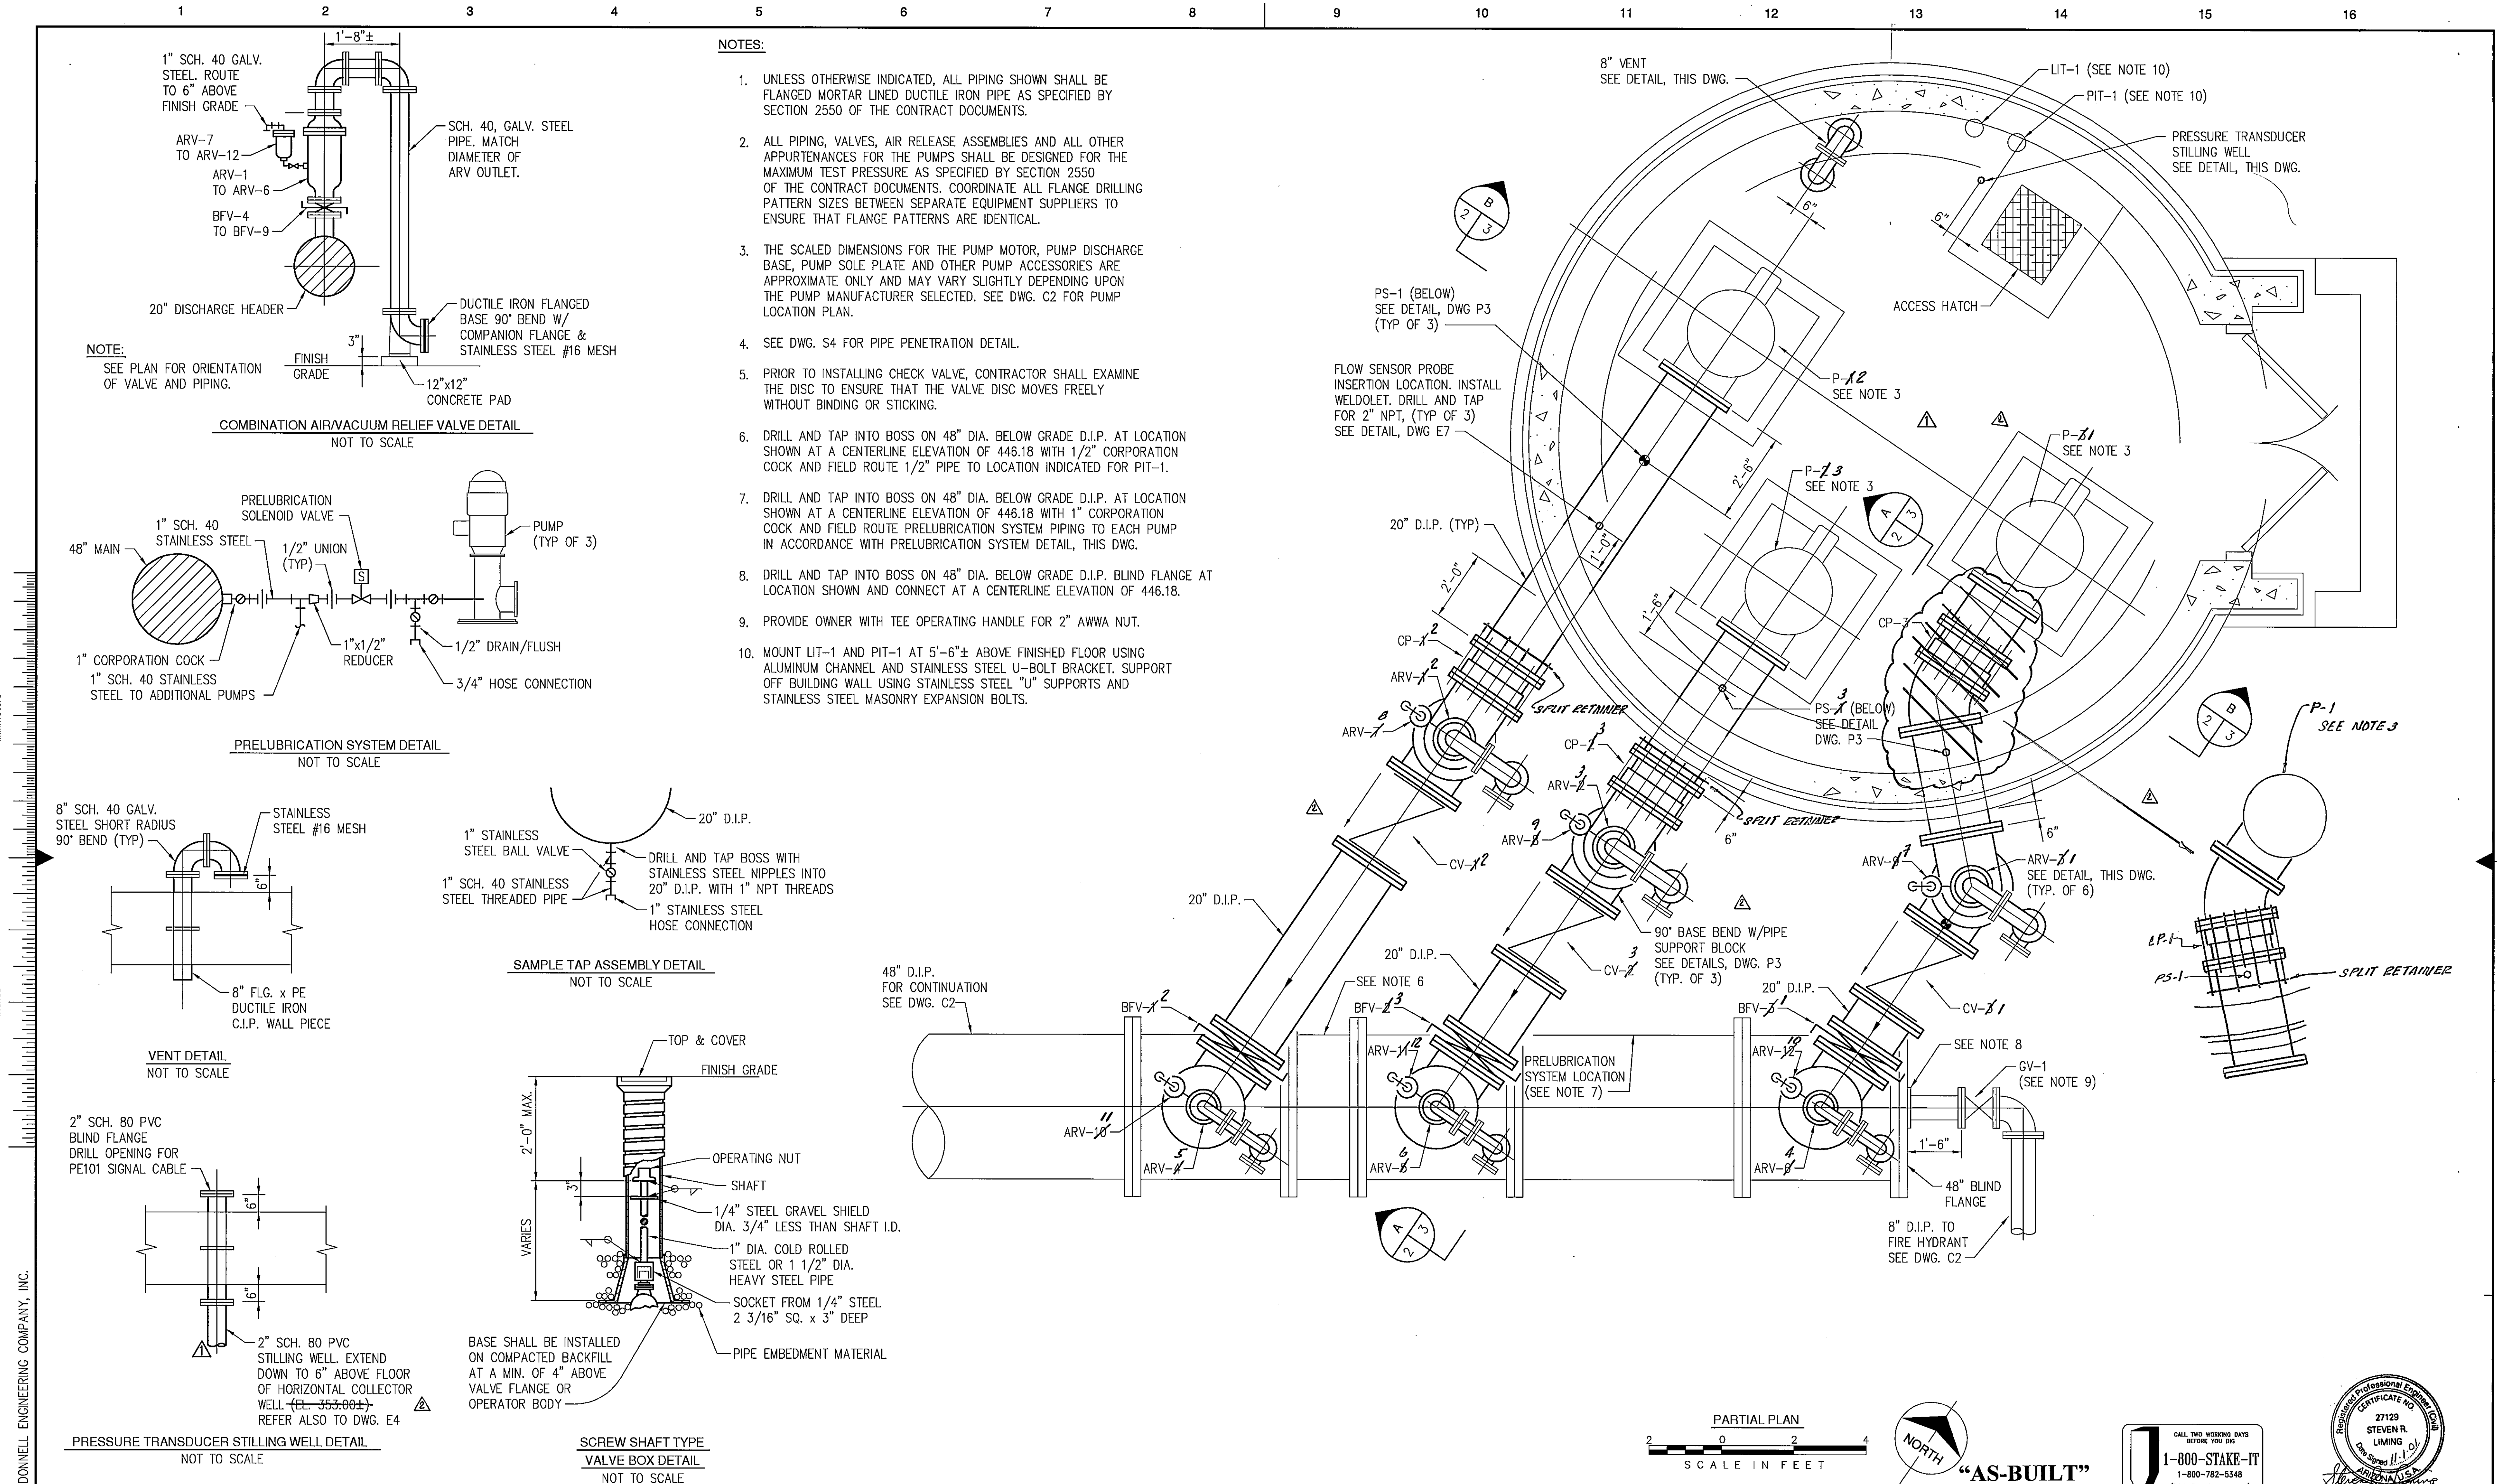


COPYRIGHT © 2000 BURNS AND McDONNELL ENGINEERING COMPANY, INC.

no.	date	by	revision
1	7-27-01	JJM	REVISE DRAWING TO ACCOMMODATE COLLECTOR WELL "AS BUILT"
2	8-15-01	JDF	DELETED ELEM, MODIFIED P-1, REVISED PUMP NUMBERS & ASSOCIATED EQUIPMENT.
3	8-15-01	JDF	As-Built



date NOV. 9, 1999  
designed T. CROWLEY  
detailed G. PORTER  
checked J.L.S.

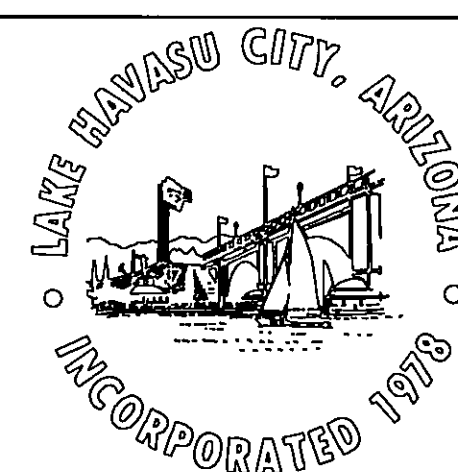

LONDON BRIDGE BEACH PUMP HOUSE





PARTIAL PLAN AND DETAILS

project 97-777-1-002 contract W-183-00  
drawing P2 - rev. 12  
sheet 10 of 21 sheets  
file Lbbp02.dwg 03-20-2000 16:02 LJM





Millimeters  
Inches  
Scale For Microfilming

COPYRIGHT © 2000 BURNS AND McDONNELL ENGINEERING COMPANY, INC.

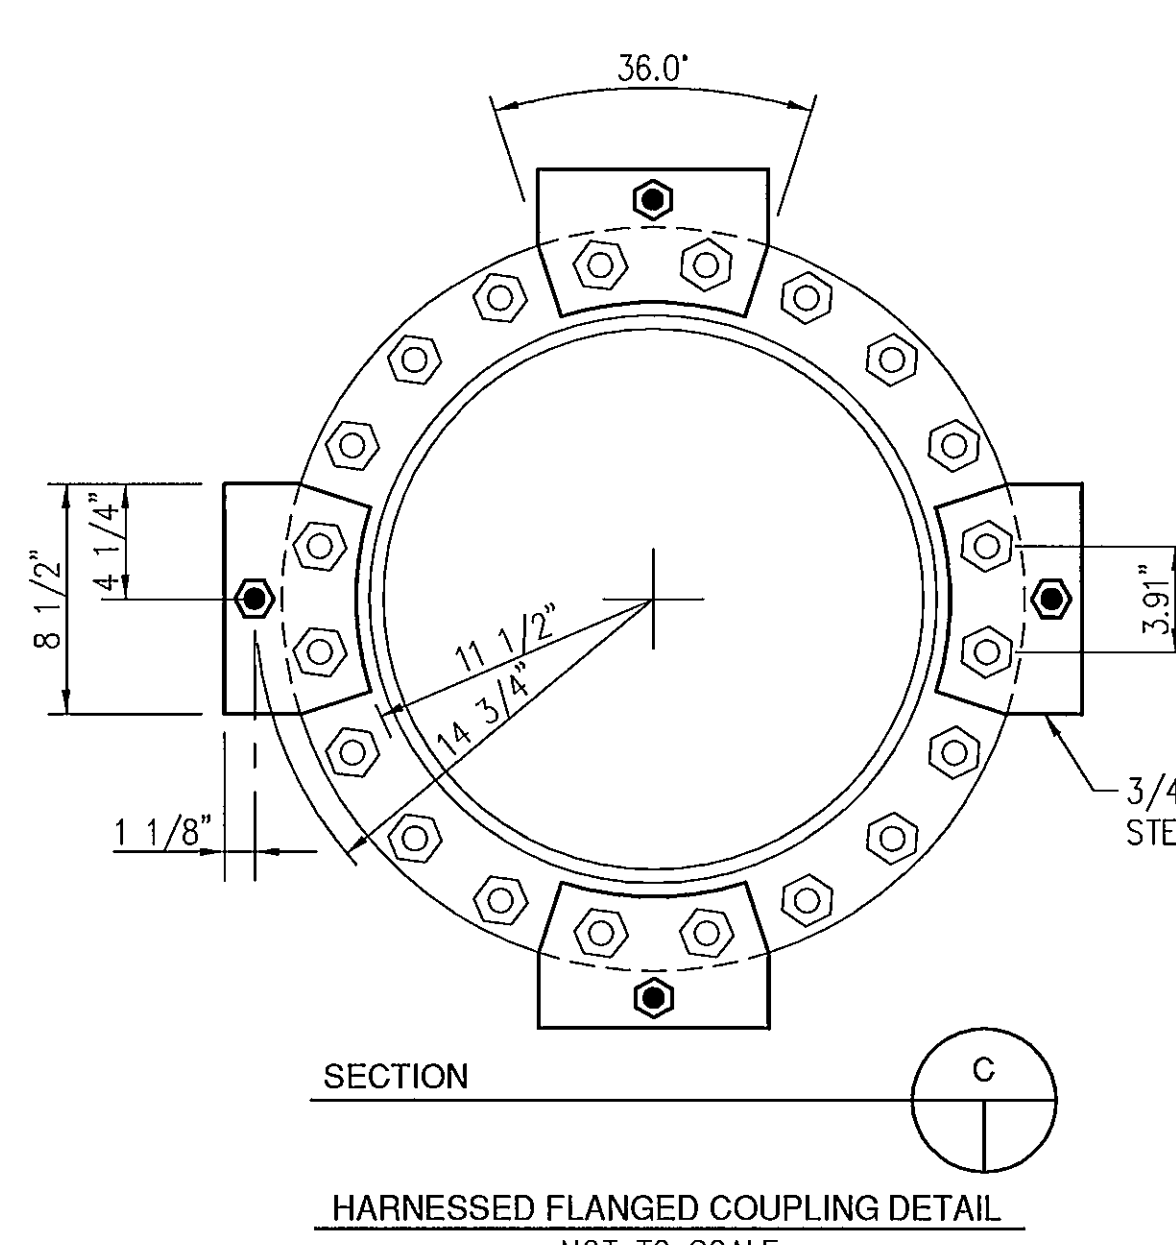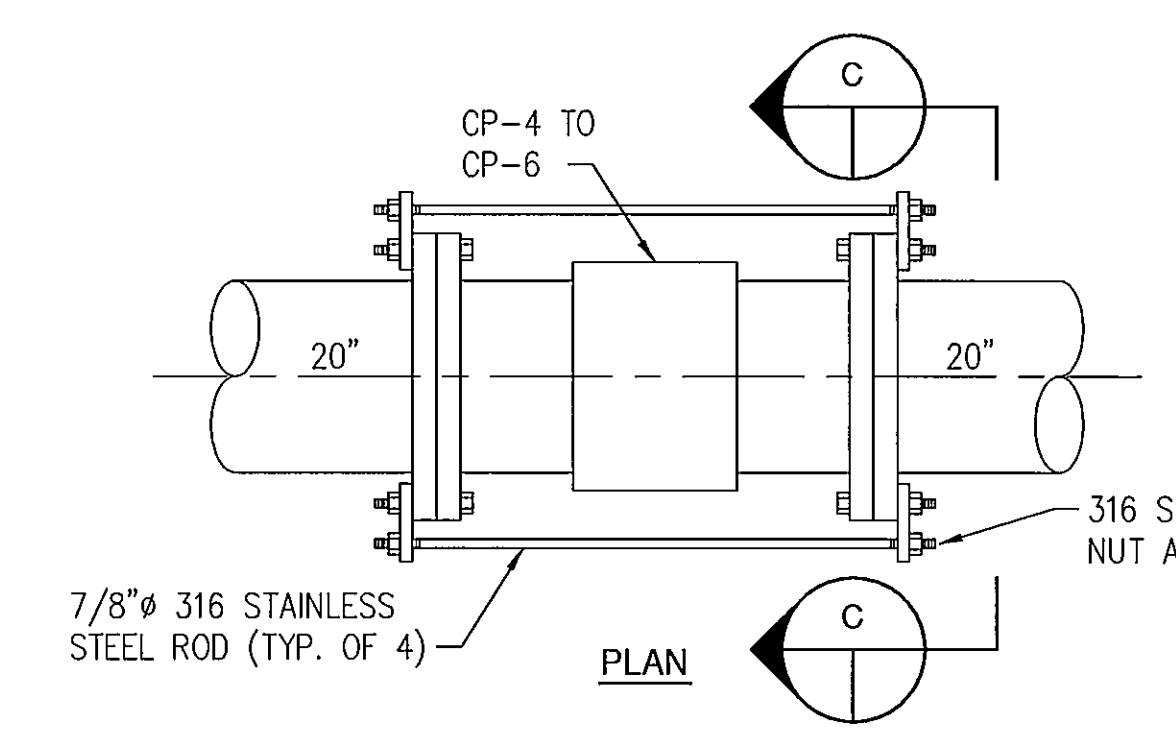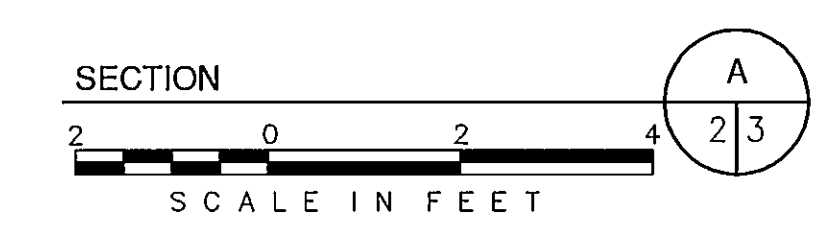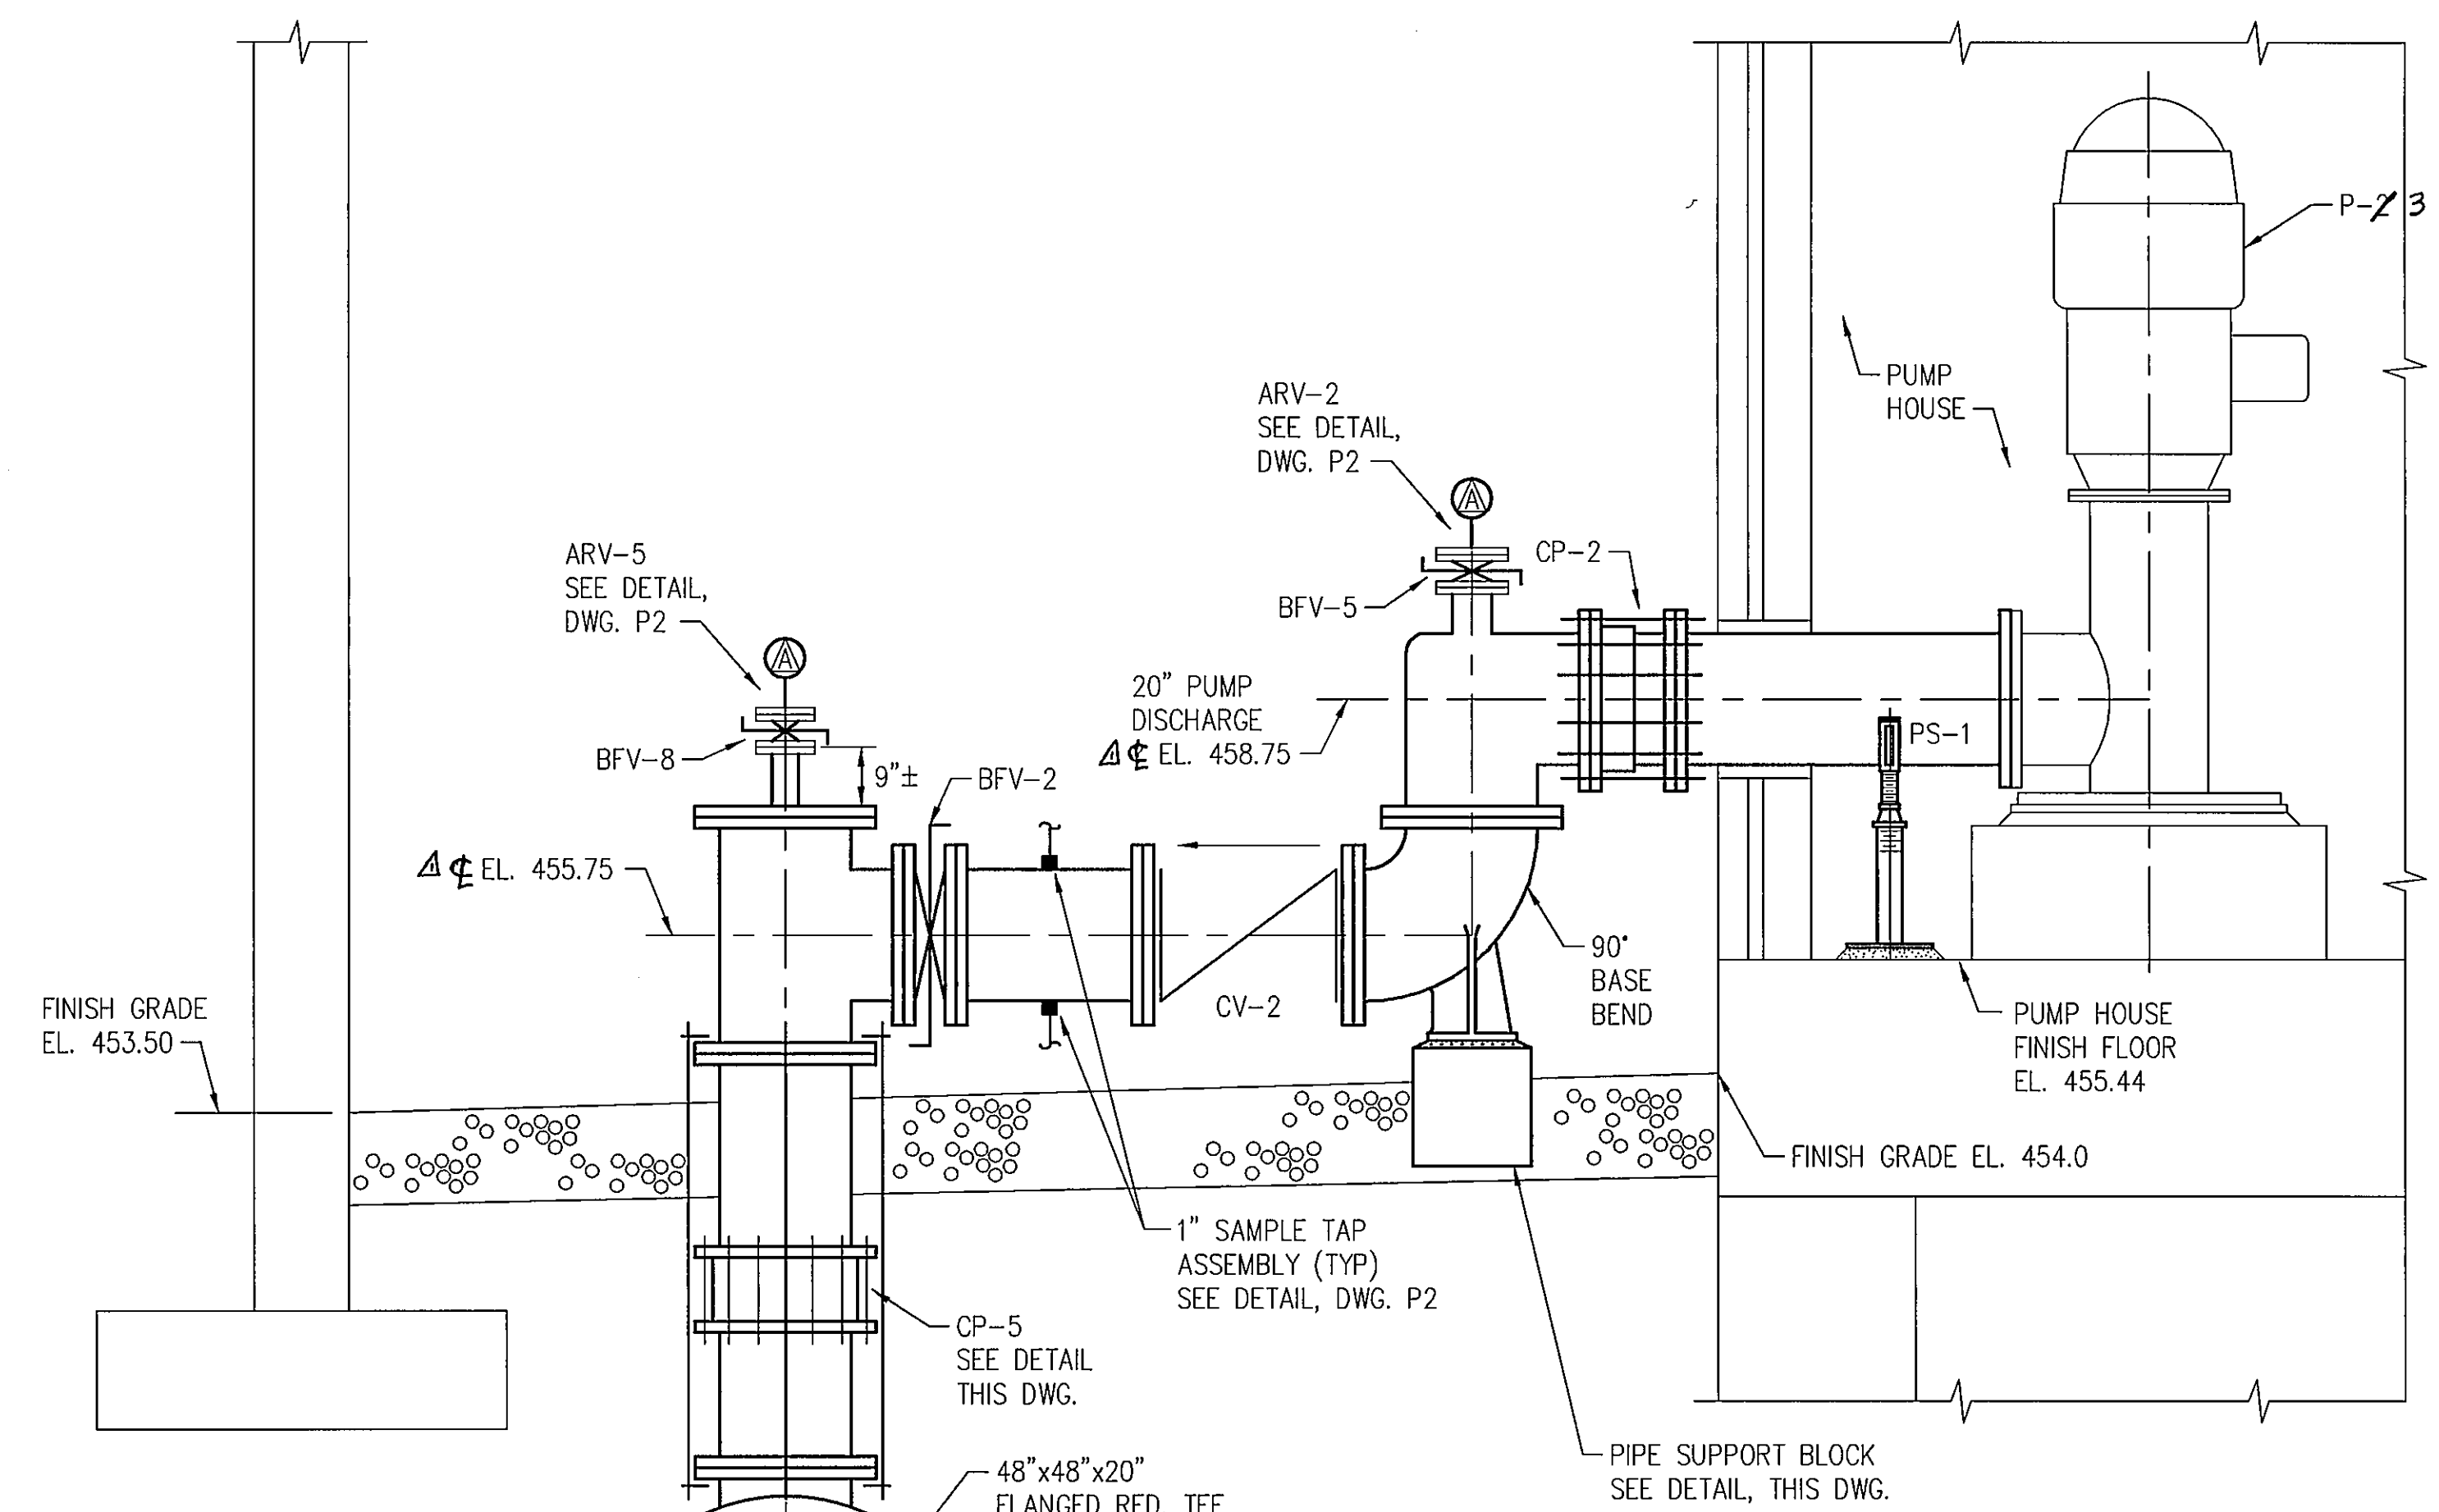


PIPE SUPPORT BLOCK DETAIL  
NOT TO SCALE

HARNESSES FLANGED COUPLING DETAIL  
NOT TO SCALE

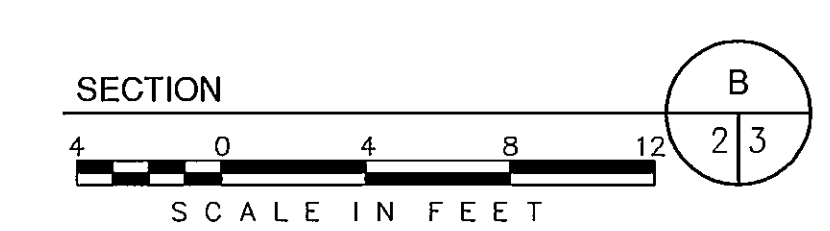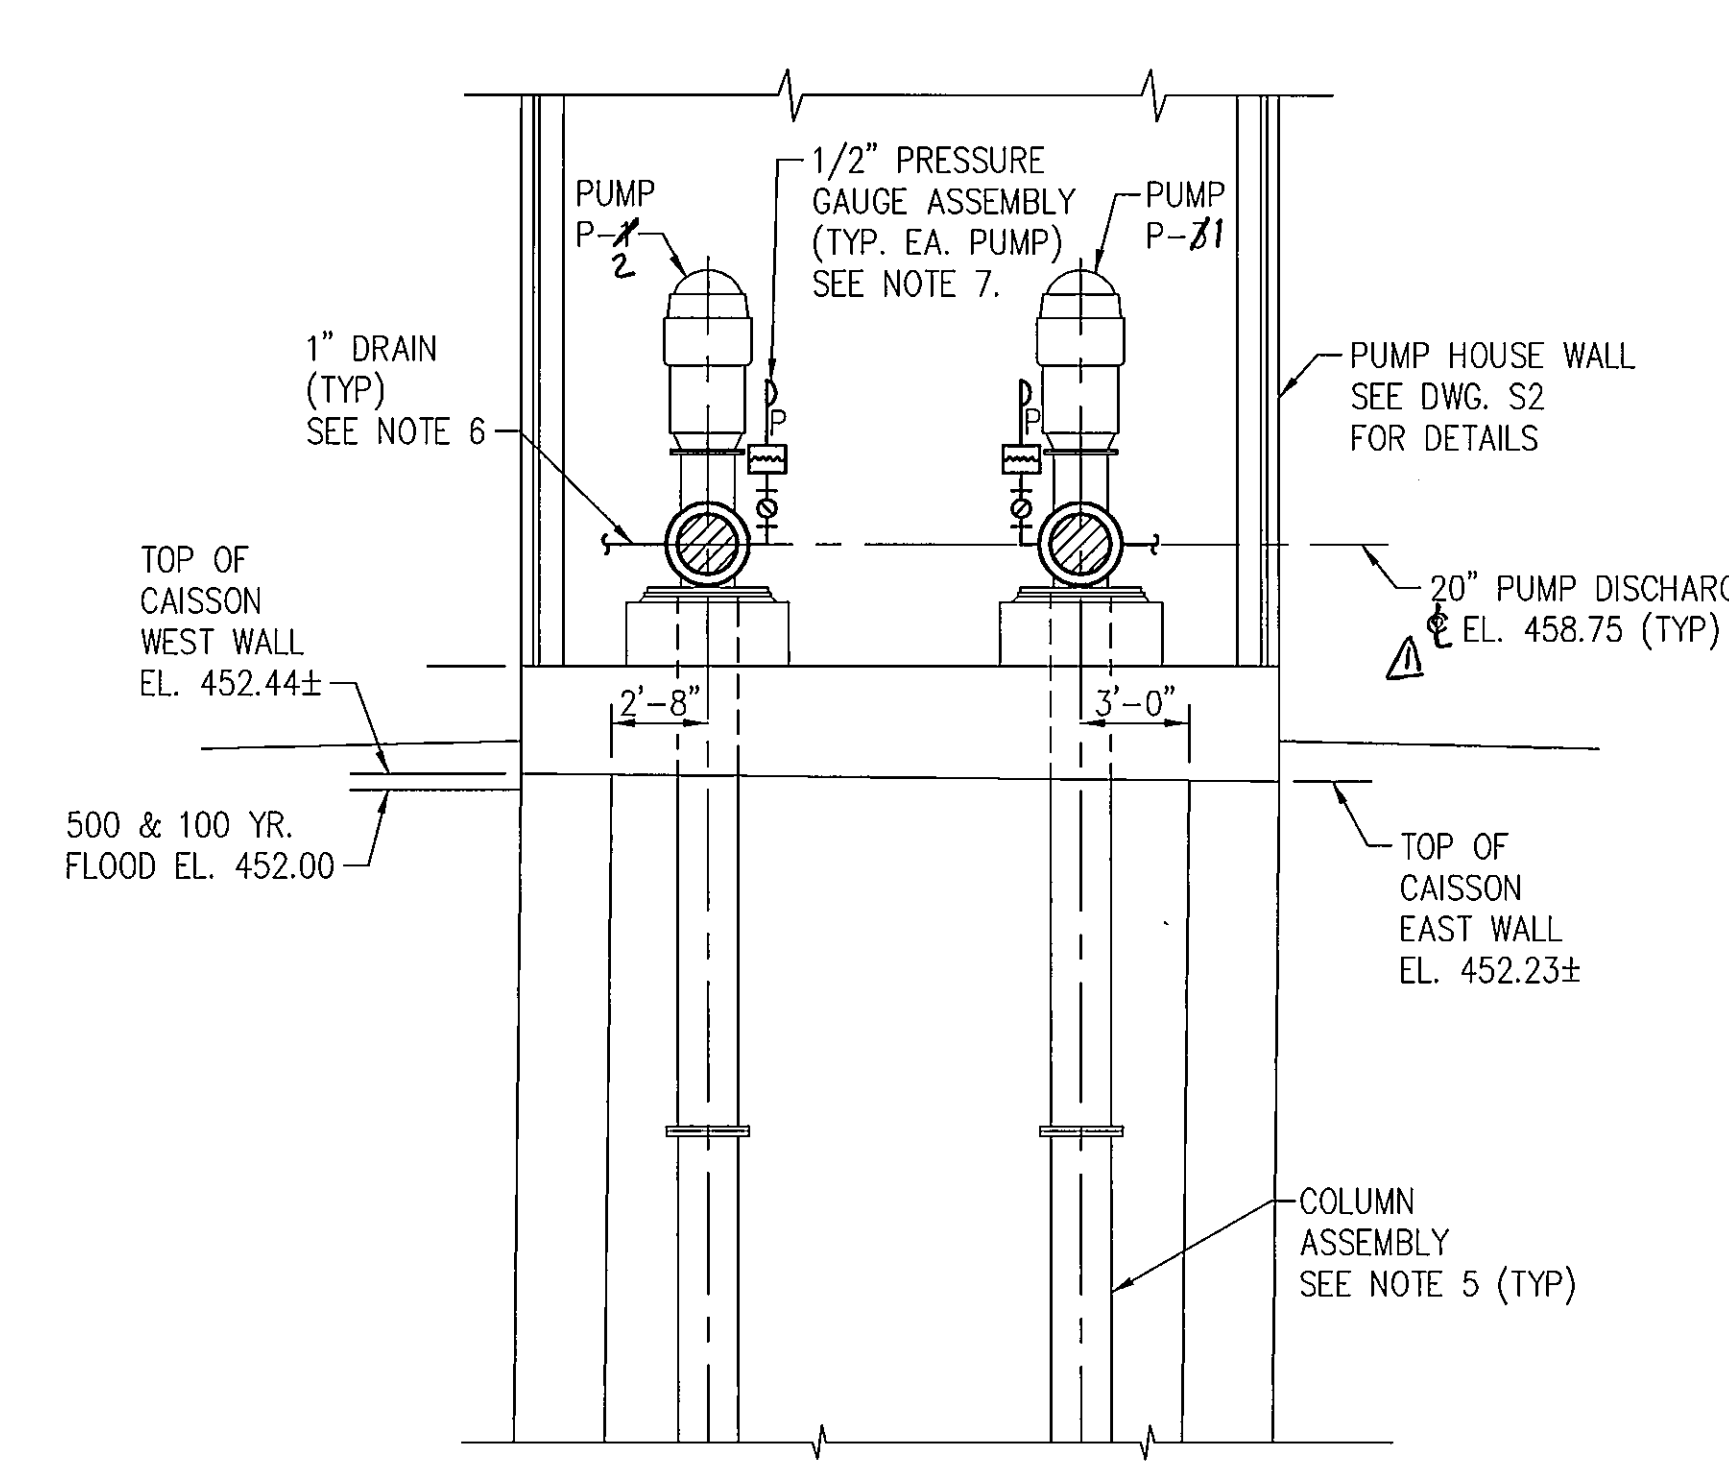


"AS-BUILT"

- NOTES:
1. PRIOR TO PROCEEDING WITH WORK, CONTRACTOR SHALL VERIFY SLOPES OF EAST AND WEST CAISSON WORK. ANY DISCREPANCY BETWEEN THE MEASURED VALUES AND THOSE INDICATED SHOULD BE REPORTED TO OWNER'S FIELD REPRESENTATIVE.
  2. FOR THE SAKE OF CLARITY NOT ALL PIPING AND EQUIPMENT IS SHOWN.
  3. PUMP PAD ELEVATION SHALL BE A MINIMUM OF 6" ABOVE PUMP STATION FINISHED FLOOR. PROVIDE 1"-2" OF GROUT TO ACHIEVE DISCHARGE CENTERLINE ELEVATION AS INDICATED.
  4. DIMENSIONS OF BOWL ASSEMBLY AND QUANTITY OF STAGES VARY BETWEEN PUMP MANUFACTURERS.
  5. PROVIDE SUFFICIENT FLANGED JOINTS ON INSIDE OF PUMP DISCHARGE COLUMN TO AVOID FIELD WELDING. PUMP MANUFACTURER TO DETERMINE EXACT LOCATION AND LENGTHS OF COLUMN ASSEMBLY SUBJECT TO APPROVAL BY ENGINEER.
  6. CONNECT 1" SCH. 40 STAINLESS STEEL PIPE TO SEAL WATER DRAIN CONNECTION, DROP TO PUMP FINISHED FLOOR AND FIELD ROUTE TO NEAREST FLOOR DRAIN. AVOID TRAFFIC AREAS WHERE POSSIBLE AND CLAMP TO FLOOR USING STAINLESS STEEL HARDWARE. SEE DRAWING M2 FOR LOCATION OF FLOOR DRAINS.
  7. PRESSURE GAUGE ASSEMBLIES SHALL CONSIST OF PRESSURE GAUGE, GAUGE SEAL, STAINLESS STEEL ISOLATION VALVE AND STAINLESS STEEL TUBING.

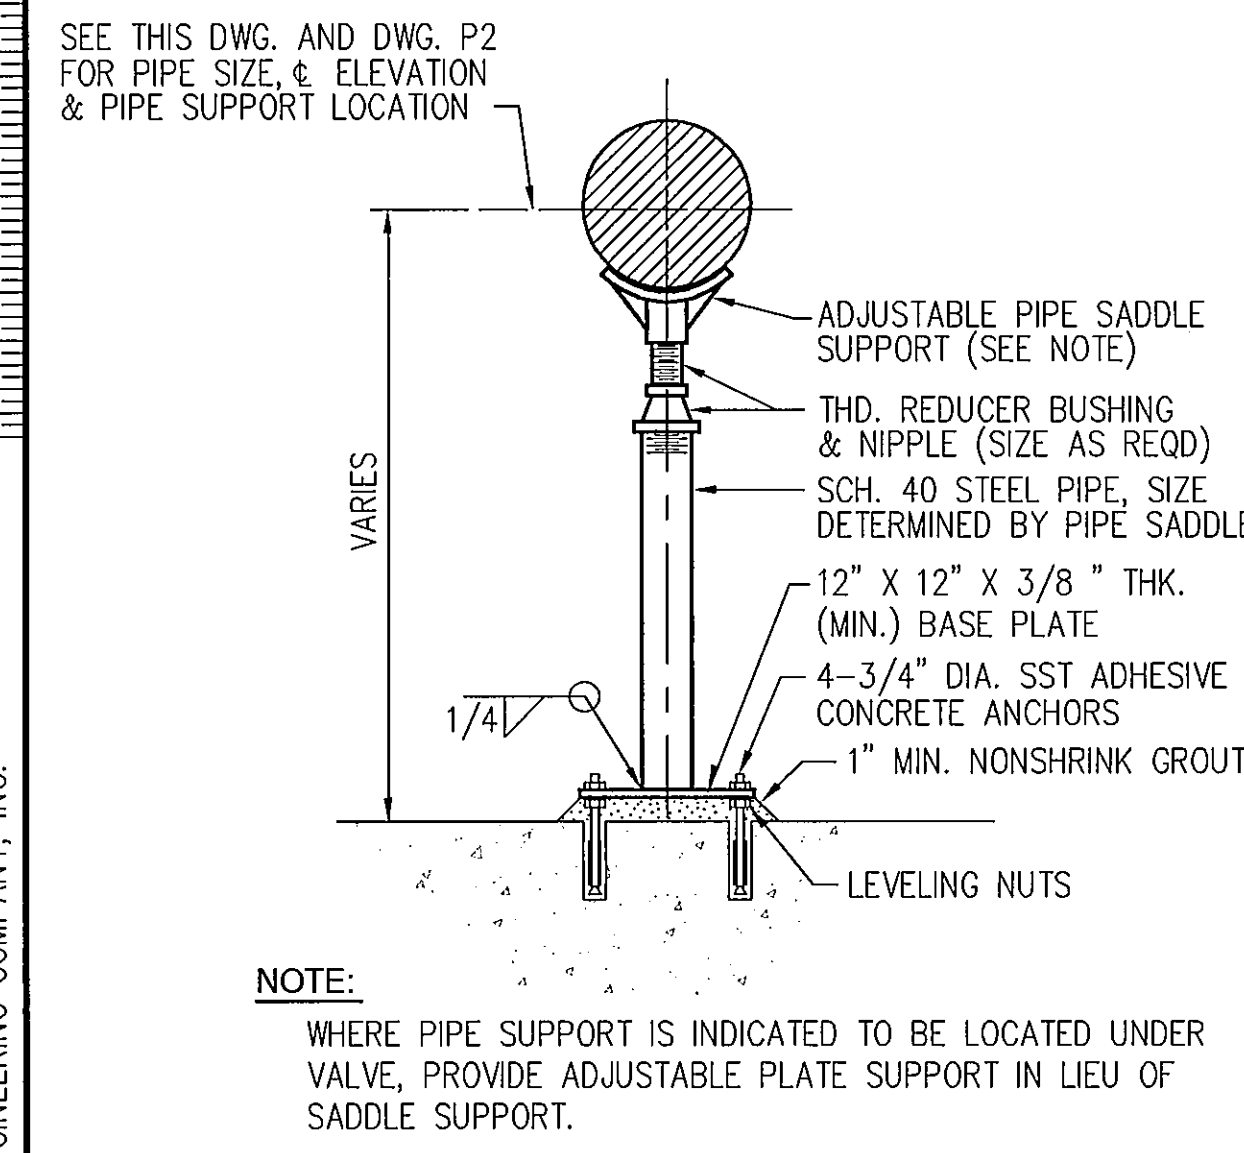

PIPE SUPPORT DETAIL  
NOT TO SCALE

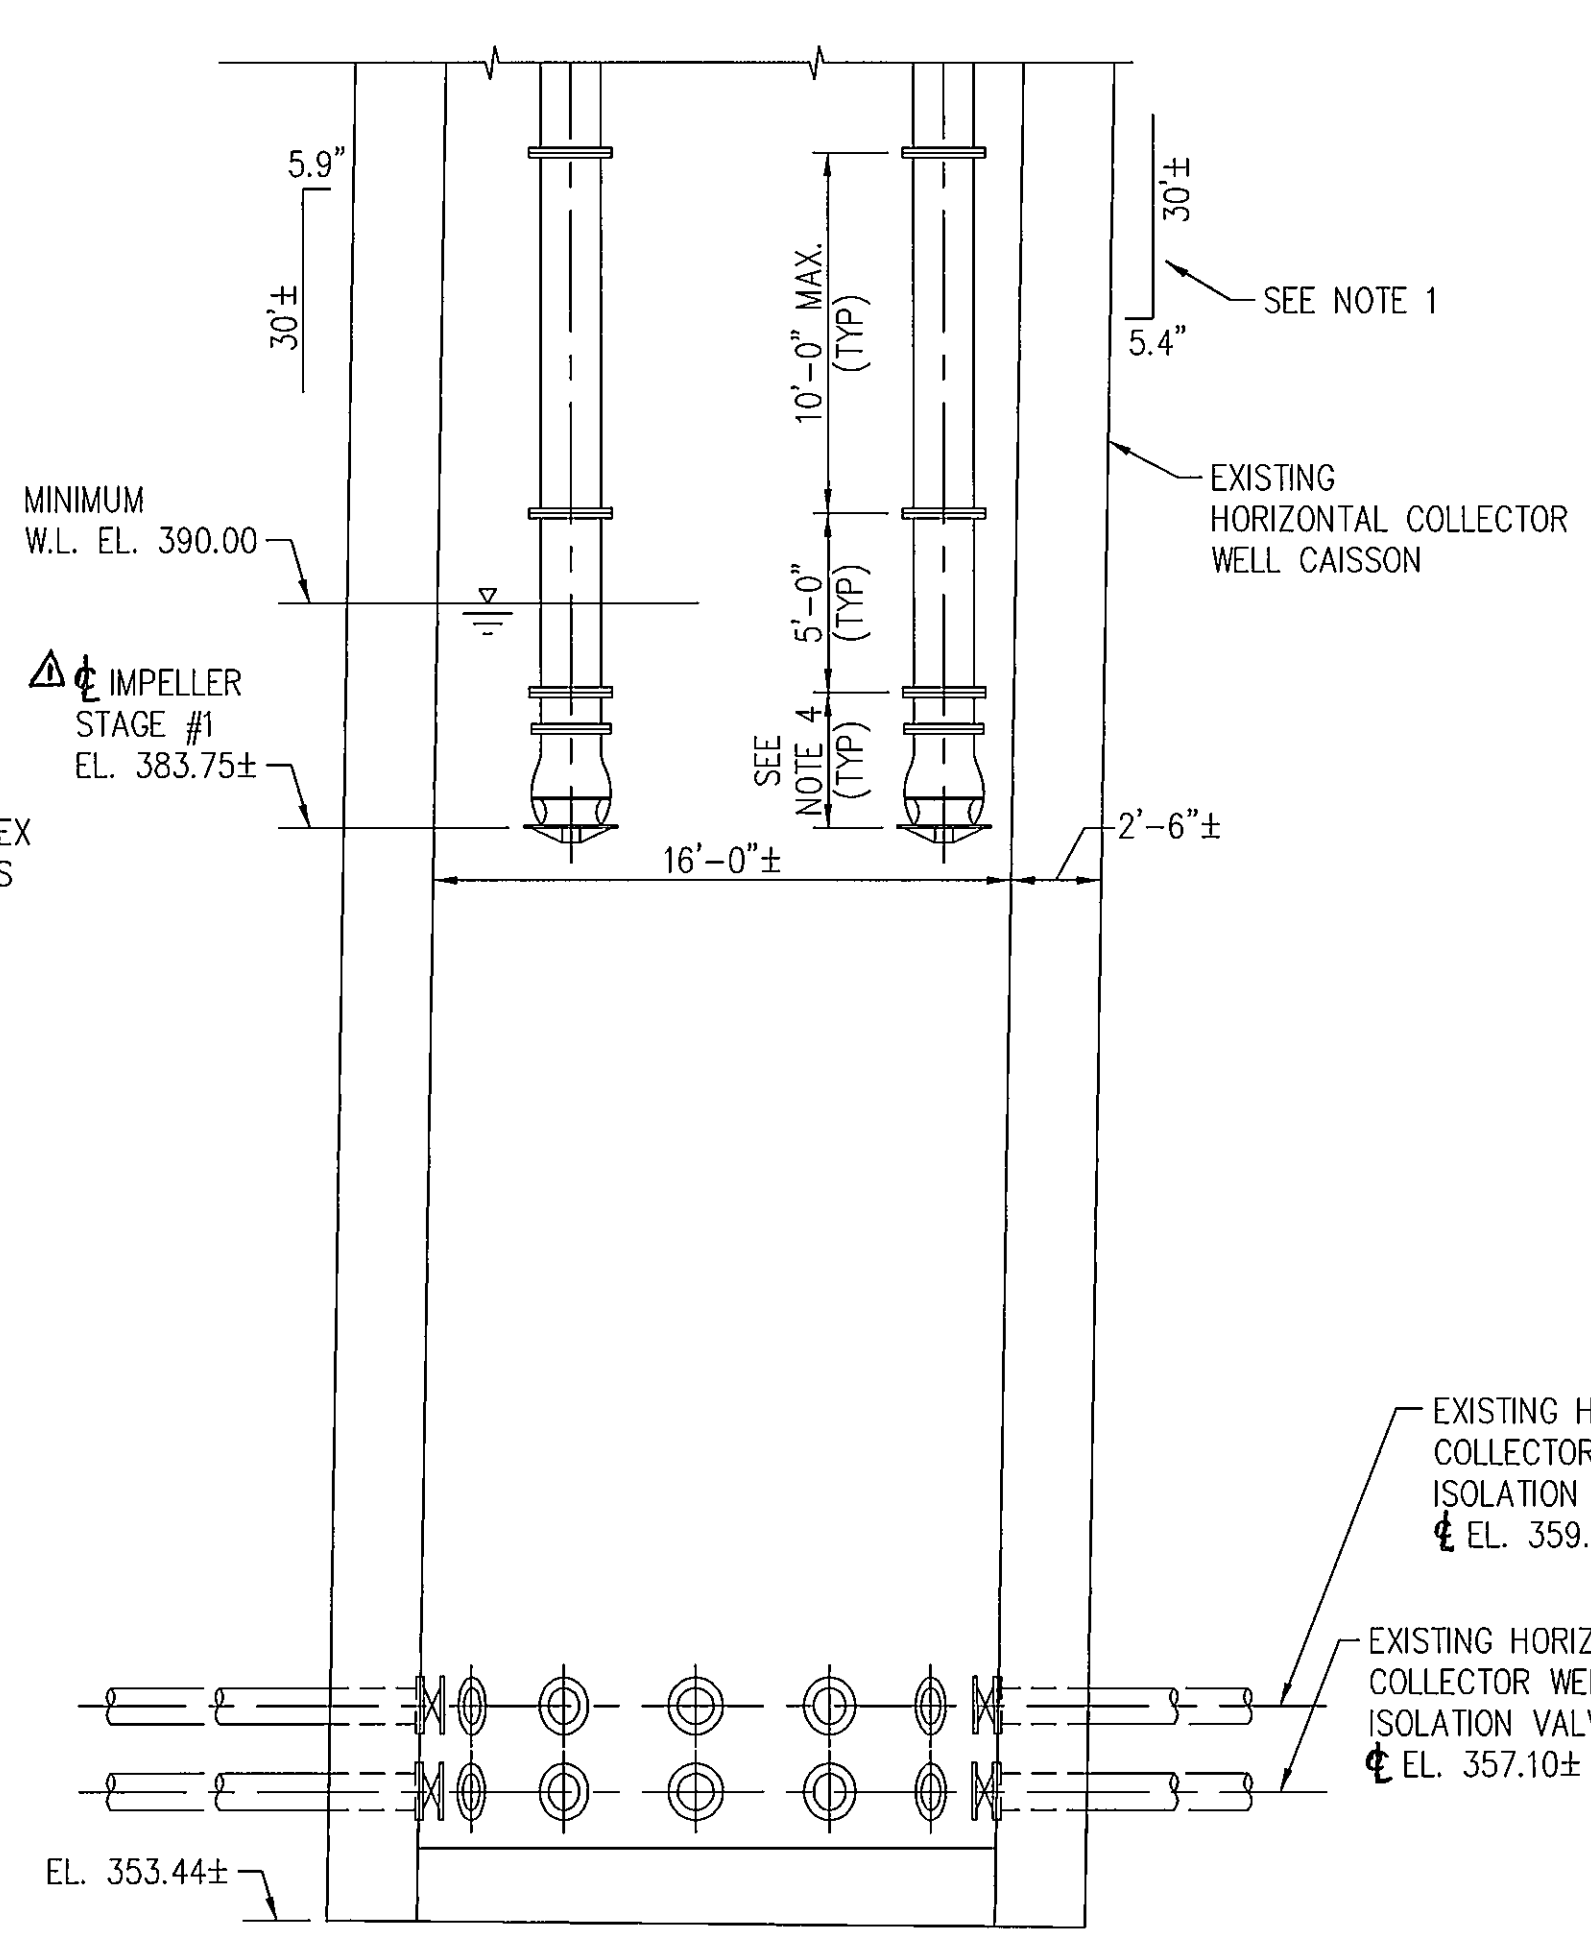

EXISTING HORIZONTAL COLLECTOR WELL LATERALS (B1) AND ISOLATION VALVES (TYP)  
EL. 359.48±


EXISTING HORIZONTAL COLLECTOR WELL LATERALS (A2) AND ISOLATION VALVES (TYP)  
EL. 357.10±

no.	date	by	revision
1	8-15-01	JDF	AS-BUILT


**Burns & McDonnell**  
SINCE 1898


date NOV. 9, 1999  
designed T. CROWLEY

detailed G. PORTER  
checked J.L.S.

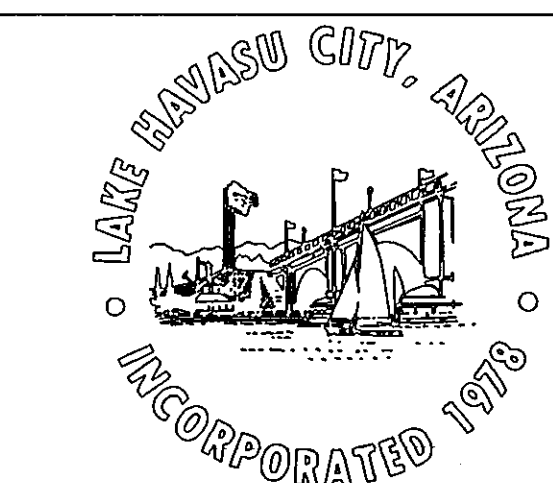

LONDON BRIDGE BEACH PUMP HOUSE	
SECTIONS AND DETAILS	
project 97-777-1-002	contract W-183-00
drawing <b>P3</b>	rev. 1
sheet 11 of 21 sheets	file Lbbphp03.dwg 06-13-2000 15:06 LJM

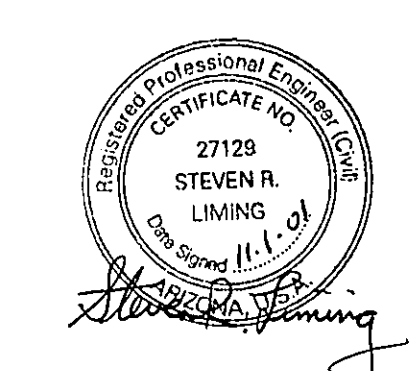


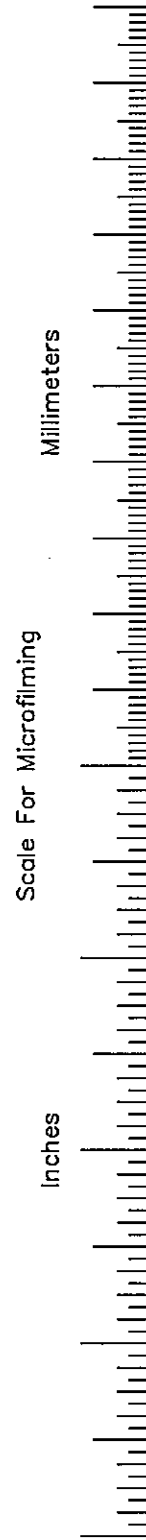


ABBREVIATIONS

AA	ALUMINUM ASSOCIATION	EQL	EQUAL	OF	OUTER FACE	&	AND
AASHTO	AMERICAN ASSOCIATION OF STATE HIGHWAY AND TRANSPORTATION OFFICIALS	EQL SP	EQUALLY SPACED	OPNG	OPENING	±	APPROXIMATELY
AB	ANCHOR BOLT	EQPT	EQUIPMENT	OPP	OPPOSITE	@	AT
ABT	ABOUT	EQUIV	EQUIVALENT	OSHA	OCCUPATIONAL SAFETY AND HEALTH ADMINISTRATION	x	BY
ACI	AMERICAN CONCRETE INSTITUTE	EW	EACH WAY	OZ	OUNCE		CENTERLINE
ACO	AT CONTRACTOR'S OPTION	EXP	EXPANSION	P <sub>a</sub>	PASCAL	°	DEGREE (PLANE ANGLE)
ADH	ADHESIVE	EXST	EXISTING	PCA	PORTLAND CEMENT ASSOCIATION	∅	DIAMETER
AHR	ANCHOR	EXT	EXTERIOR	PCF	POUNDS PER CUBIC FOOT	=	EQUAL
AHU	AIR HANDLING UNIT	f <sub>c</sub>	ULTIMATE COMPRESSIVE STRENGTH OF CONCRETE	PCI	PRESTRESSED CONCRETE INSTITUTE	>	GREATER THAN
AISC	AMERICAN INSTITUTE OF STEEL CONSTRUCTION	FD	FLOOR DRAIN	PED	PEDESTAL	<	LESS THAN
AISI	AMERICAN IRON AND STEEL INSTITUTE	FF	FAR FACE	PJTN	PROJECTION	#	NUMBER, POUND
AL, ALUM	ALUMINUM	FL	FLOOR	PL	PLATE, PROPERTY LINE	%	PERCENT
ALTN	ALTERNATE	FLG	FLANGE	PLCS	PLACES		PLATE, PROPERTY LINE
ANSI	AMERICAN NATIONAL STANDARDS INSTITUTE	f <sub>m</sub>	ULTIMATE COMPRESSIVE STRENGTH OF MASONRY	PLF	POUNDS PER LINEAR FOOT		
ASTM	AMERICAN SOCIETY FOR TESTING AND MATERIALS	FNH	FINISH	PSF	POUNDS PER SQUARE FOOT		
APPROX	APPROXIMATE	FRP	FIBERGLASS REINFORCED PLASTIC	PSI	POUNDS PER SQUARE INCH		
ARCH	ARCHITECTURAL	fs	PERMISSIBLE STEEL STRESS	PRV	PRESSURE RELIEF VALVE		
AWS	AMERICAN WELDING SOCIETY	FS	FAR SIDE	PT	POINT		
BM	BEAM	FT	FEET, FOOT	PVC	POLYVINYL CHLORIDE		
BETW	BETWEEN	Fy, fy	YIELD STRESS	PWS	PLASTIC WATERSTOP		
BO	BOTTOM OF	GA	GAGE, GAUGE	R	RISERS		
BOT	BOTTOM	GAL	GALLON	RAD	RADIUS		
BOS	BOTTOM OF STEEL	GALV	GALVANIZED	RD	ROOF DRAIN		
BRG	BEARING	GRTG	GRATING	REF	REFERENCE		
CAP	CAPACITY	GS	GRATING SUPPORT	REINF	REINFORCEMENT		
CB	CORNER BAR	H	HIGH	REQD	REQUIRED		
CC	CLEAR COVER	HK	HOOK	RJ	ROUGHENED JOINT		
CE	CONCRETE EDGE	HNDRL, HR	HANDRAIL	S	SOUTH		
CGF	COMPACTED GRANULAR FILL	HORIZ	HORIZONTAL	SD	SUBDRAIN		
CHKR	CHECKERED	HP	HORSEPOWER	SE	SOUTHEAST, STEEL EDGE		
CIRC	CIRCULAR	HPT	HIGH POINT	SECT	SECTION		
CIS	CENTERED IN SLAB	HS	HIGH STRENGTH	SHT	SHEET		
CIW	CENTERED IN WALL	HVAC	HEATING, VENTILATION, AND AIR CONDITIONING	SIM	SIMILAR		
CJ	CONSTRUCTION JOINT	IF	INNER FACE	SJ	SAWED JOINT		
CLJ	CONTROL JOINT	INVT	INVERT	SLO	SHORT LEG OUTSTANDING		
CLR	CLEAR	IJ	ISOLATION JOINT	SLV	SLEEVE		
CM	CENTIMETER	JT	JOINT	SP	SPACES		
CMU	CONCRETE MASONRY UNIT	K	KIP	SPECS	SPECIFICATIONS		
CO	CONCRETE OPENING	kg	KILOGRAM	SQ	SQUARE		
COL	COLUMN	kN	KILONEWTON	SST	STAINLESS STEEL		
CONC	CONCRETE	KSF	KIPS PER SQUARE FOOT	ST	SINGLE TEE		
CONN	CONNECTION	KSI	KIPS PER SQUARE INCH	STD	STANDARD		
CONSTR	CONSTRUCTION	L	ANGLE, LADDER	STIFF	STIFFENER		
CONT	CONTINUOUS	LB	POUND	STIR	STIRRUP		
COR	CORNER	LG	LENGTH, LONG	STL	STEEL		
CRSI	CONCRETE REINFORCING STEEL INSTITUTE	LLH	LONG LEG HORIZONTAL	STRL	STRUCTURAL		
CTR	CENTER	LLV	LONG LEG VERTICAL	STRUCT	STRUCTURE		
CWB	CAPILLARY WATER BARRIER	LLO	LONG LEG OUTSTANDING	SYMM	SYMMETRICAL		
CY	CUBIC YARD	LONG	LONGITUDINAL	SW	SOUTHWEST		
db	BAR DIAMETER	LP	LOW POINT	T	TON, TREAD, THICKNESS		
DGA	DENSE GRADED AGGREGATE	LS	LAP SPICE	TEMP	TEMPERATURE, TEMPORARY		
D.I.	DUCTILE IRON	M	METER	THRU	THROUGH		
DIA	DIAMETER	MATL	MATERIAL	T&B	TOP AND BOTTOM		
DIAG	DIAGONAL	MAX	MAXIMUM	T.O.	TOP OF		
DIM	DIMENSION	MECH	MECHANICAL	TOC	TOP OF CONCRETE		
DT	DOUBLE TEE	MEZZ	MEZZANINE	TOG	TOP OF GRATING		
DWG	DRAWING	MFR	MANUFACTURE(R)	TOS	TOP OF STEEL		
DWL	DOWEL	MH	MANHOLE	TSF	TONS PER SQUARE FOOT		
E	EAST	MIN	MINIMUM	TYP	TYPICAL		
EA	EACH	MJ	MECHANICAL JOINT	UBC	UNIFORM BUILDING CODE		
ED	EQUIPMENT DRAIN	MM	MILLIMETER	UNO	UNLESS NOTED OTHERWISE		
EF	EACH FACE	MPa	MEGAPASCAL	VERT	VERTICAL		
EJ	EXPANSION JOINT	N	NORTH	W	WEST, WIDE		
EL	ELEVATION	NE	NORTHEAST	WD	WIDTH		
ELEC	ELECTRICAL	NF	NEAR FACE	WP	WORK POINT		
EMBED	EMBEDMENT	NO	NUMBER	WS	WATERSTOP		
EP	EQUIPMENT PAD	NOM	NOMINAL	WT	WEIGHT, WATERTIGHT		
		NS	NEAR SIDE	WW	WASTEWATER		
		NTS	NOT TO SCALE	WWF	WELDED WIRE FABRIC		
		NW	NORTHWEST	W/	WITH		
		OC	ON CENTER	W/O	WITHOUT		
				YD	YARD		


MATERIALS LEGEND

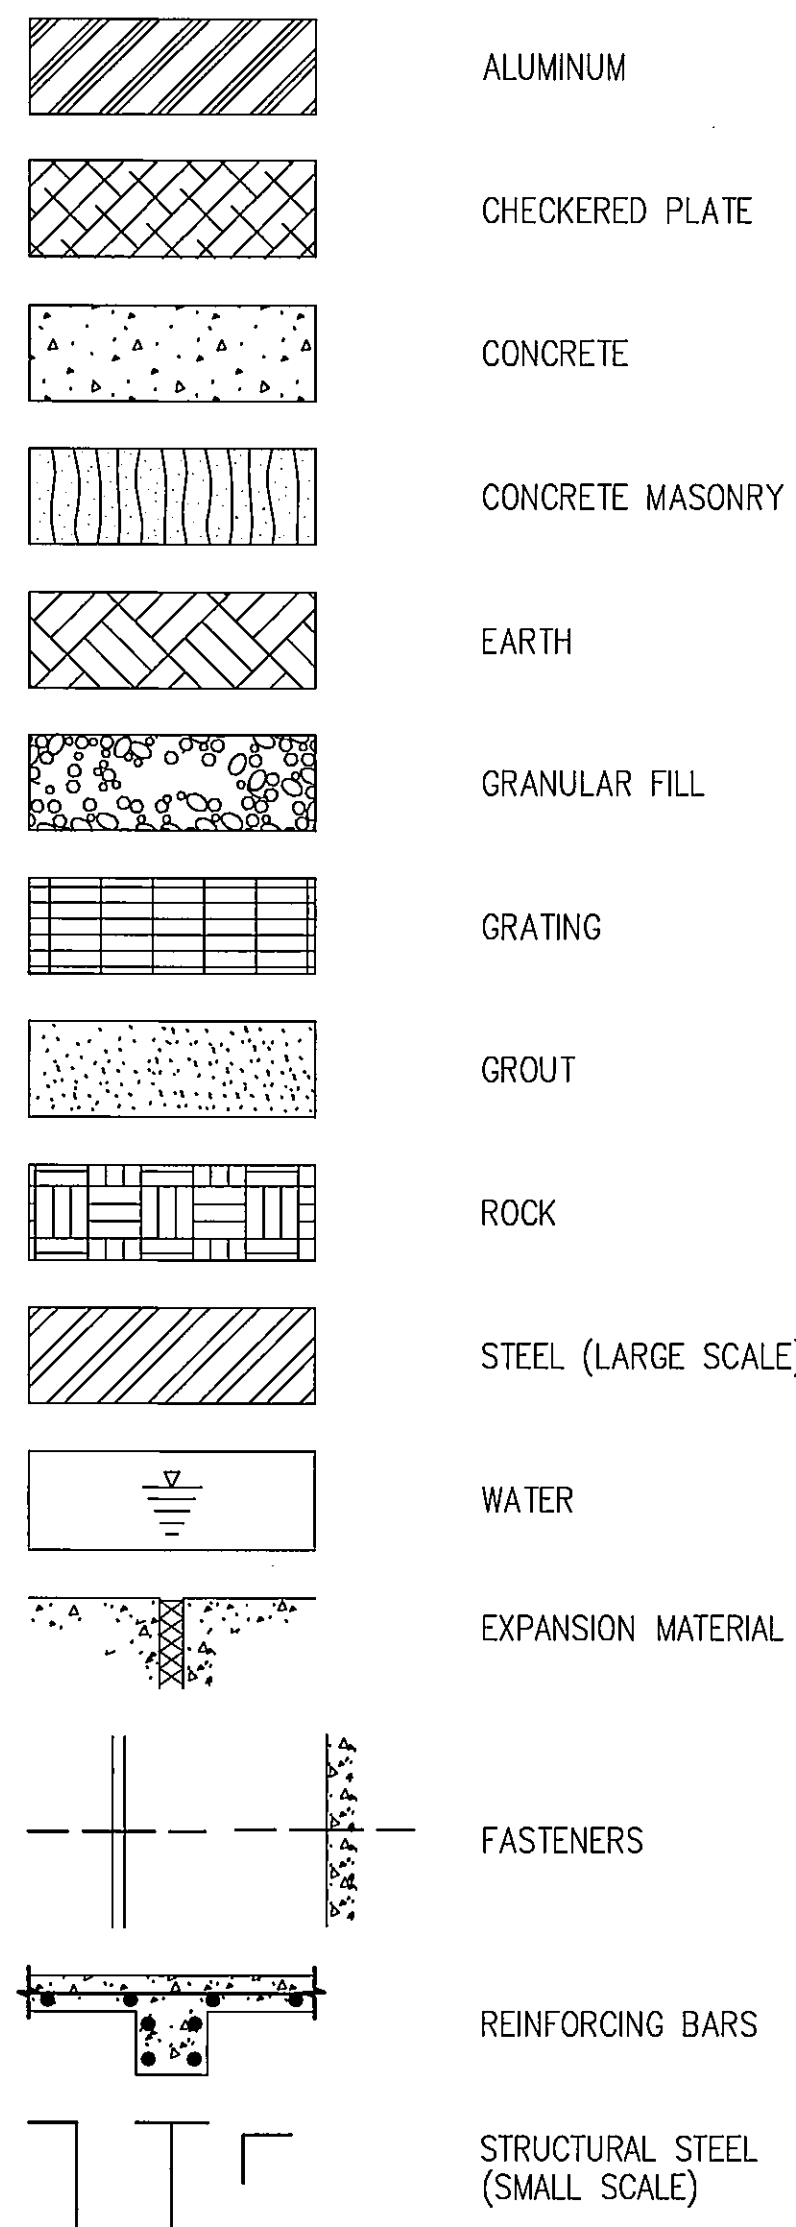

CONCRETE REINFORCING BAR NOMENCLATURE

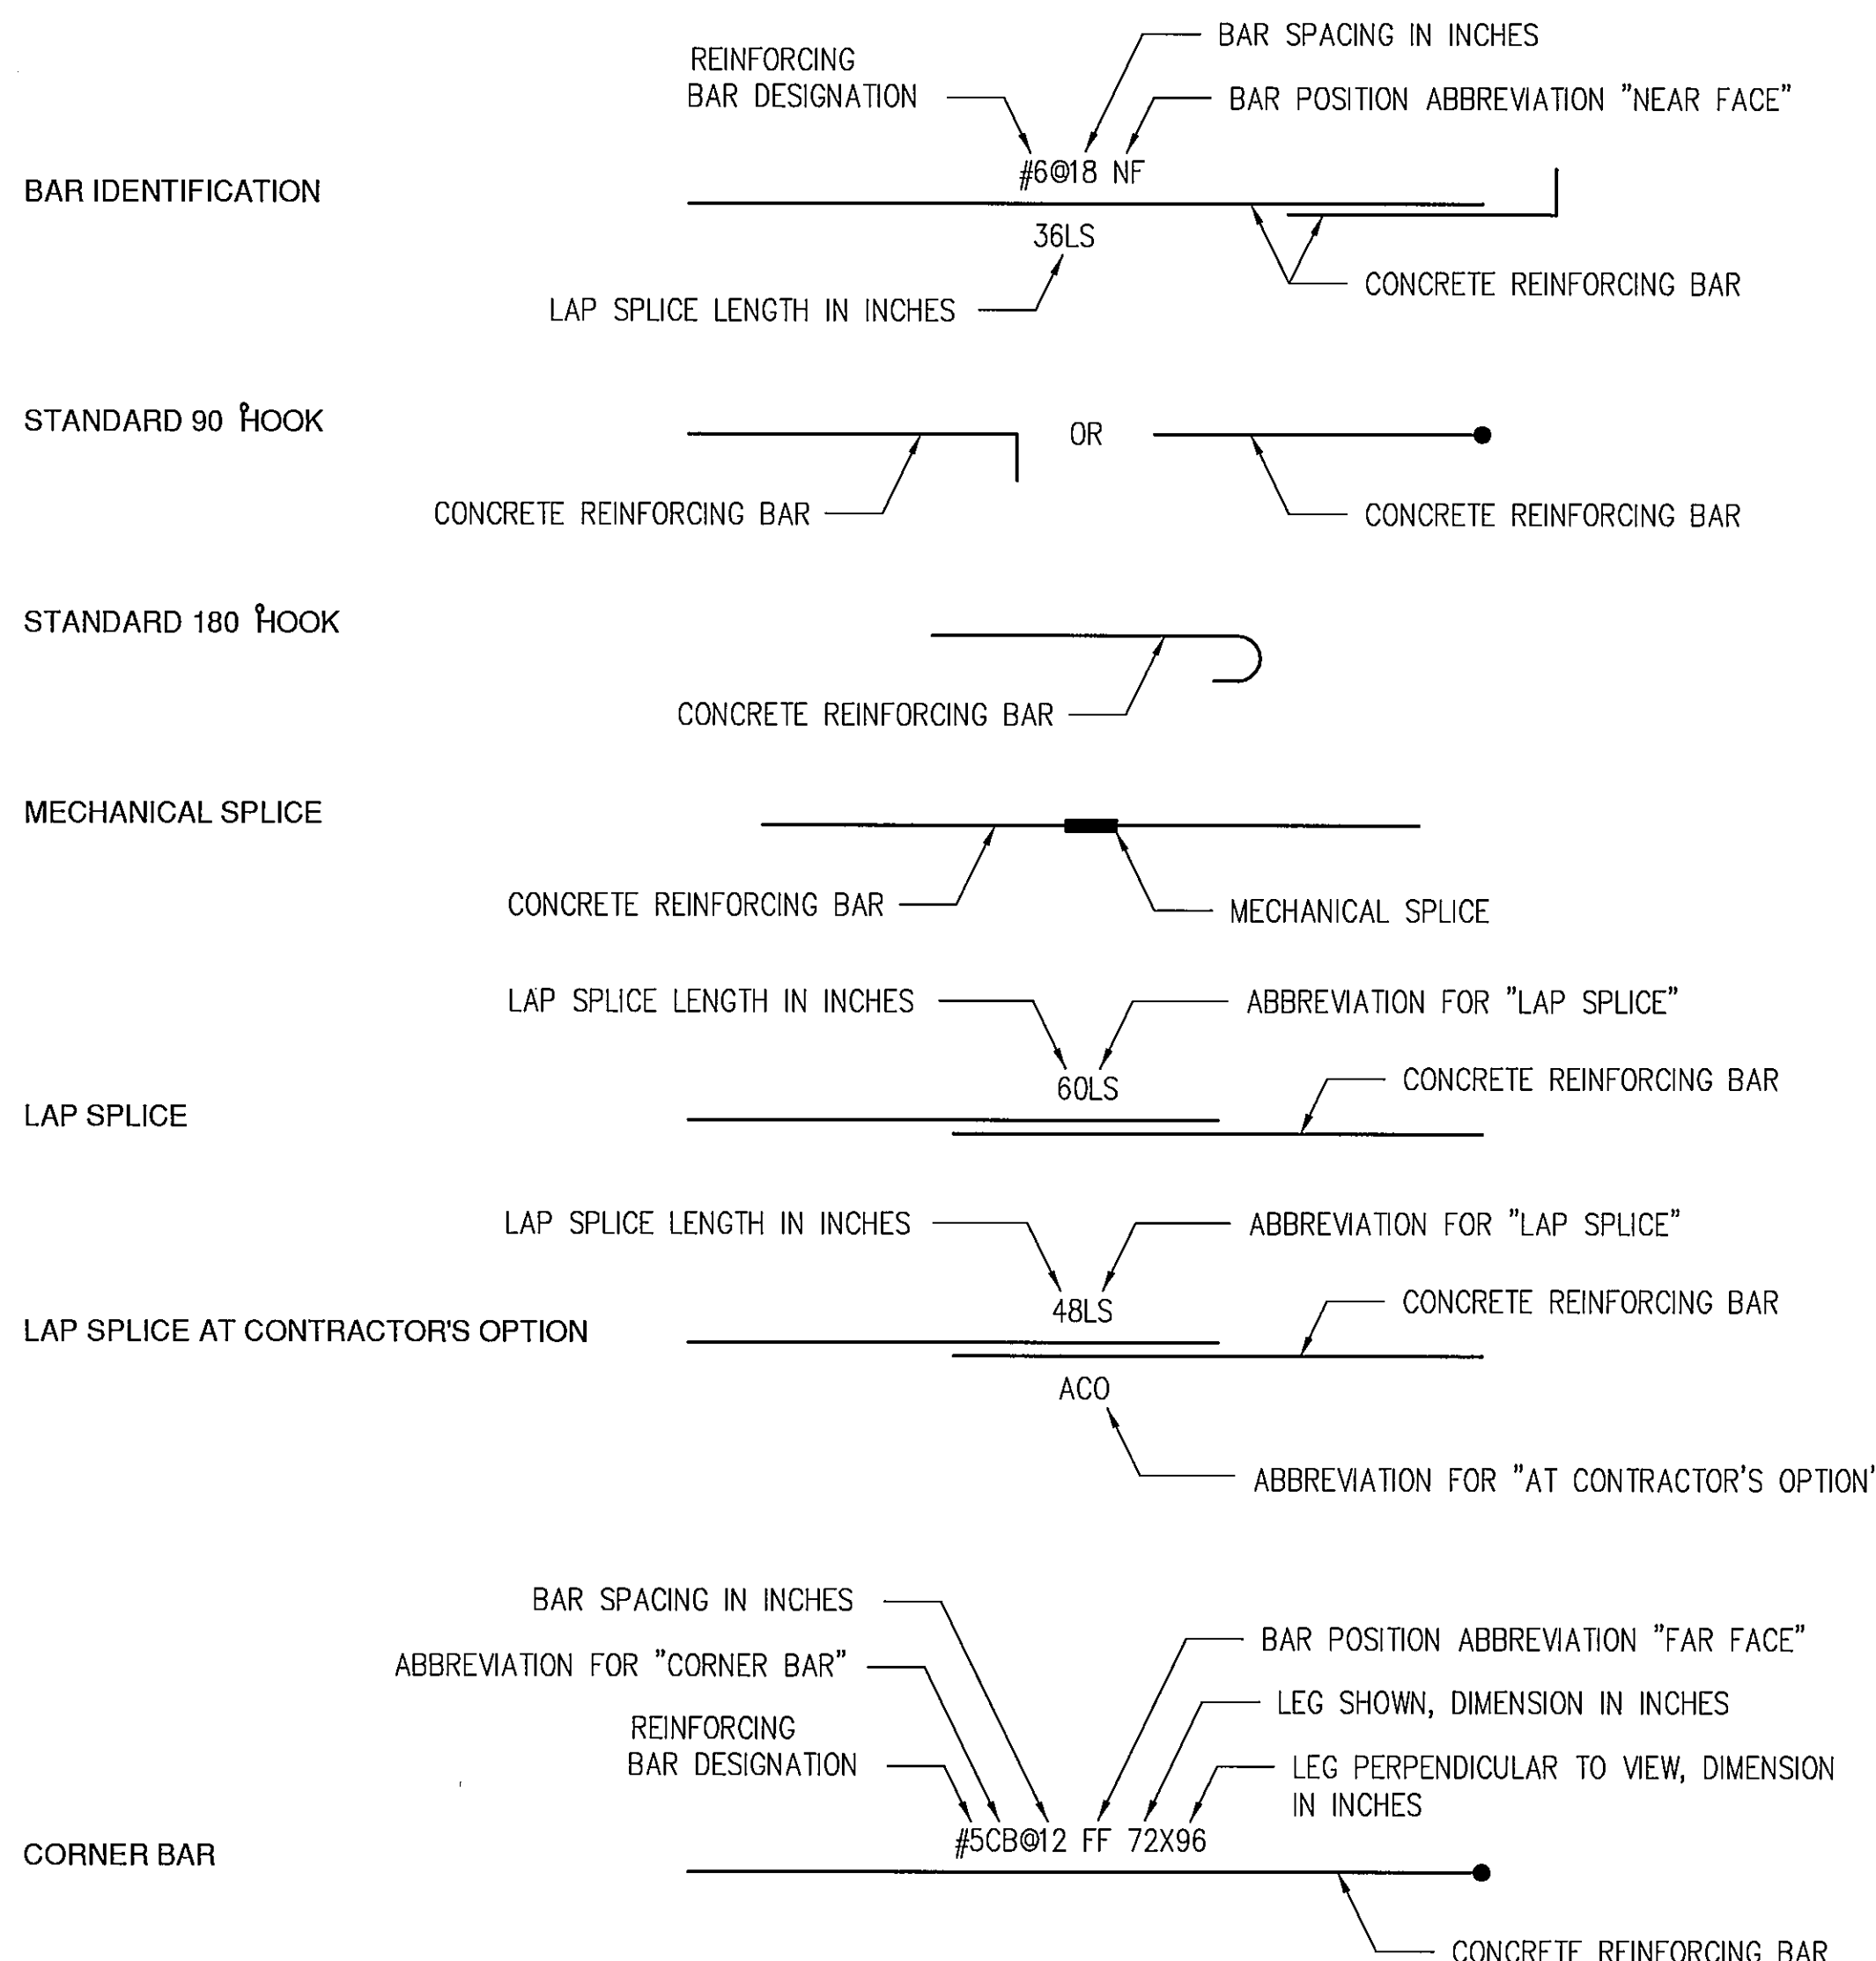

“AS-BUILT”

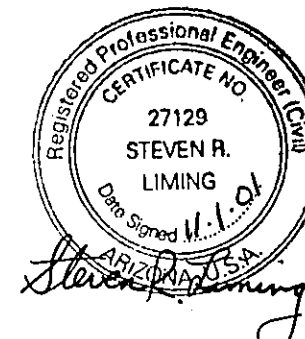

date	NOV. 10, 1999	detailed	J. ROUTON
designed	L. BUCK	checked	B.B.




LONDON BRIDGE BEACH PUMP HOUSE

STRUCTURAL LEGEND






project	97-777-1-002	contract	W-183-00
drawing	S1	rev.	
sheet	5	of	21 sheets
file	Lbbphs01.dwg		03-17-2000 12:36 JLR

COPYRIGHT © 2000 BURNS AND McDONNELL ENGINEERING COMPANY, INC.

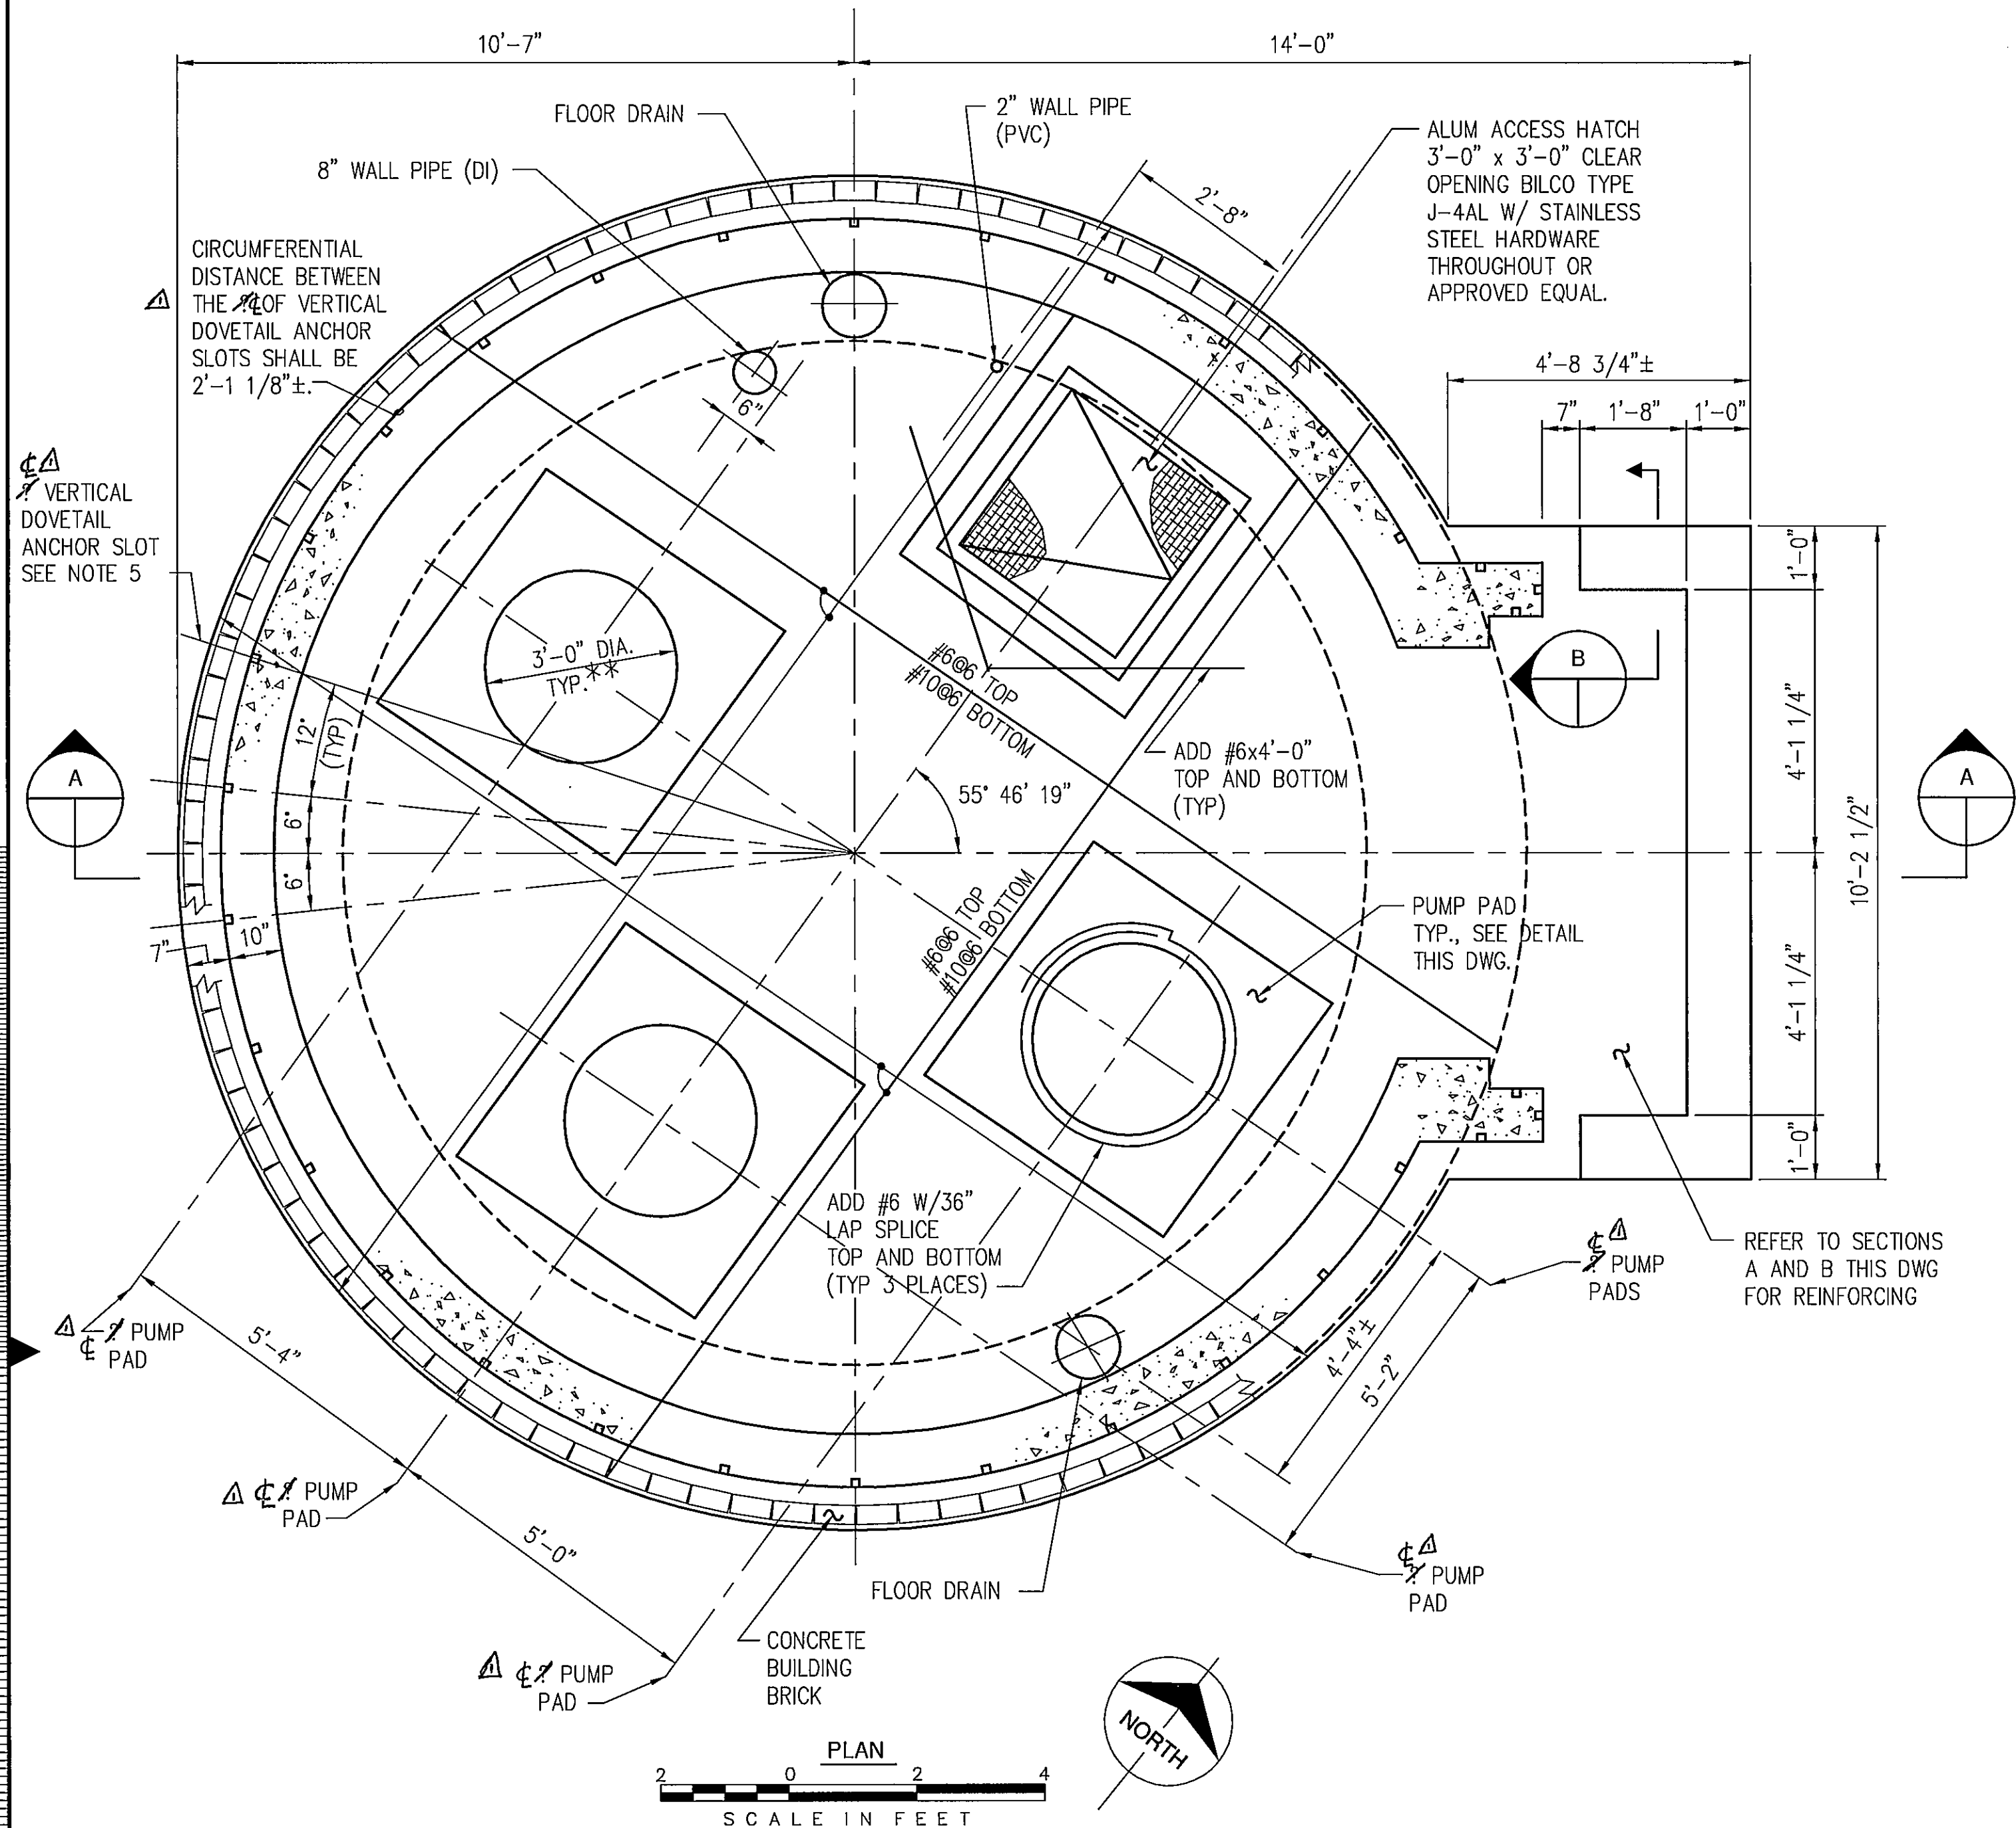

GENERAL NOTES FOR PUMP HOUSE :


1. CONCRETE COMPRESSIVE STRENGTH,  $f'_c = 4000$  psi.
2. CONCRETE REINFORCEMENT, ASTM A615 GRADE 60.
3. STRUCTURAL STEEL:
  - a. STRUCTURAL TUBING, ASTM A500, GRADE C.
  - b. STRUCTURAL STEEL ASTM A36.
4. MASONRY:
  - a. COMPRESSIVE STRENGTH,  $f'_m = 1500$  psi.
  - b. CONCRETE BUILDING BRICK TO BE TINTED SPLIT-FACE IN "TAN" COLOR.
  - c. PROVIDE EXPANSION JOINTS IN CONCRETE BUILDING BRICK AT 16'-0". CENTERS MAXIMUM SPACING.
  - d. ALL MASONRY SHALL BE SPECIALLY INSPECTED PER 1997 UBC.
5. DOVETAIL ANCHOR SLOT AND ANCHORS:
  - a. 24 GAGE, ZINC ALLOY, 1" WIDE x 1" DEEP x 5/8" THROAT
  - b. DOVETAIL ANCHORS SHALL BE LOCATED AT VERTICAL SPACING PER SPECIFICATIONS.
  - c. BOTTOM OF DOVETAIL ANCHOR SLOT SHALL BE 1'-2" ABOVE FINISH FLOOR.
6. \*\* INDICATES DIMENSIONS OR ELEVATIONS TO BE VERIFIED BY CONTRACTOR. IF DIMENSION OR ELEVATION DIFFERS, CONTRACTOR SHALL NOTIFY ENGINEER IN WRITING.
7. CONTRACTOR SHALL BE RESPONSIBLE FOR COORDINATING AND PROVIDING ALL OPENINGS AS REQUIRED FOR MECHANICAL, ELECTRICAL AND PROCESS EQUIPMENT.
8. REINFORCE ALL WALL PENETRATIONS PER DETAILS CO-1 AND CO-2 AS WELL AS PROVIDE CLOSURES AT OPENINGS. REFER TO DRAWING S4.
9. CONTRACTOR SHALL REMOVE AND DISPOSE OF TEMPORARY CAISSON COVER, REFER TO LAYNE DRAWINGS 35-5520 SHEETS 1 AND 2. SEE NOTE 10.
10. UPON CONTRACTOR'S REQUEST IN WRITING, THE CITY OF LAKE HAVASU CITY WILL PROVIDE REFERENCE DRAWINGS OF THE EXISTING CAISSON, DESIGNED AND CONSTRUCTED BY RANNEY DIVISION, LAYNE CHRISTENSEN COMPANY.

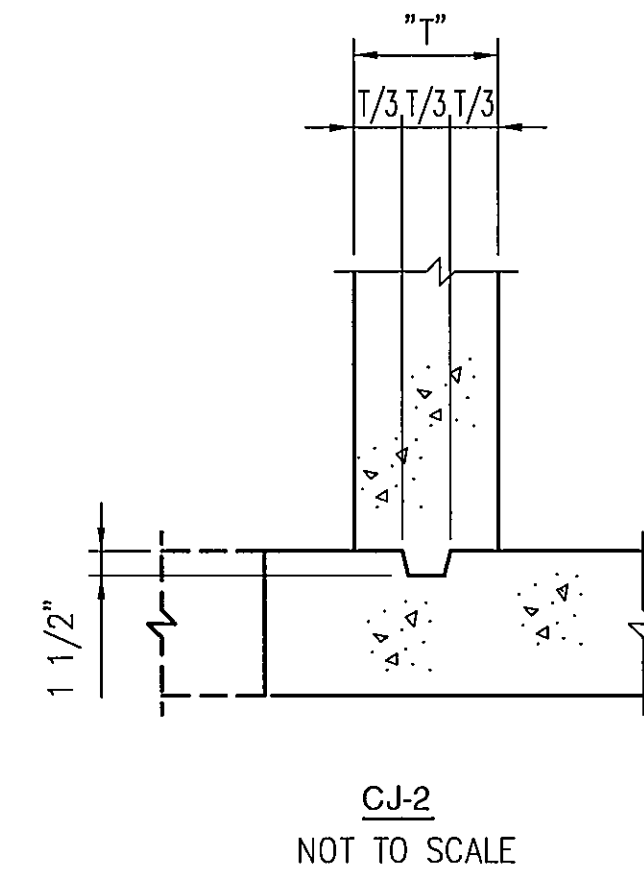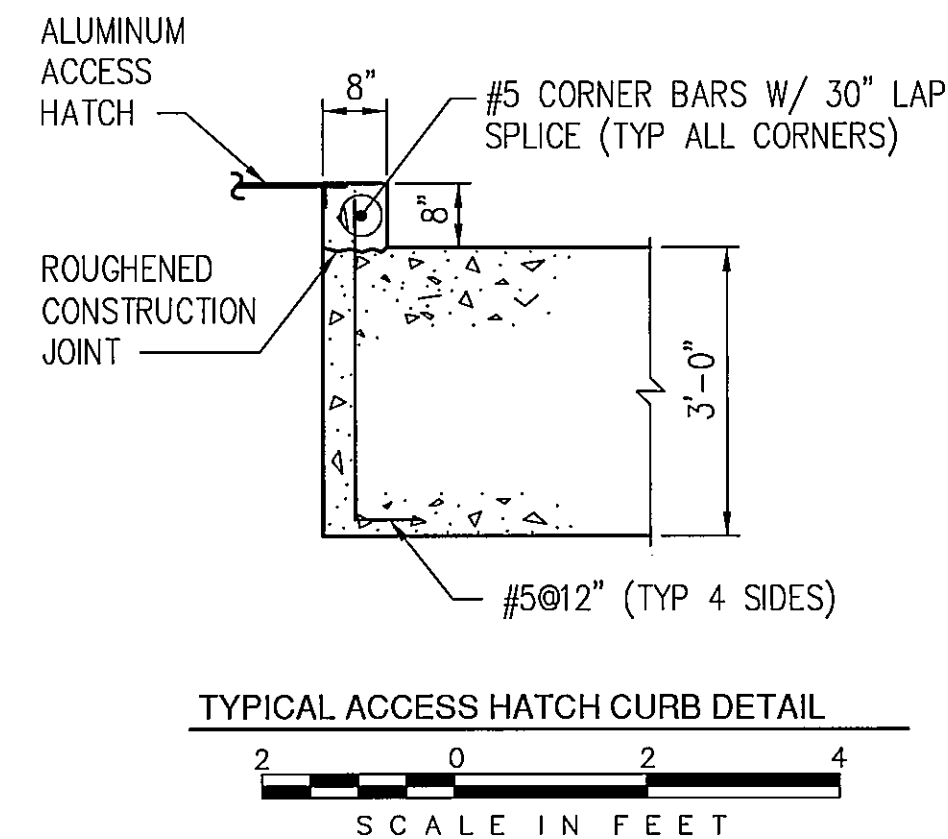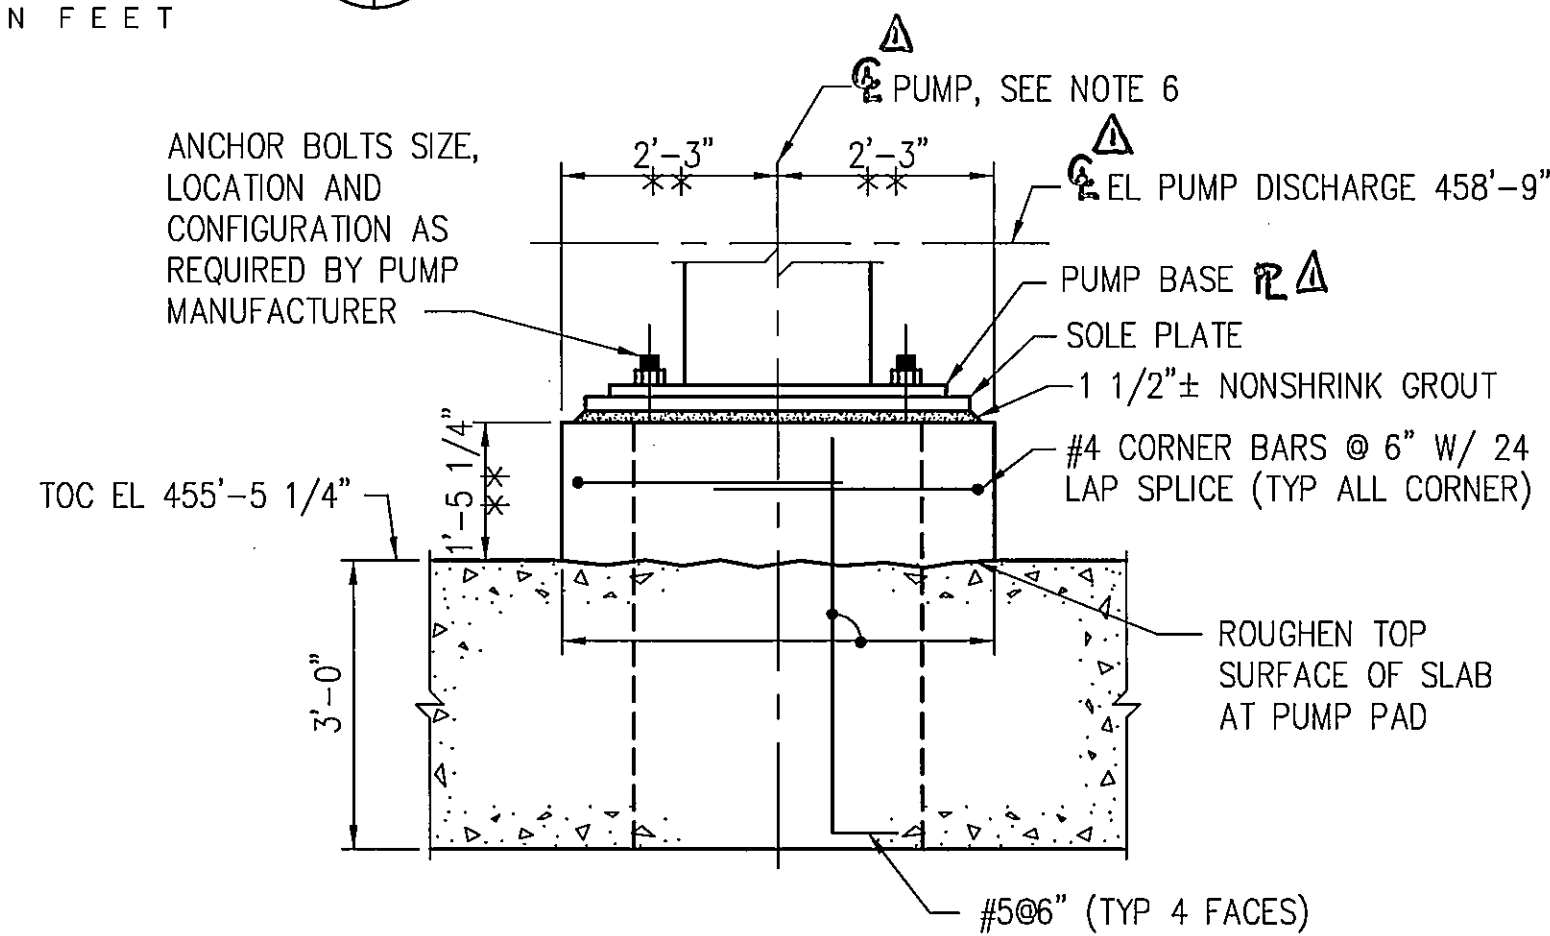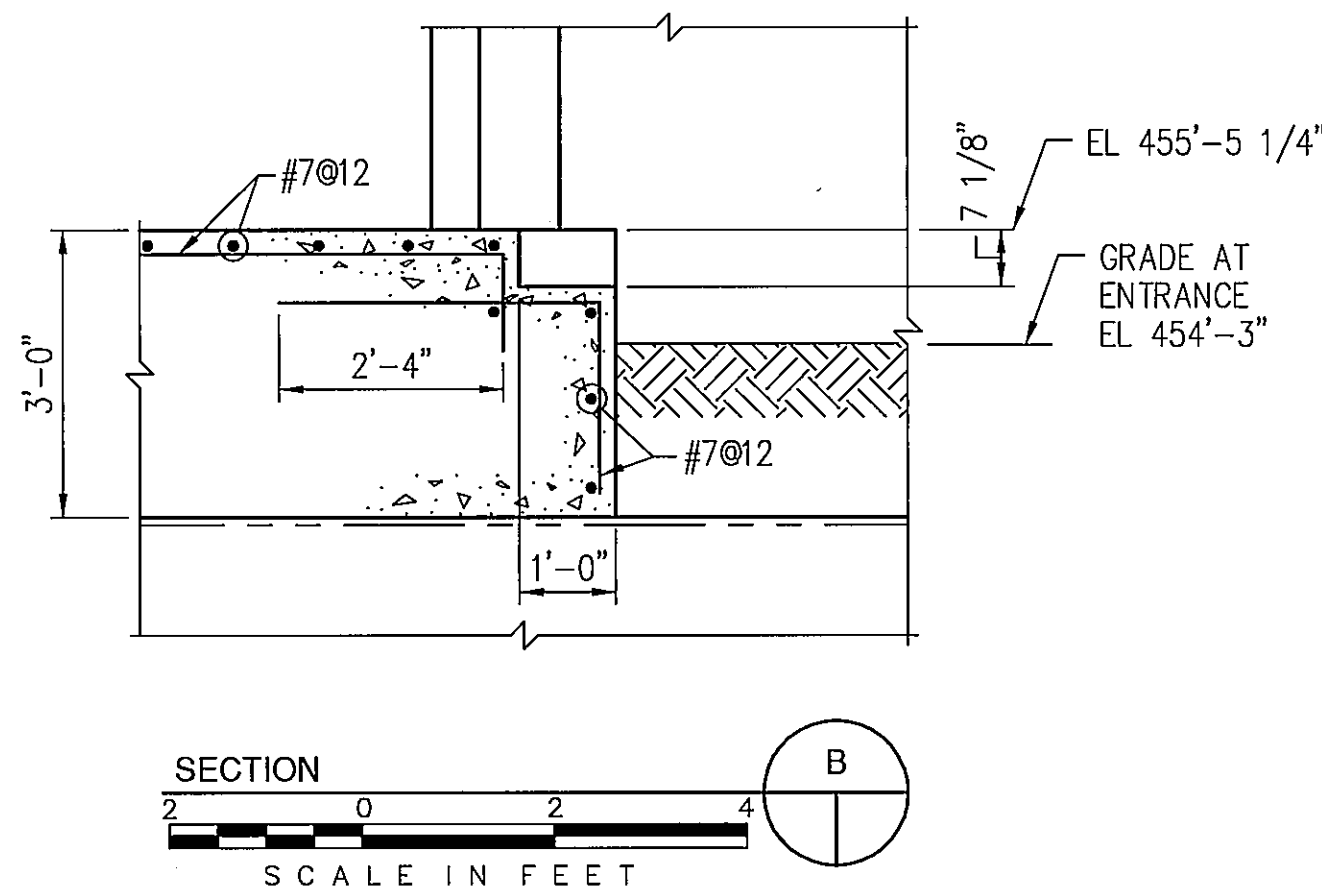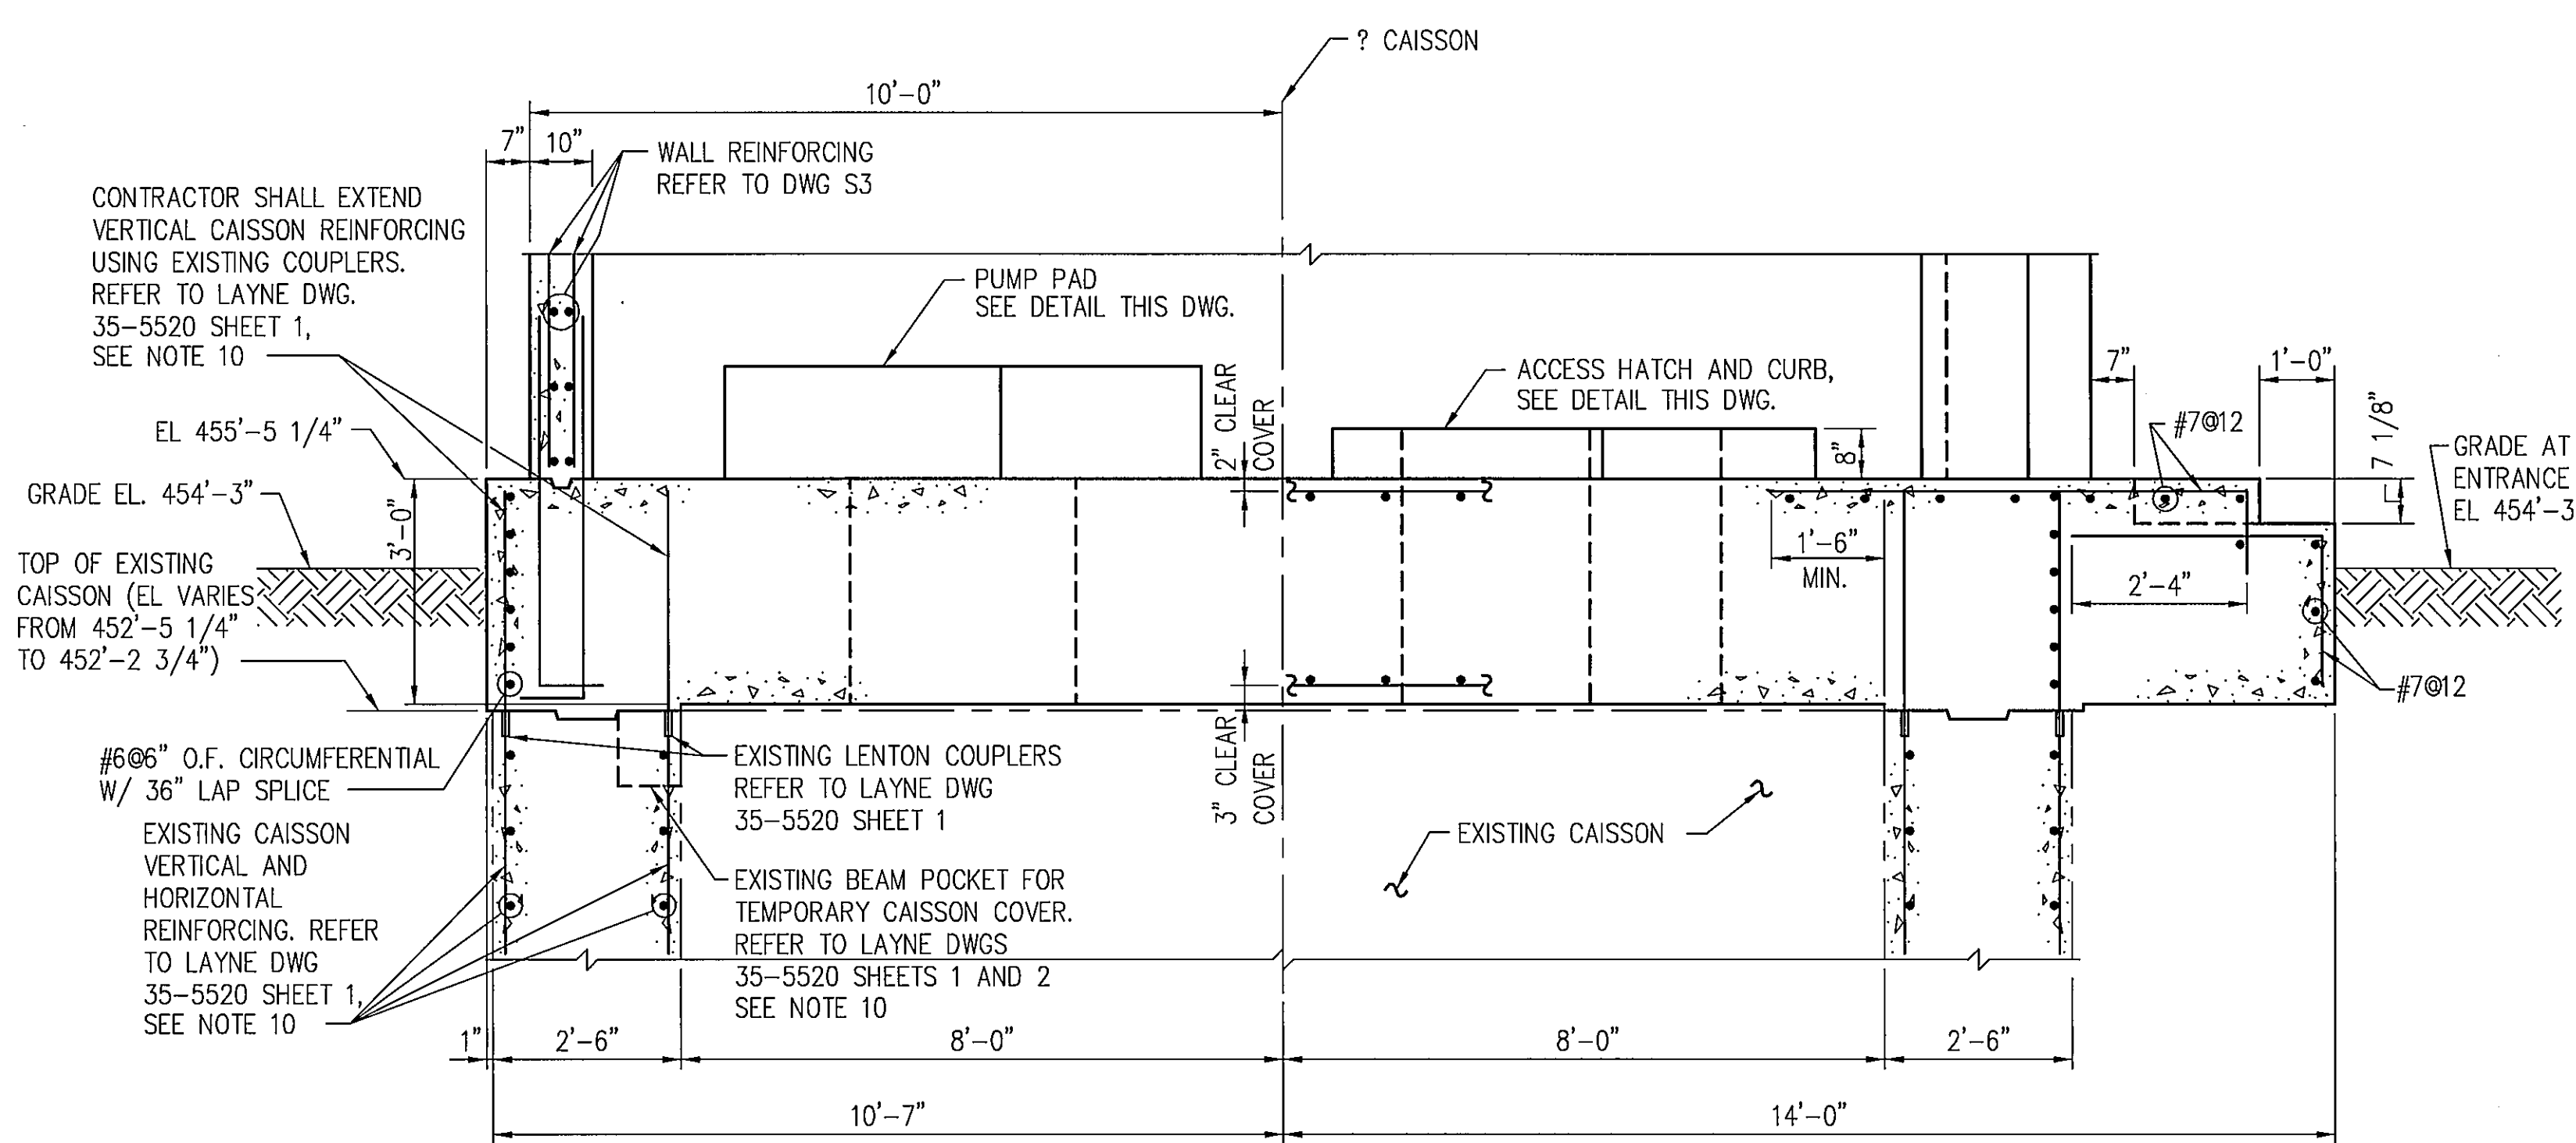

no.	date	by	revision
1	8-15-01	JDF	AS-BUILT




date NOV. 17, 1999  
designed L. BUCK  
detailed J. ROUTON  
checked B.B.

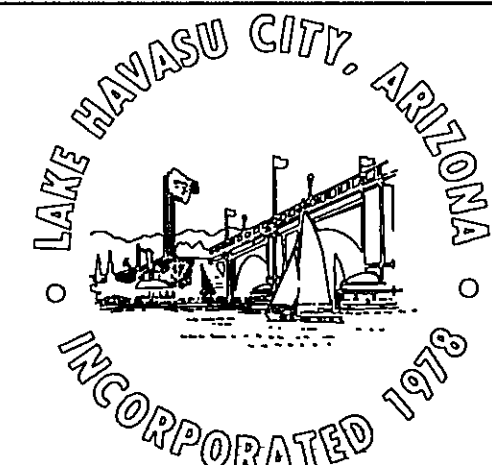

LONDON BRIDGE BEACH PUMP HOUSE

FOUNDATION PLAN AND DETAILS

project 97-777-1-002	contract W-183-00
drawing S2	rev. 1
sheet 6 of 21	sheets
file	

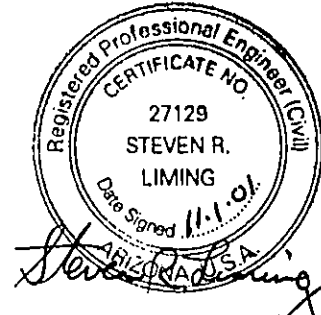

"AS-BUILT"





COPYRIGHT © 2000 BURNS AND MCDONNELL ENGINEERING COMPANY, INC.

NOTES:

1. CONTRACTOR SHALL GROUND THESE TWO CONNECTIONS SHOWN ACCORDING TO ELECTRICAL DRAWING E3.
2. MITER AND CUT CHANNEL TO ALLOW STRUCTURAL STEEL TUBE TO BEAR UNIFORMLY ON BEARING AT CORNERS.


no.	date	by	revision
1	8-15-01	JDF	REVISED TS LOCATIONS & MODIFIED LIFTING EYE DETAIL
2	8-15-01	JDF	AS-BUILT

ROOF PLAN  
SCALE IN FEET

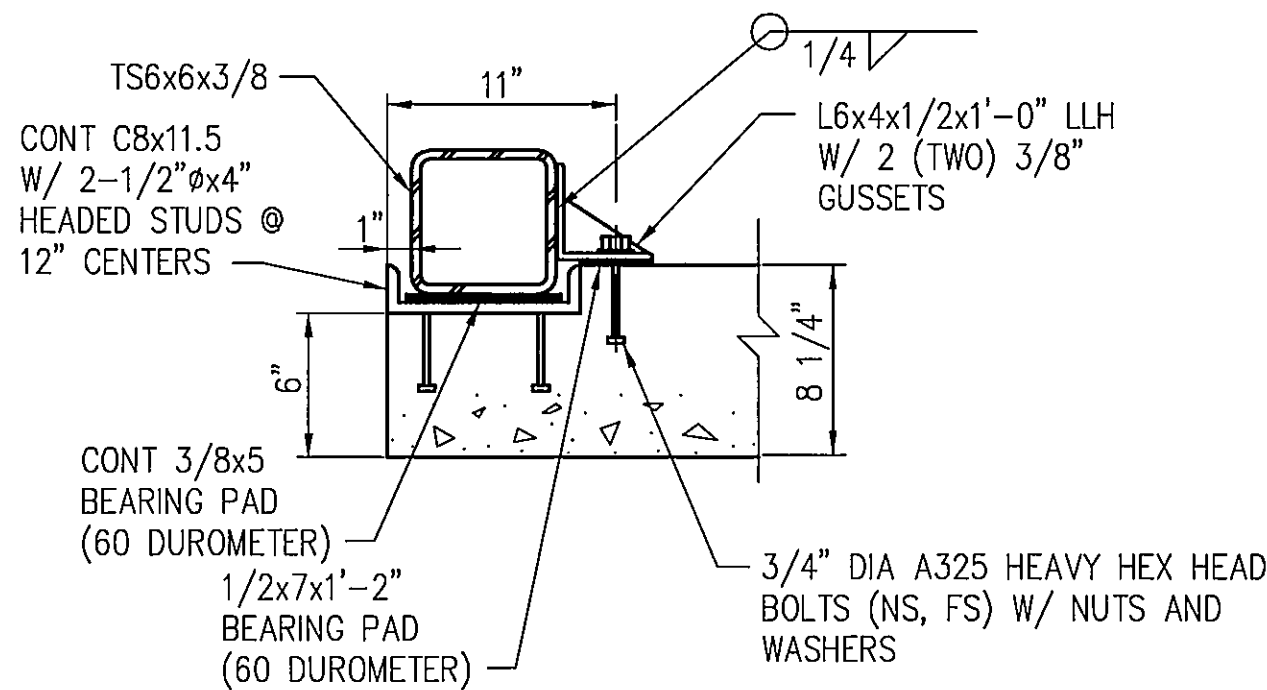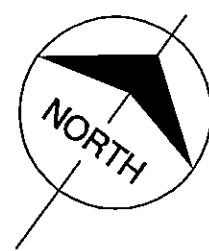

SECTION  
SCALE IN FEET

SECTION  
SCALE IN FEET

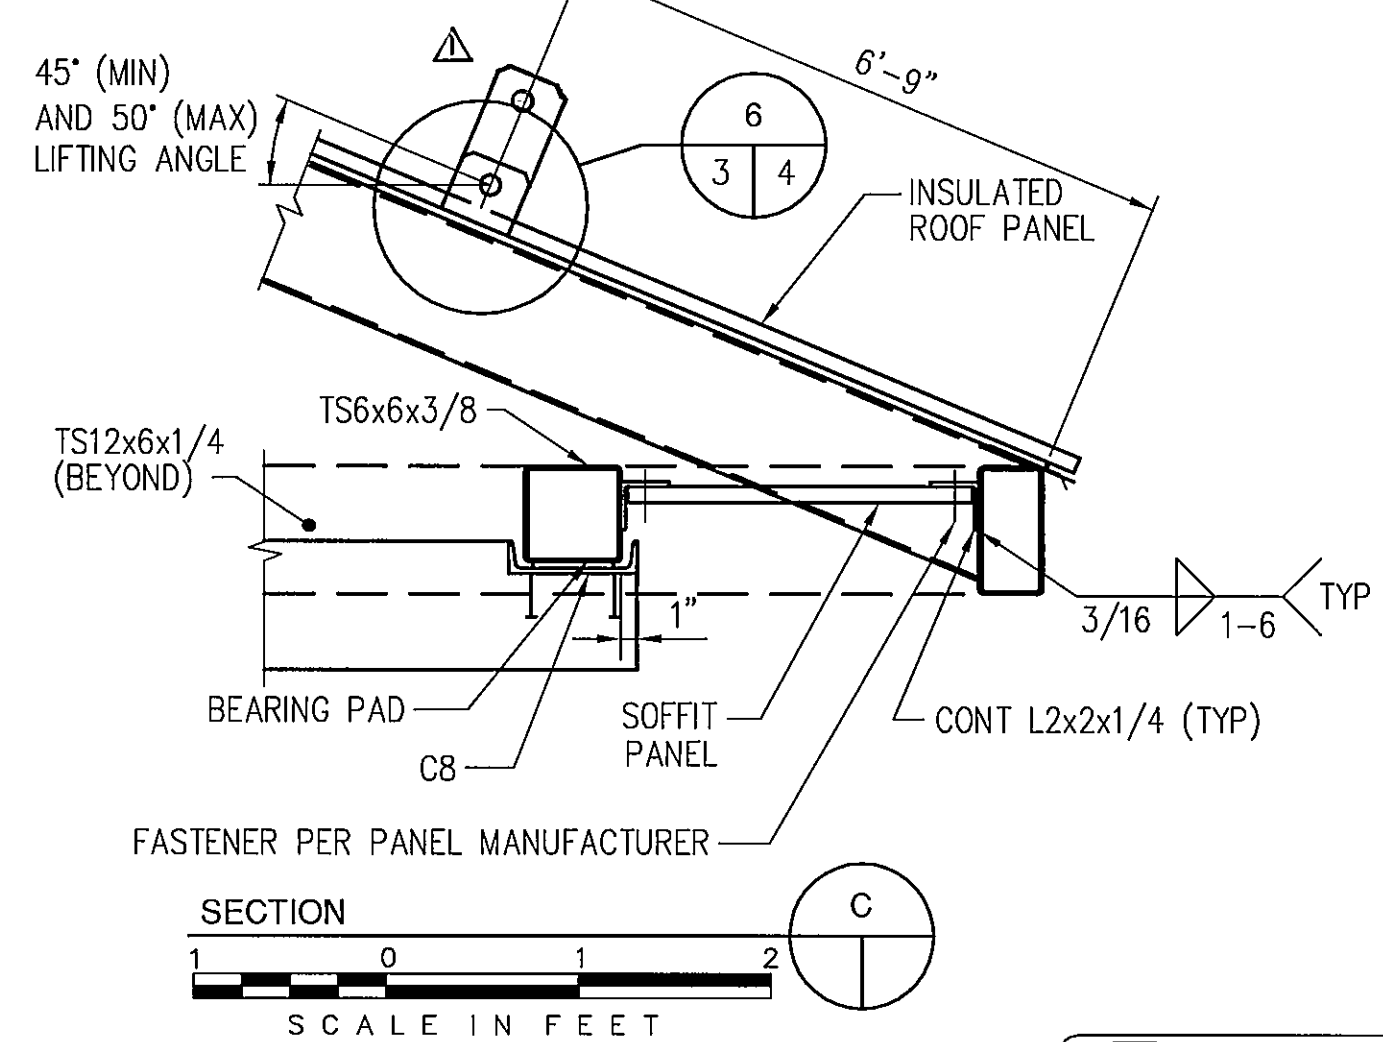

“AS-BUILT”

CALL TWO WORKING DAYS BEFORE YOU DIG  
1-800-STAKE-IT  
1-800-782-5348  
(OUTSIDE MARICOPA COUNTY)







date NOV. 10, 1999  
designed C. LEATON  
detailed J. ROUTON  
checked B.B.



LONDON BRIDGE BEACH PUMP HOUSE  
ROOF PLAN AND DETAILS  
project 97-777-1-002 contract W-183-00  
drawing S3 rev. 1  
sheet 7 of 21 sheets  
file Lbbphs03.dwg 03-23-2000 14:00 JLR



Millimeters  
Inches  
Scale For Microfilming

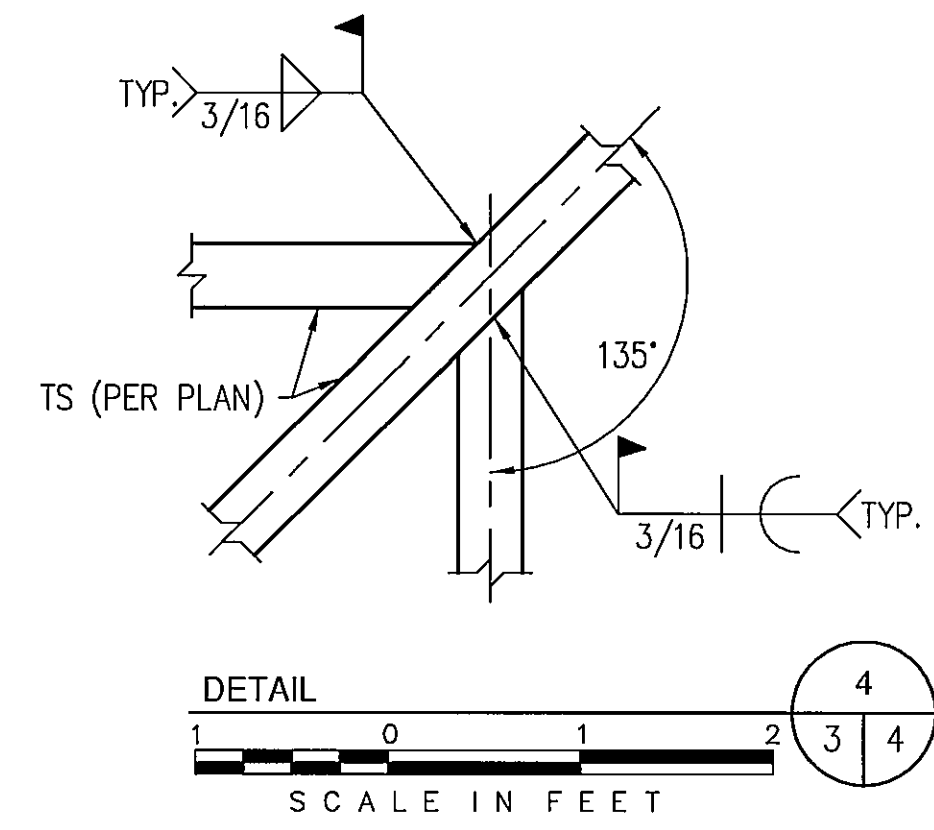
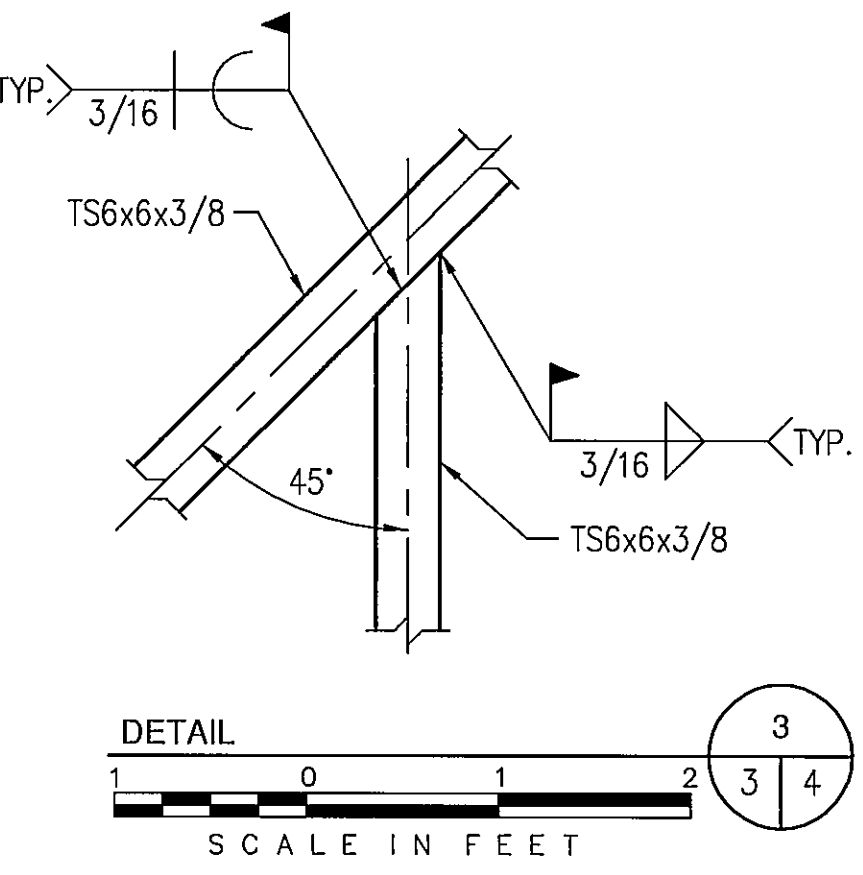
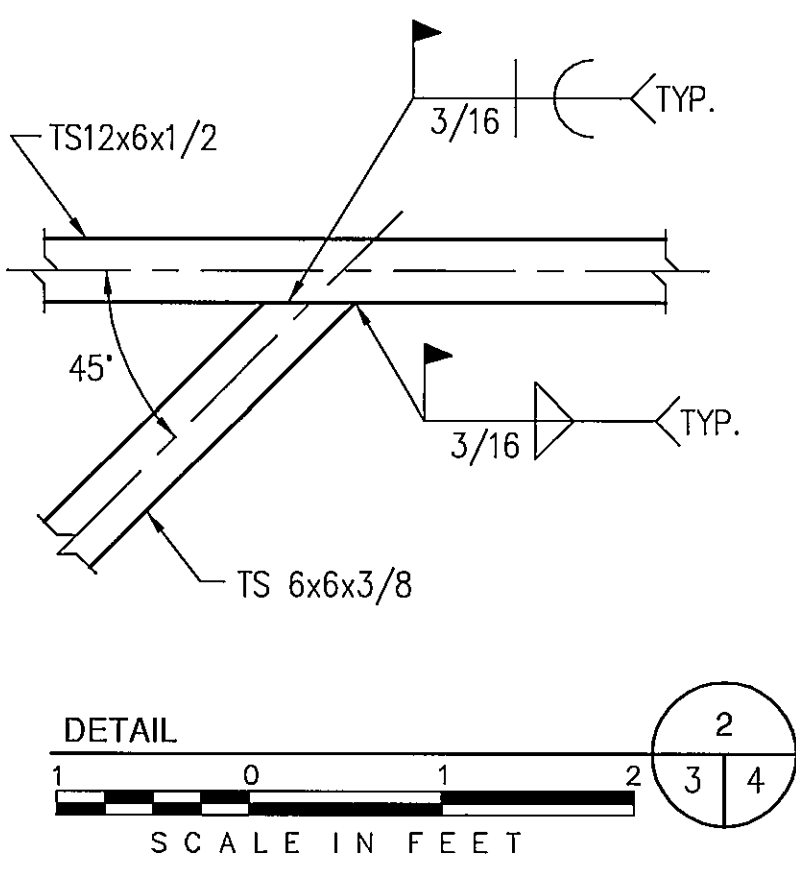
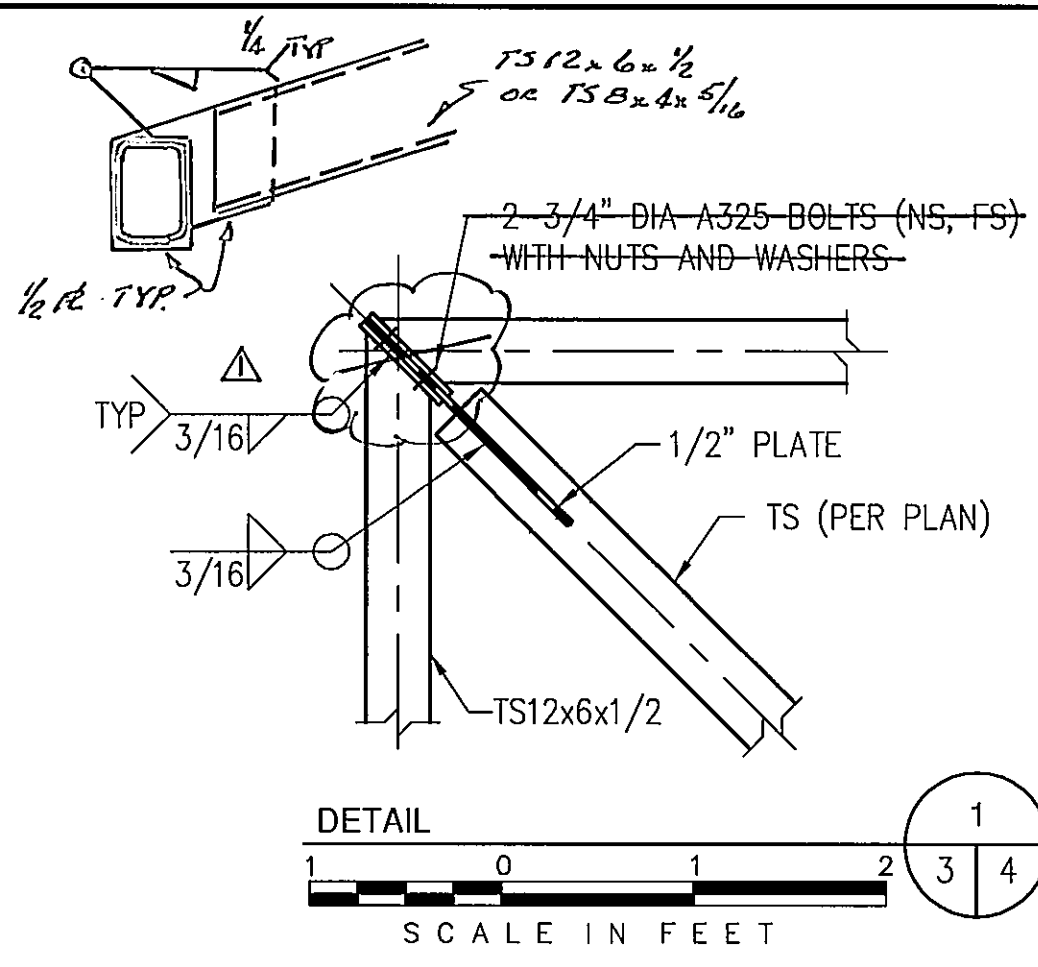


DETAIL  
SCALE IN FEET  
1 2 3 4

DETAIL  
SCALE IN FEET  
1 2 3 4

DETAIL  
SCALE IN FEET  
1 2 3 4

DETAIL  
SCALE IN FEET  
1 2 3 4

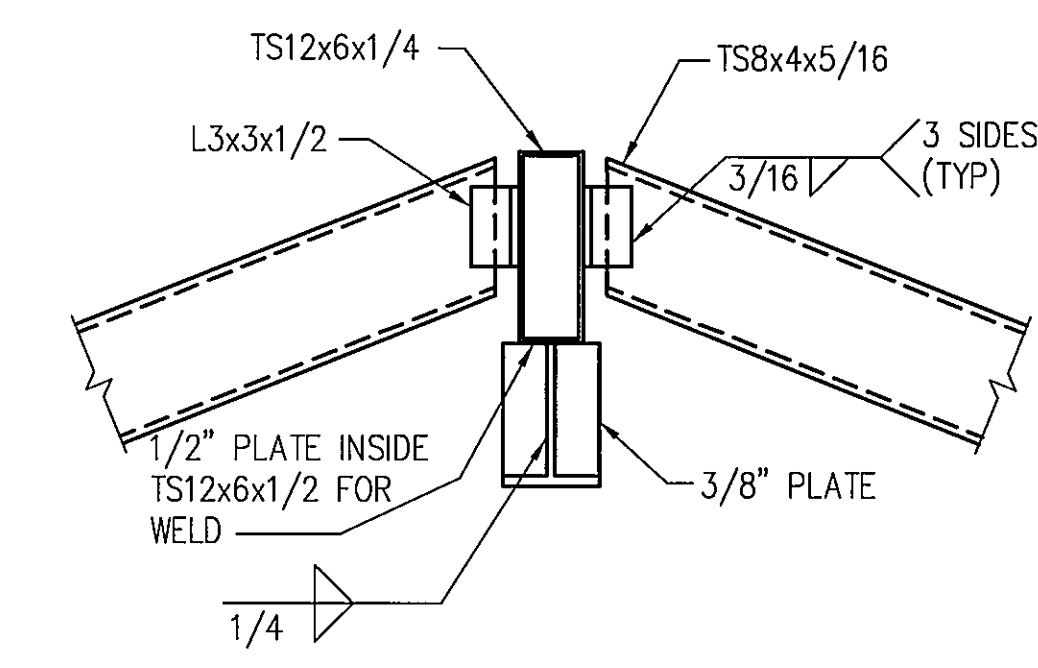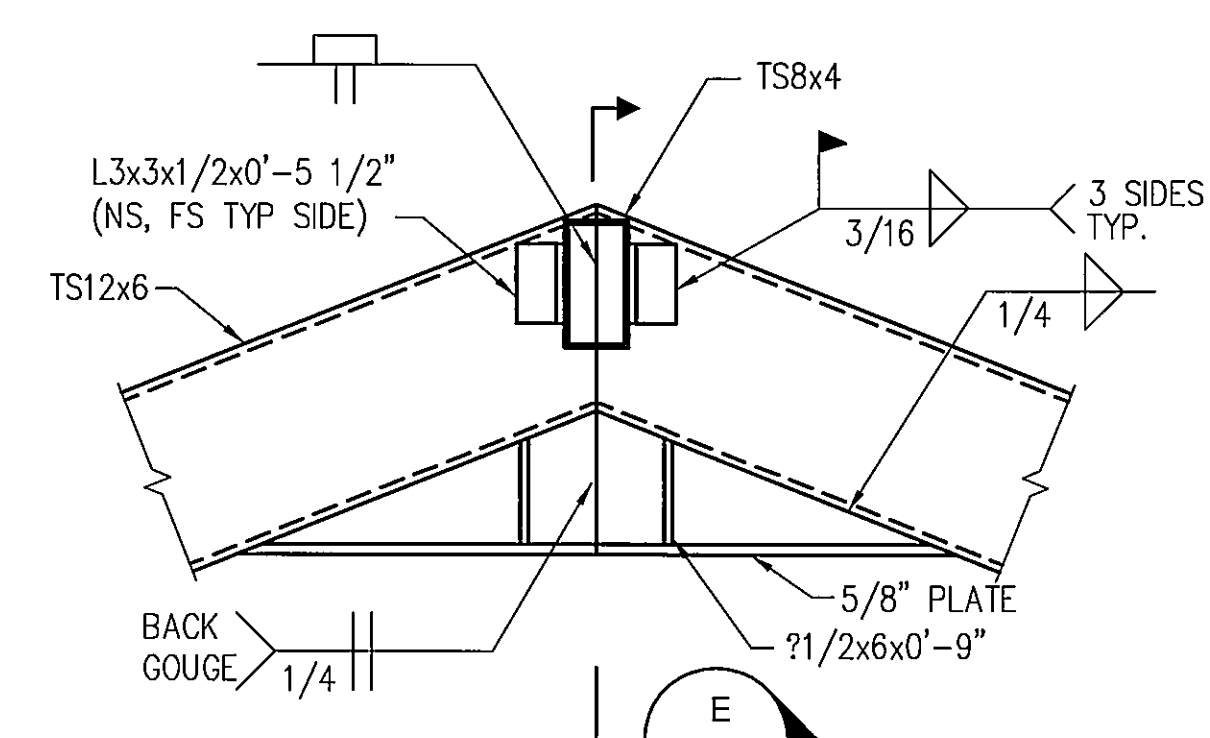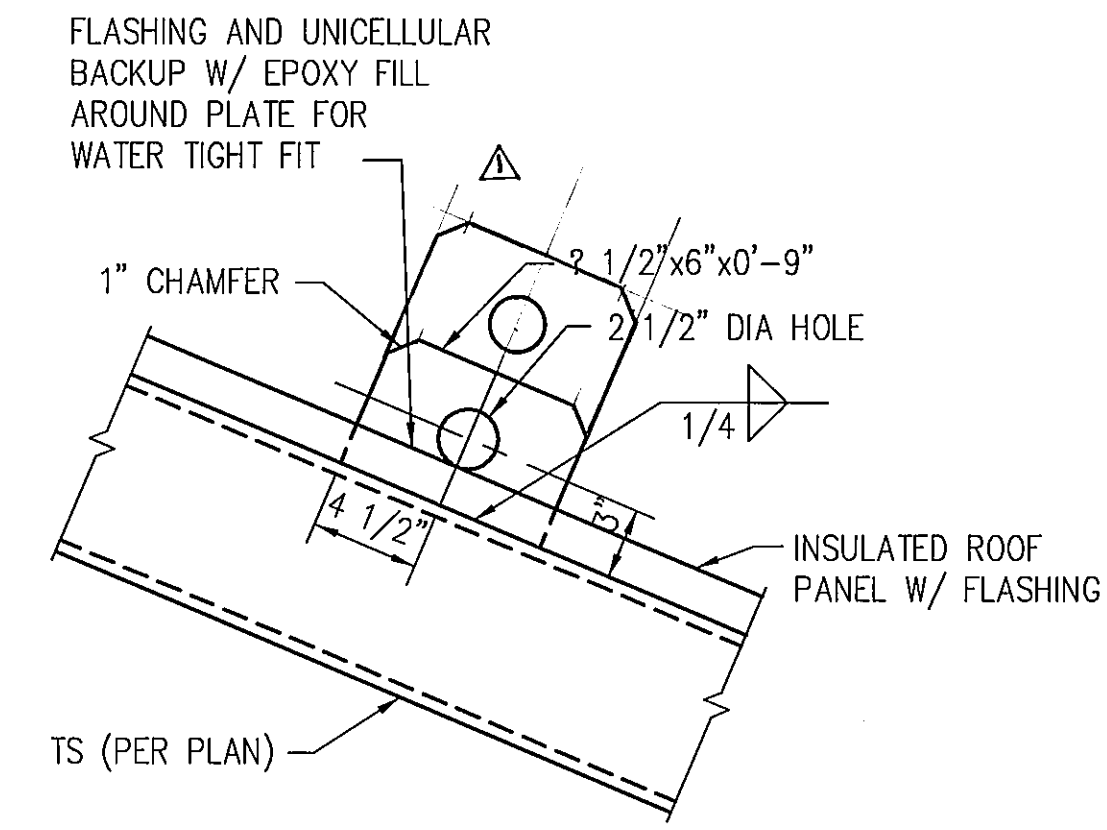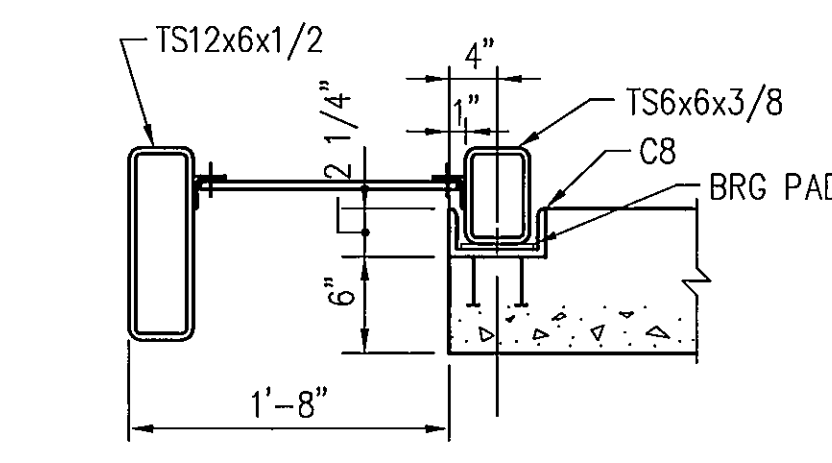


DETAIL  
SCALE IN FEET  
1 2 3 4



DETAIL  
SCALE IN FEET  
1 2 3 4

SECTION  
SCALE IN FEET  
1 2 3 4

SECTION  
SCALE IN FEET  
1 2 3 4

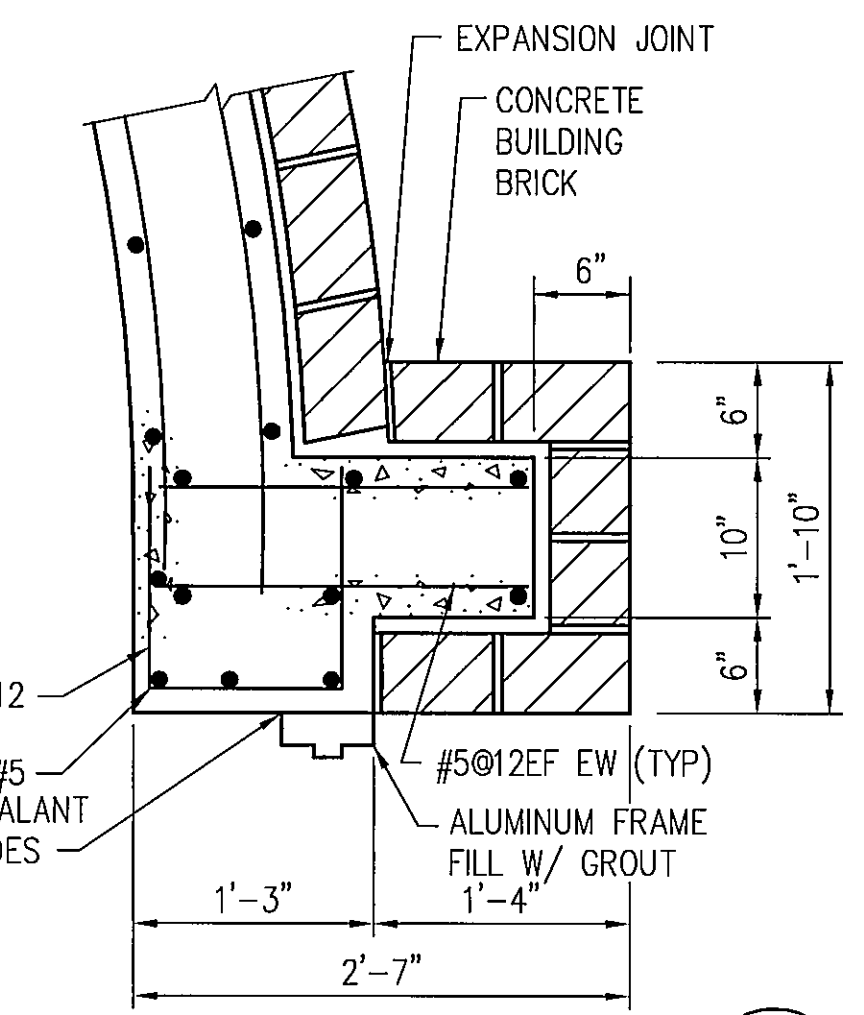


SECTION  
SCALE IN FEET  
1 2 3 4

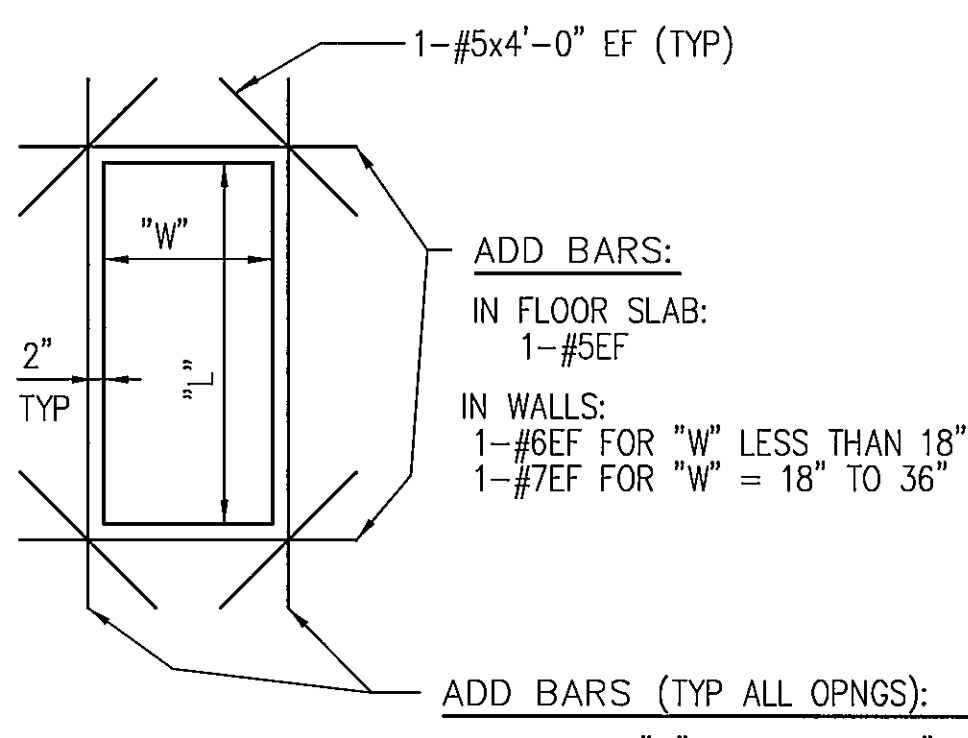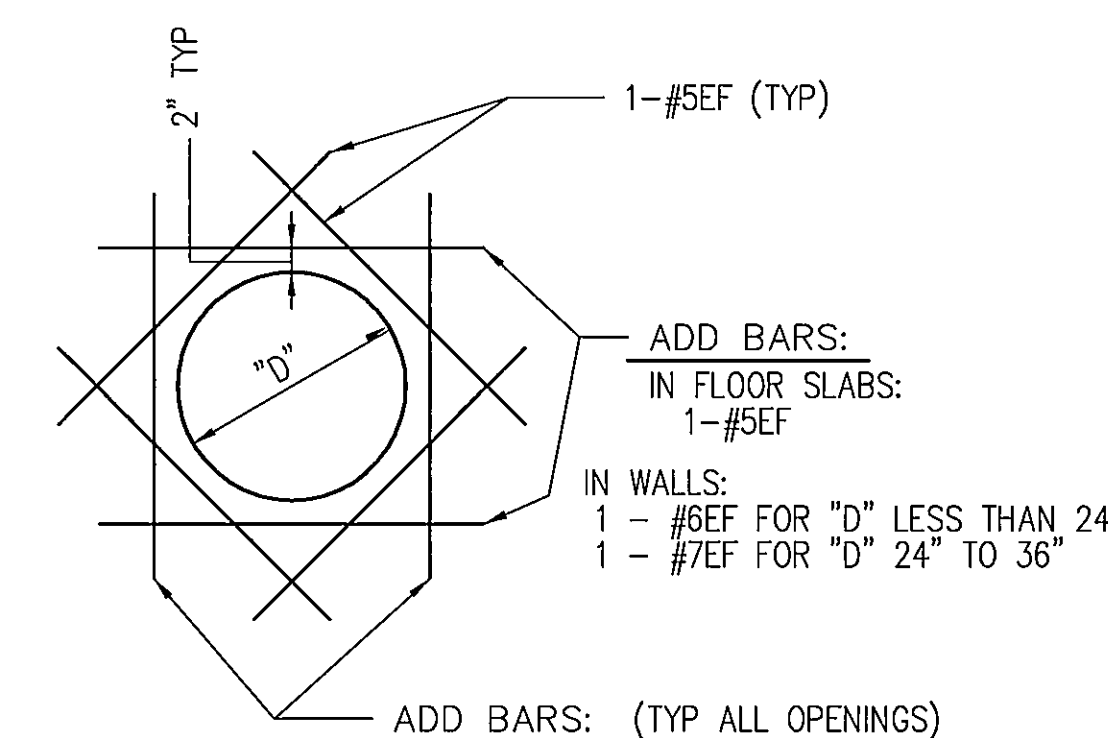


NOTES:  
1. ALL BAR MINIMUM LENGTHS TO BE ("D" + 3'-6") WITH BARS CENTERED ON OPENING.  
2. FOR OPENINGS LESS THAN 12" IN DIAMETER, THE ADD BARS ARE NOT REQUIRED IF NO REINFORCING IS CUT BY THE OPENING.  
3. SHORT SPAN OF SLAB = LESSER DISTANCE BETWEEN SUPPORT MEMBERS.  
4. REINFORCE OPENINGS WITH "D" LARGER THAN 36" AS INDICATED ON THE DRAWINGS. IF NOT INDICATED, CONTACT THE ENGINEER.


NOTES:  
1. ALL MINIMUM LENGTHS TO BE (L OR W + 3'-6") WITH BARS CENTERED ON OPENING.  
2. FOR OPENINGS (W/L) LESS THAN 12", THE ADD BARS ARE NOT REQUIRED IF NO REINFORCING IS CUT BY THE OPENING.  
3. SHORT SPAN OF SLAB = LESSER DISTANCE BETWEEN SUPPORT MEMBERS.  
4. REINFORCE OPENINGS WITH "L" OR "W" LARGER THAN 36" AS INDICATED ON THE DRAWINGS. IF NOT INDICATED, CONTACT THE ENGINEER.

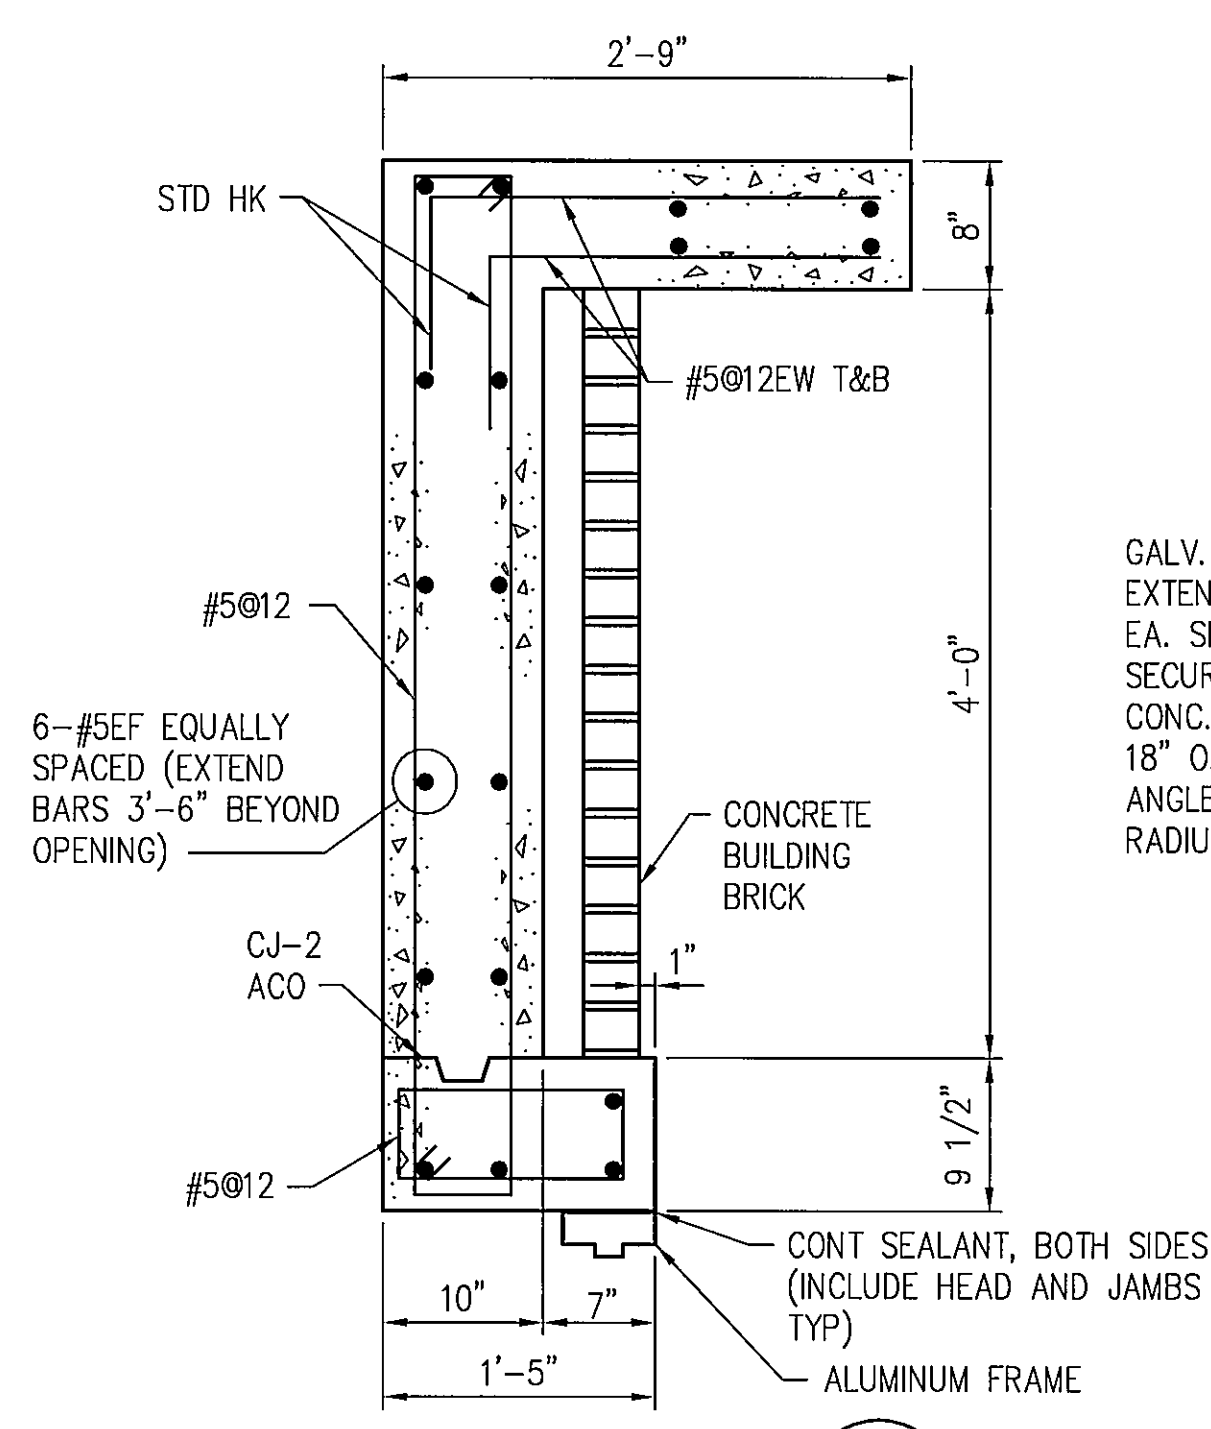

SECTION  
SCALE IN FEET  
1 2 3 4

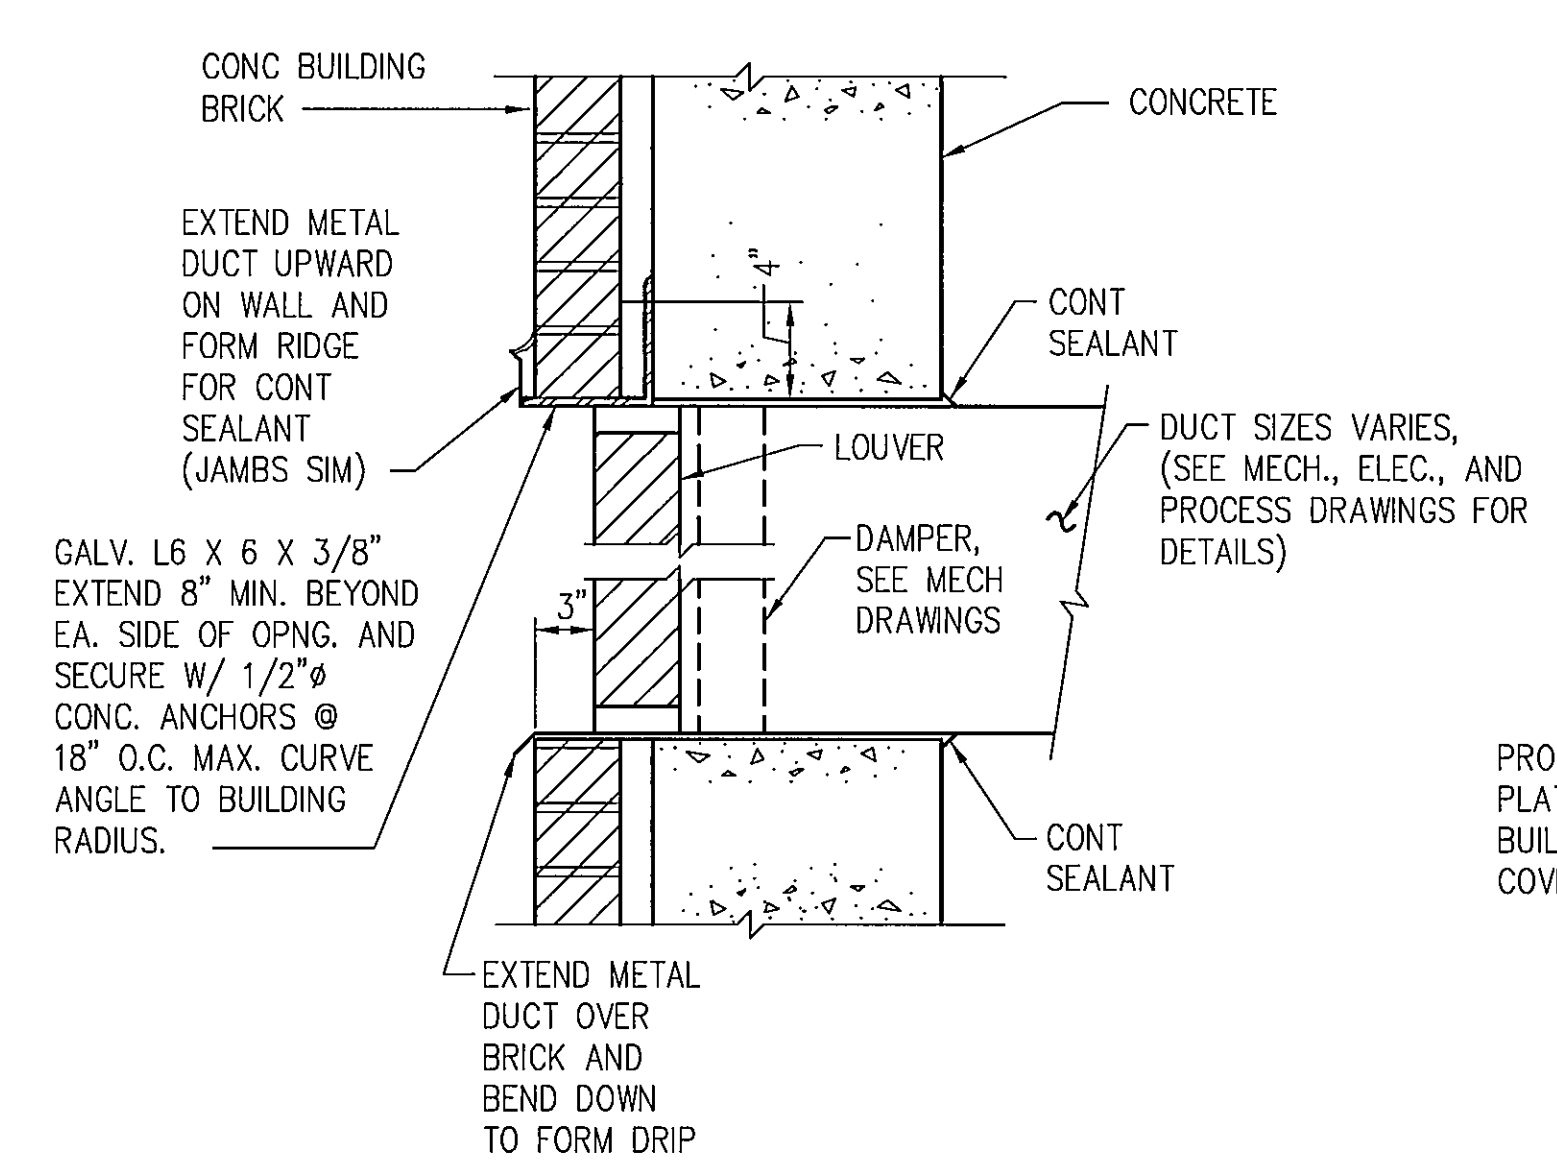

TYPICAL EXHAUST LOUVER DETAIL  
NOT TO SCALE

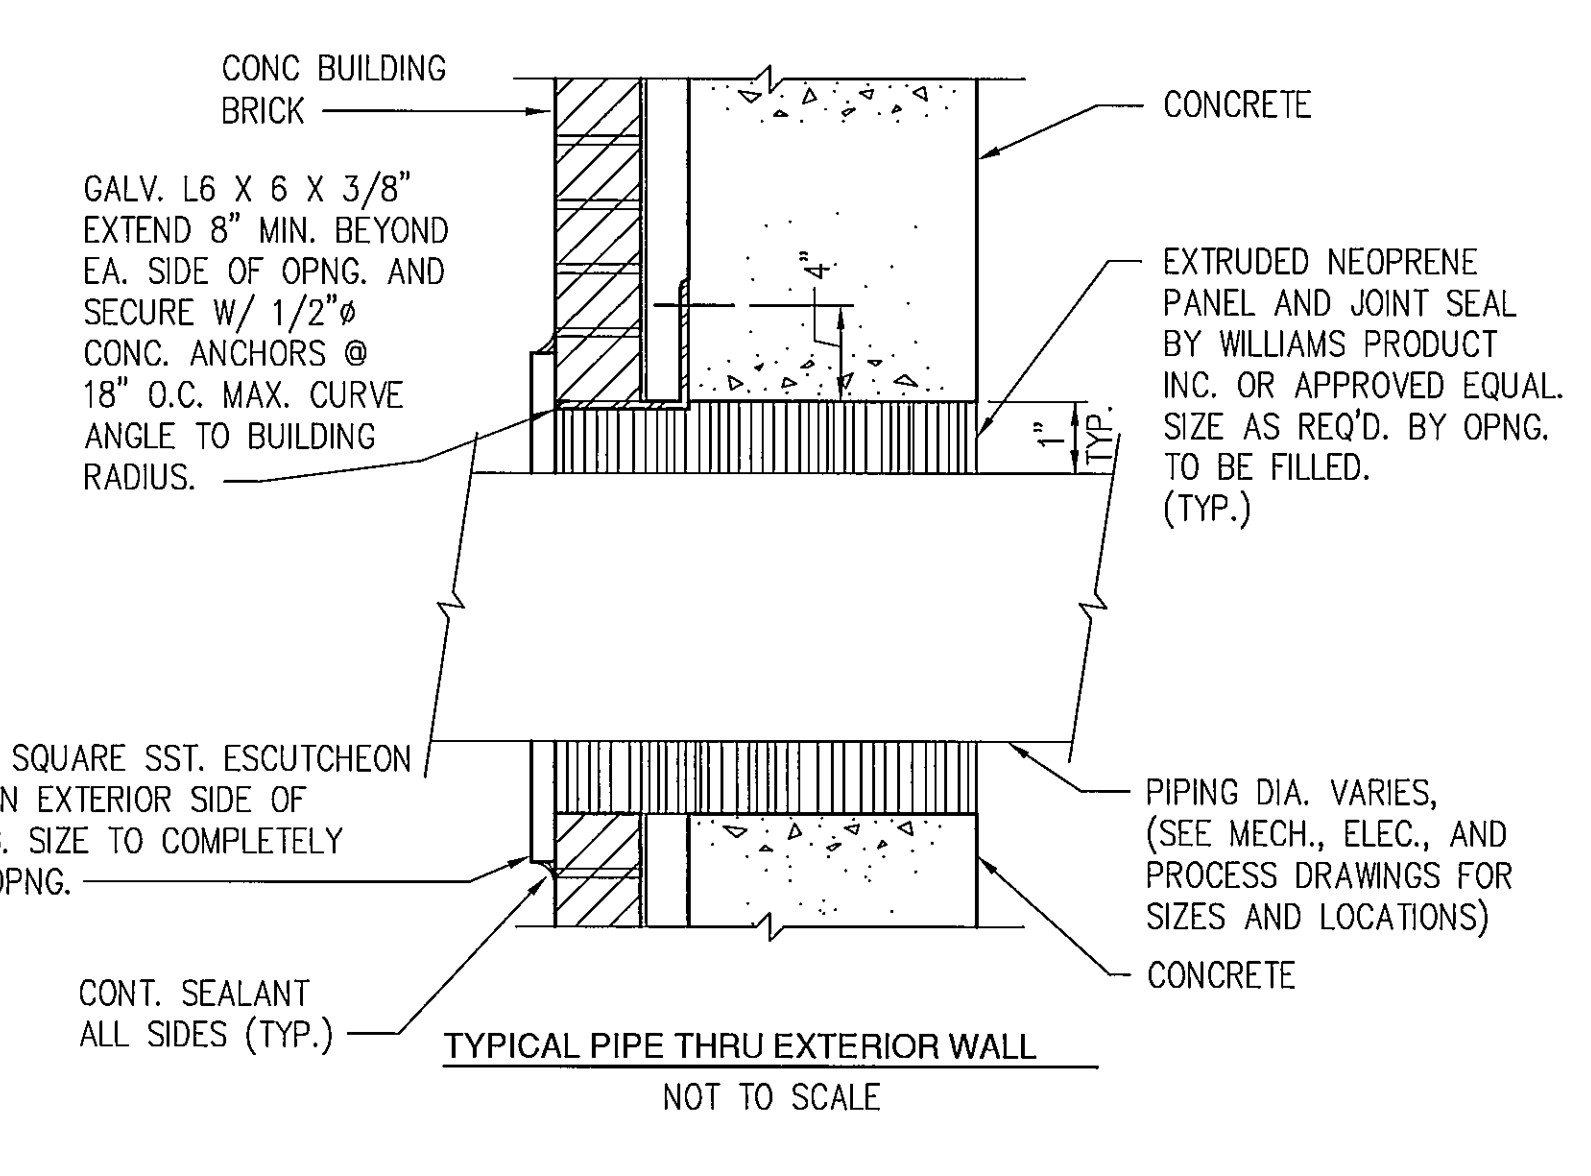

TYPICAL PIPE THRU EXTERIOR WALL  
NOT TO SCALE

UNSLEEVED OPENING  
CO-1

UNSLEEVED OPENING  
CO-2

no.	date	by	revision
Δ	8-15-01	JDF	REVISED CORNER DETAIL & LIFTING EYE DETAIL.
	8-15-01	JDF	AS-BUILT



date JAN. 6, 2000  
designed C. LEATON  
detailed J. ROUTON  
checked B.B.

"AS-BUILT"



LONDON BRIDGE BEACH PUMP HOUSE  
DETAILS AND SECTIONS  
project 97-777-1-002 contract W-183-00  
drawing S4 rev. 1  
sheet 8 of 21 sheets  
file Lbbphs04.dwg 03-23-2000 15:25 JLR



COPYRIGHT © 2000 BURNS AND MCDONNELL ENGINEERING COMPANY, INC.